

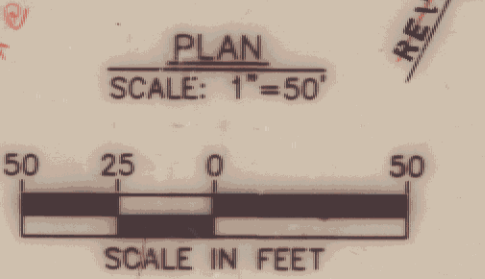


DATUM  
 VERTICAL NGVD 1929  
 HORIZONTAL N/A

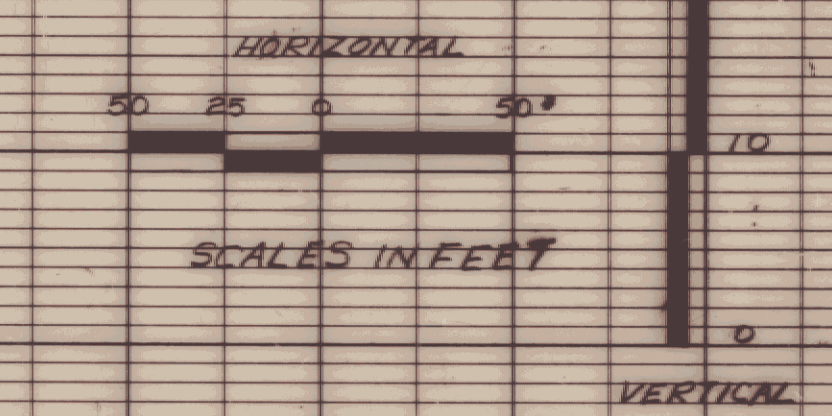

REV. CURVE 11  
 Δ 49° 3' 23" RT  
 D 4' 45"  
 R 1206.23'  
 L 1032.77'  
 T 550.43'  
 E 119.65'  
 B 0.069 FT/FT

CONSTRUCT DRIVE  
 LT RT  
 471+00 GRAVEL (12') 467+25 GRAVEL (16')  
 478+50 GRAVEL (12') 474+00 PAVED (12')  
 474+50 GRAVEL (12') 480+00 GRAVEL (12')  
 467+25 GRAVEL (12')

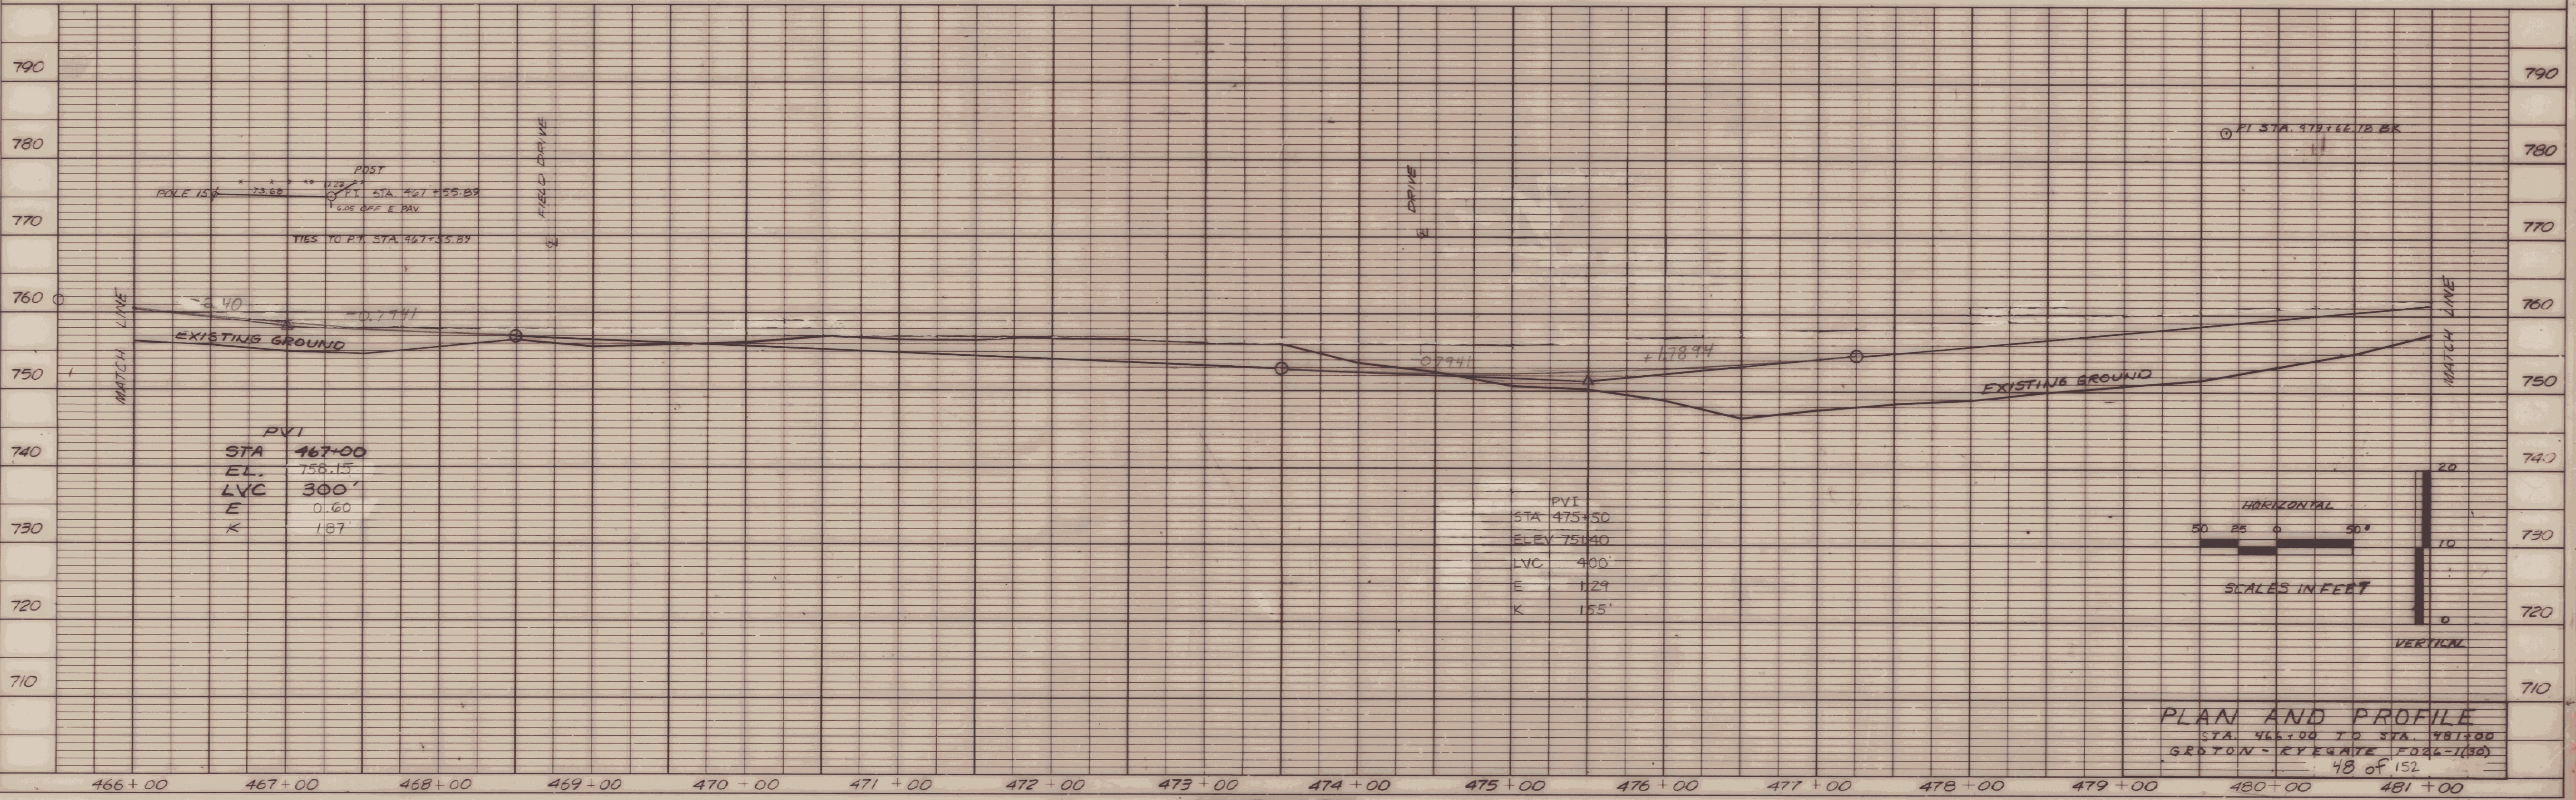

PLAN AND PROFILE  
 STA. 466+00 TO STA. 481+00  
 GROTON - RYEGATE ROAD (130)  
 48 OF 152