

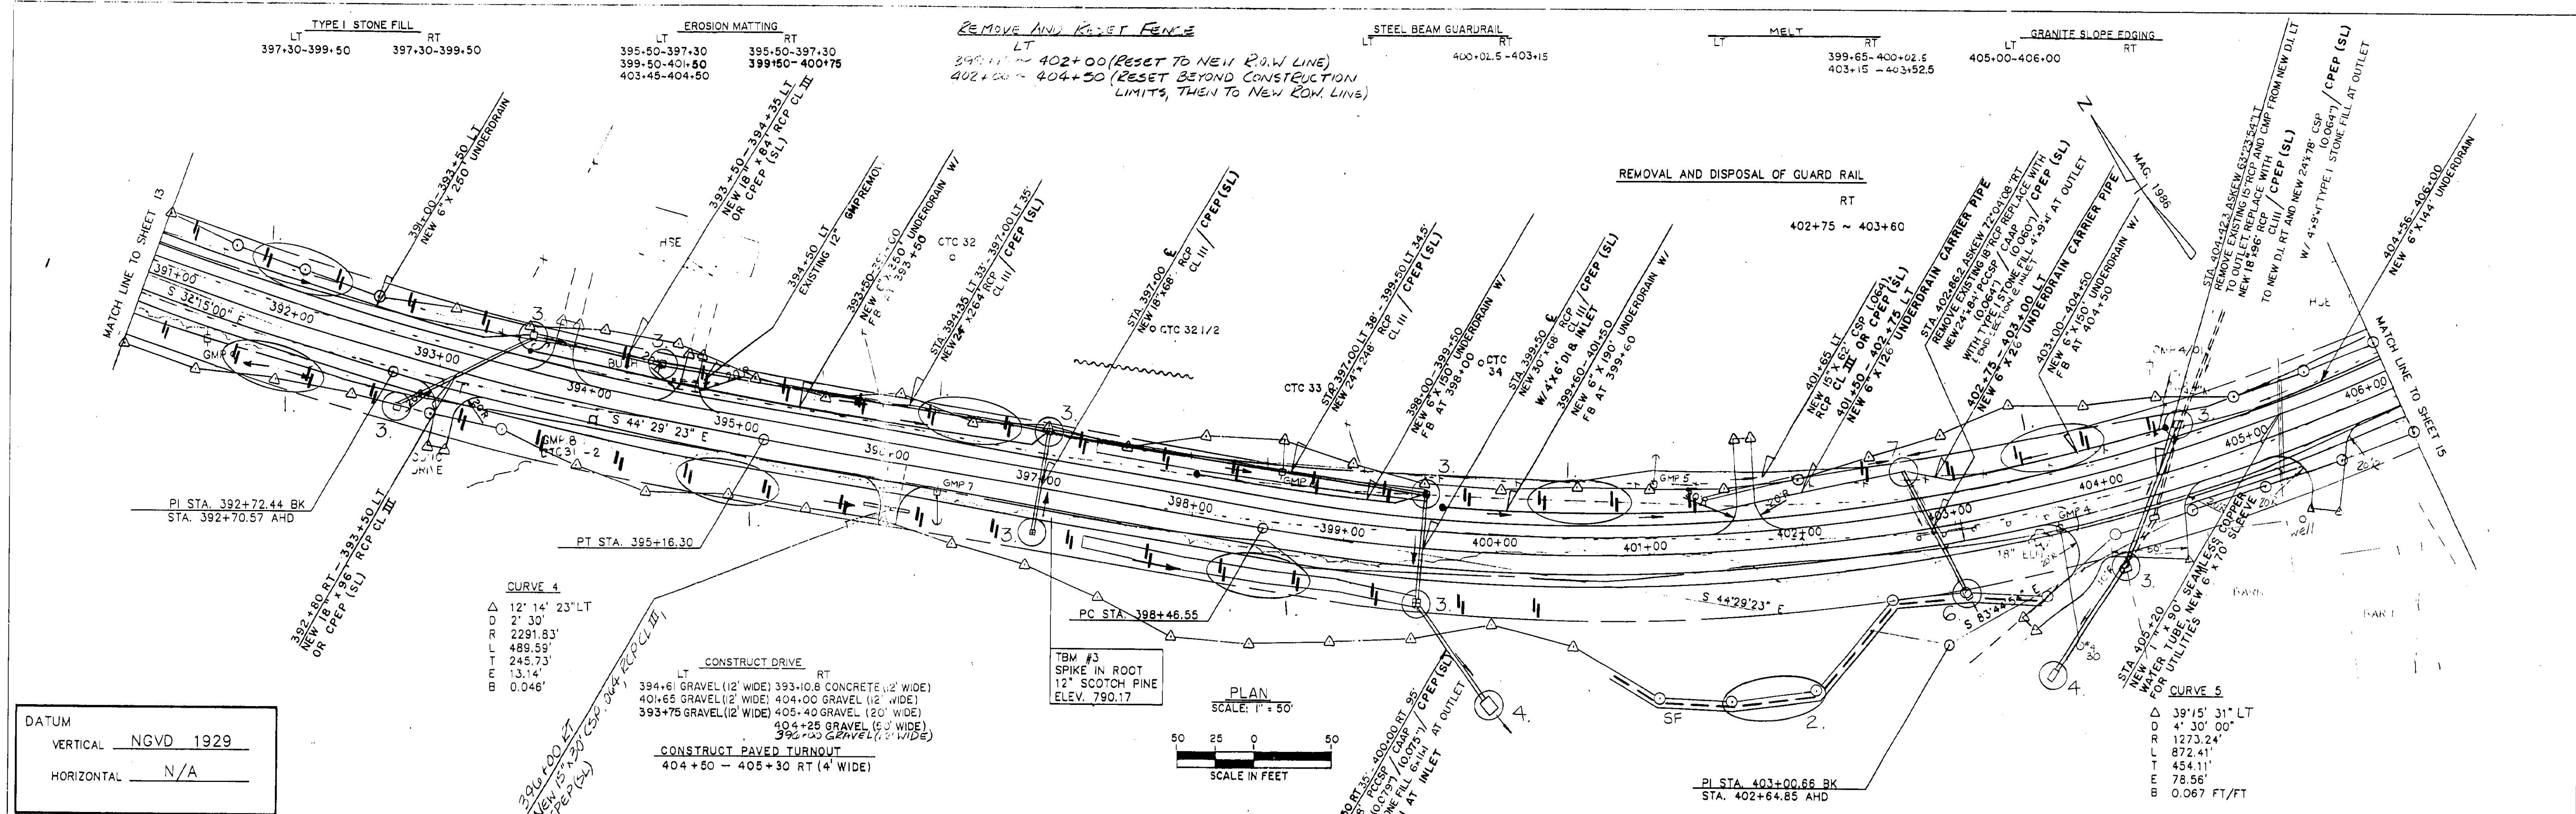


DATE	BY
OCT 82	DES. J.A.R. CLR
DEC 82	CHK. J.A.R.
SURVEYED	
ALIGNED CHECKED	
RT. OF WAY CHECKED	
PLAN	NOTE BOOK NO.

DATE	BY
FEB 83	DES. J.A.R.
FEB 83	CHK. J.A.R.
SURVEYED	
GRADES CHECKED	
STRUCTURE NOTATIONS OK'D	
PROFILE	NOTE BOOK NO.

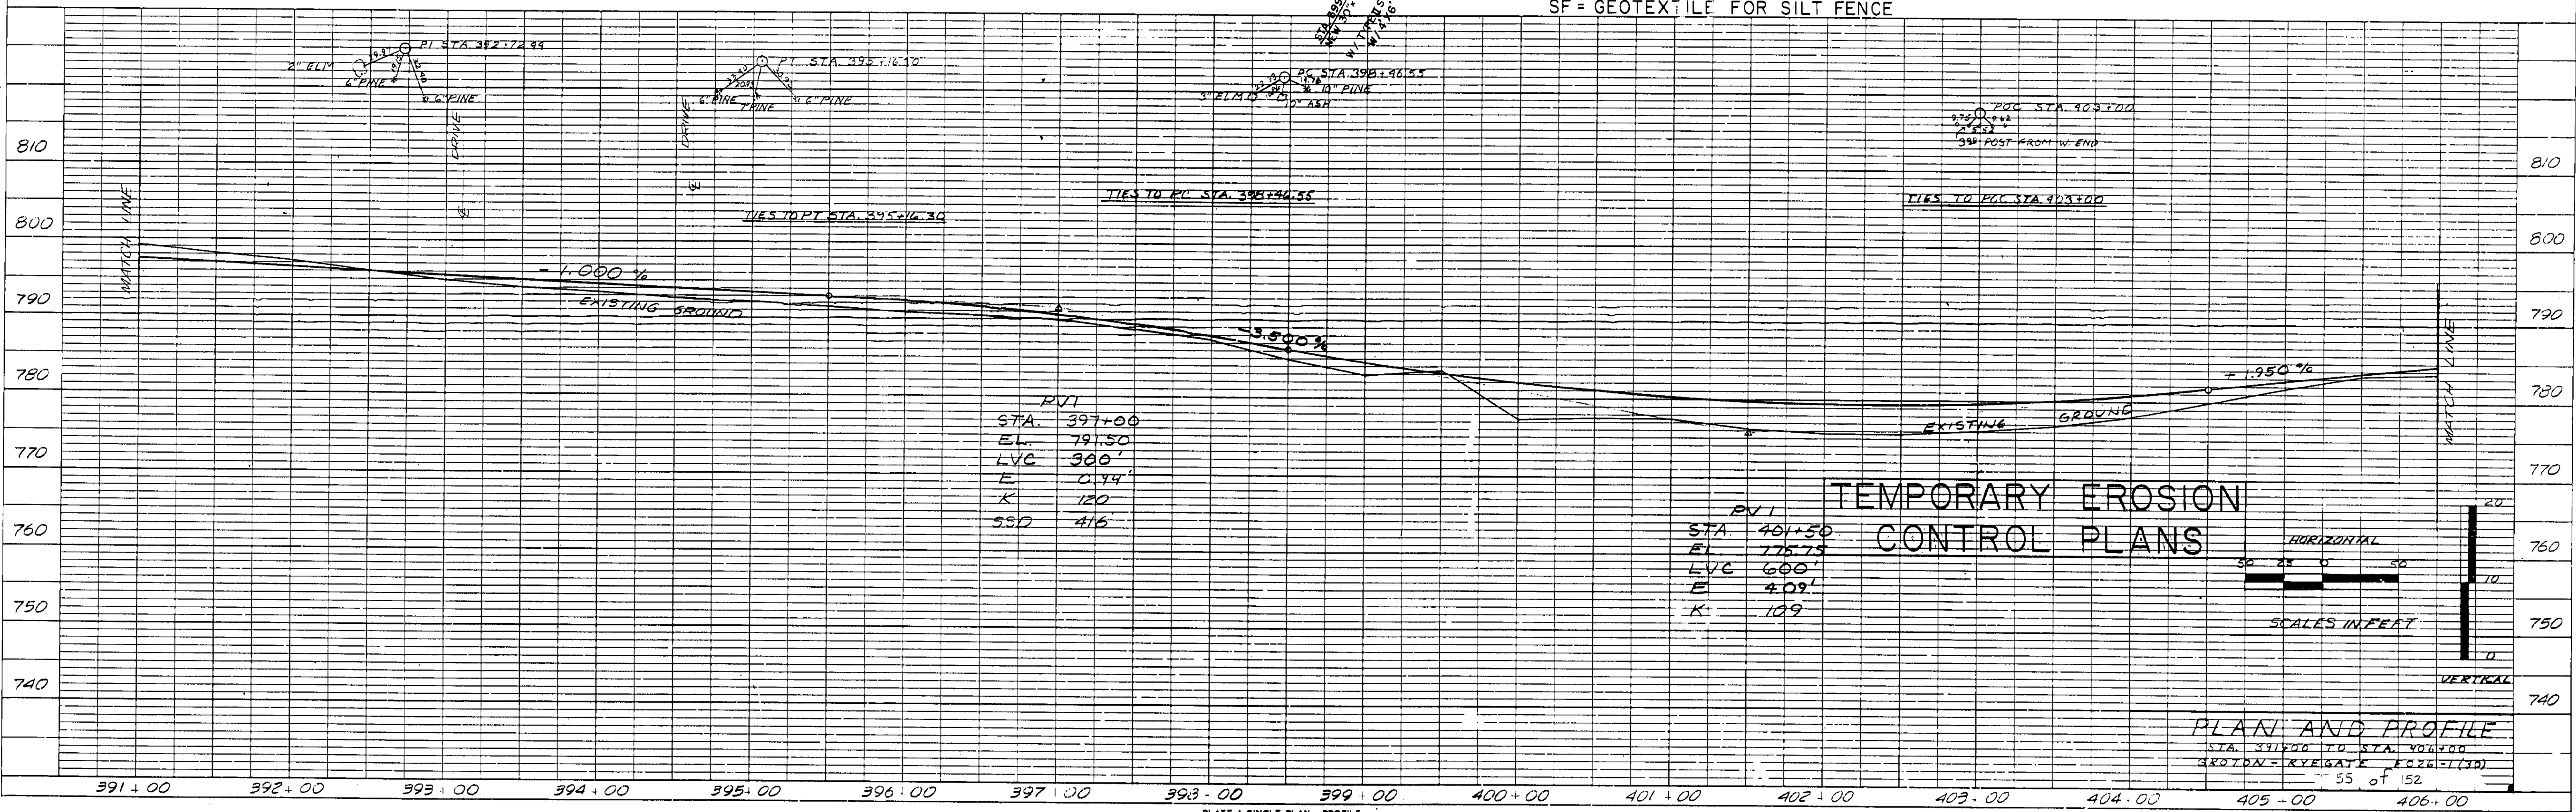

DATUM
 VERTICAL NGVD 1929
 HORIZONTAL N/A

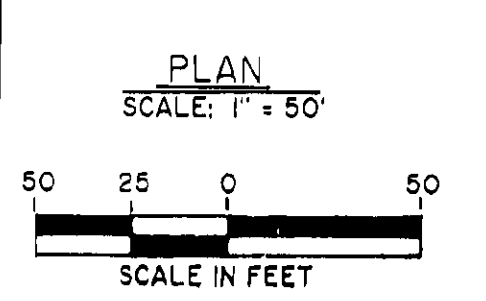

DRAWING 44-131-50228