


TYPE I STONE FILL	LT	RT	EROSION MATTING	LT	RT	CONSTRUCT DRIVE	LT	RT	CONSTRUCT SIDE ROAD	LT	RT	STEEL BEAM GUARDRAIL	LT	RT
416.25-417.00		415.50-418.00	406.50-409.25		411.75-416.25	406.25 ASPHALT (24)	410.98 GRAVEL (12)	419.50 GRAVEL (20)	417.30.23			418+13.5 - 418+63.5	417+33.5 - 418+40	
		7H 5-O-130-O+9(1)				410.98 GRAVEL (12)	7H 5-O-60(12)	419.60 GRAVEL (12)						
TYPE II STONE FILL	LT	RT										MELT	LT	RT
418.20		418.00										417+76-418+13.5	416+96-417+33.5	
												418+63.5-419+01	418+40-418+83.5	

PLAN	DATE	BY
	10/15/11	CSL
SURVEYED	DATE	BY
	10/15/11	CSL
CHECKED	DATE	BY
	10/15/11	CSL
NOTED	DATE	BY
	10/15/11	CSL
STRUCTURE NOTATIONS CHD	DATE	BY
	10/15/11	CSL

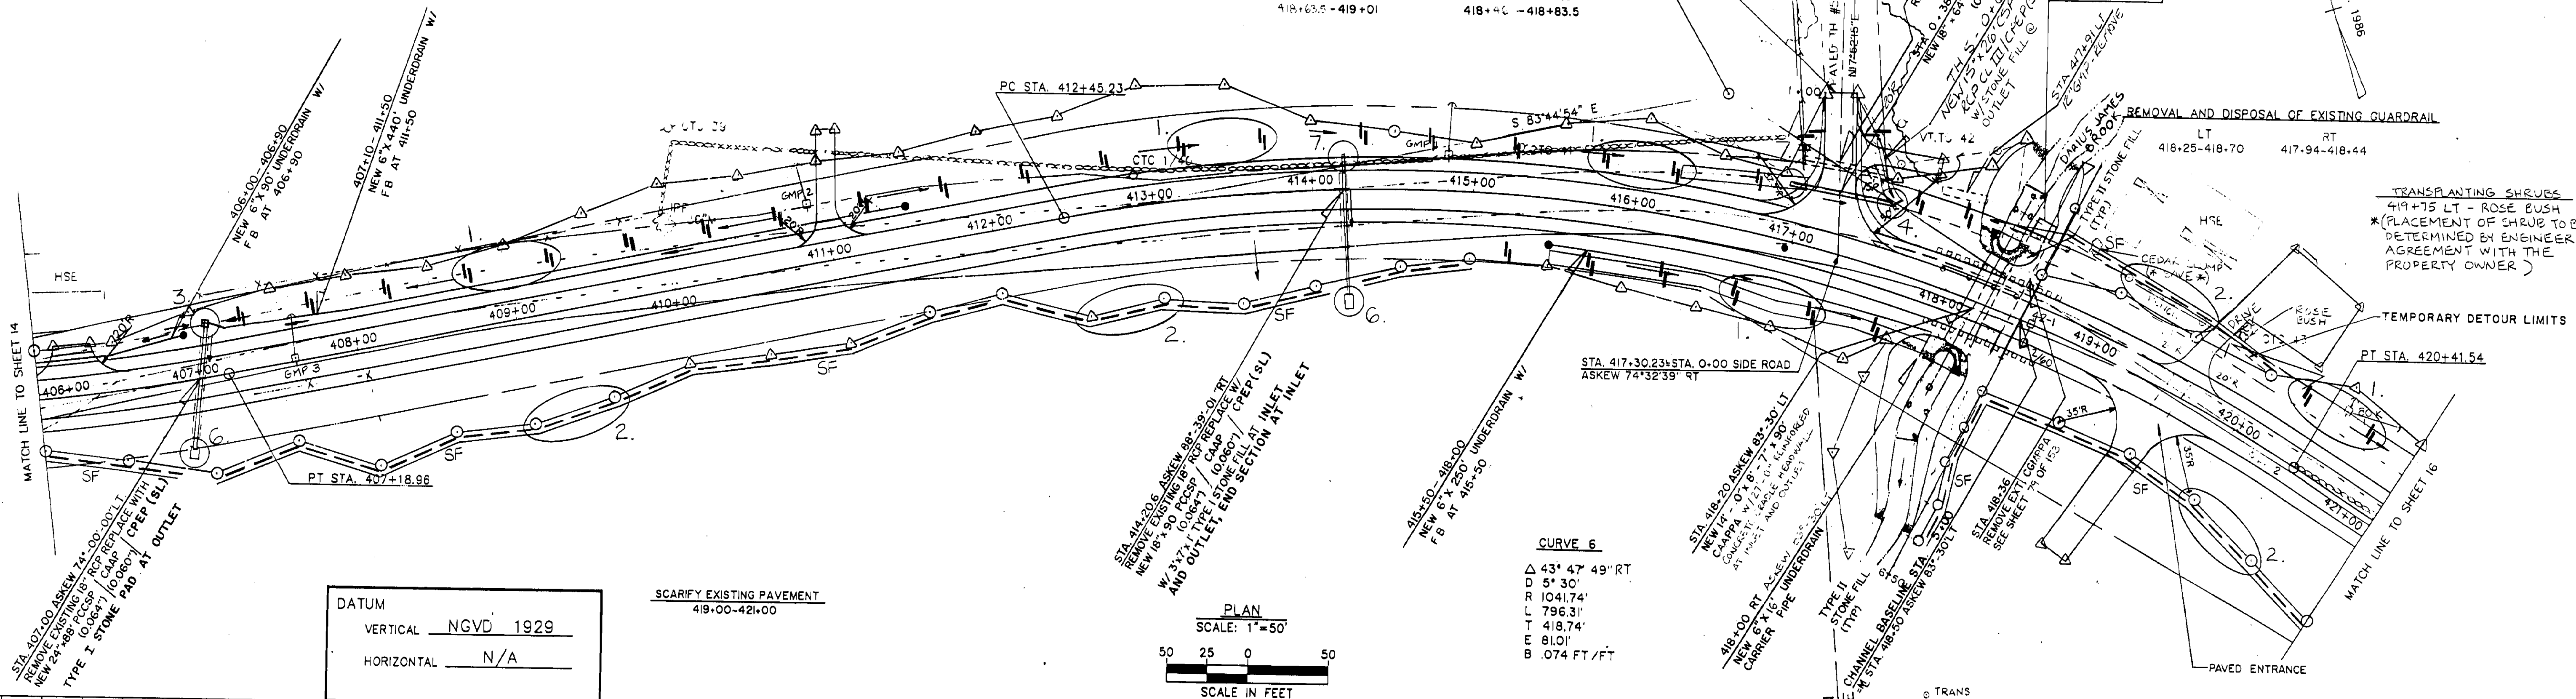

PROFILE	DATE	BY
	10/15/11	CSL
SURVEYED	DATE	BY
	10/15/11	CSL
CHECKED	DATE	BY
	10/15/11	CSL
NOTED	DATE	BY
	10/15/11	CSL
STRUCTURE NOTATIONS CHD	DATE	BY
	10/15/11	CSL

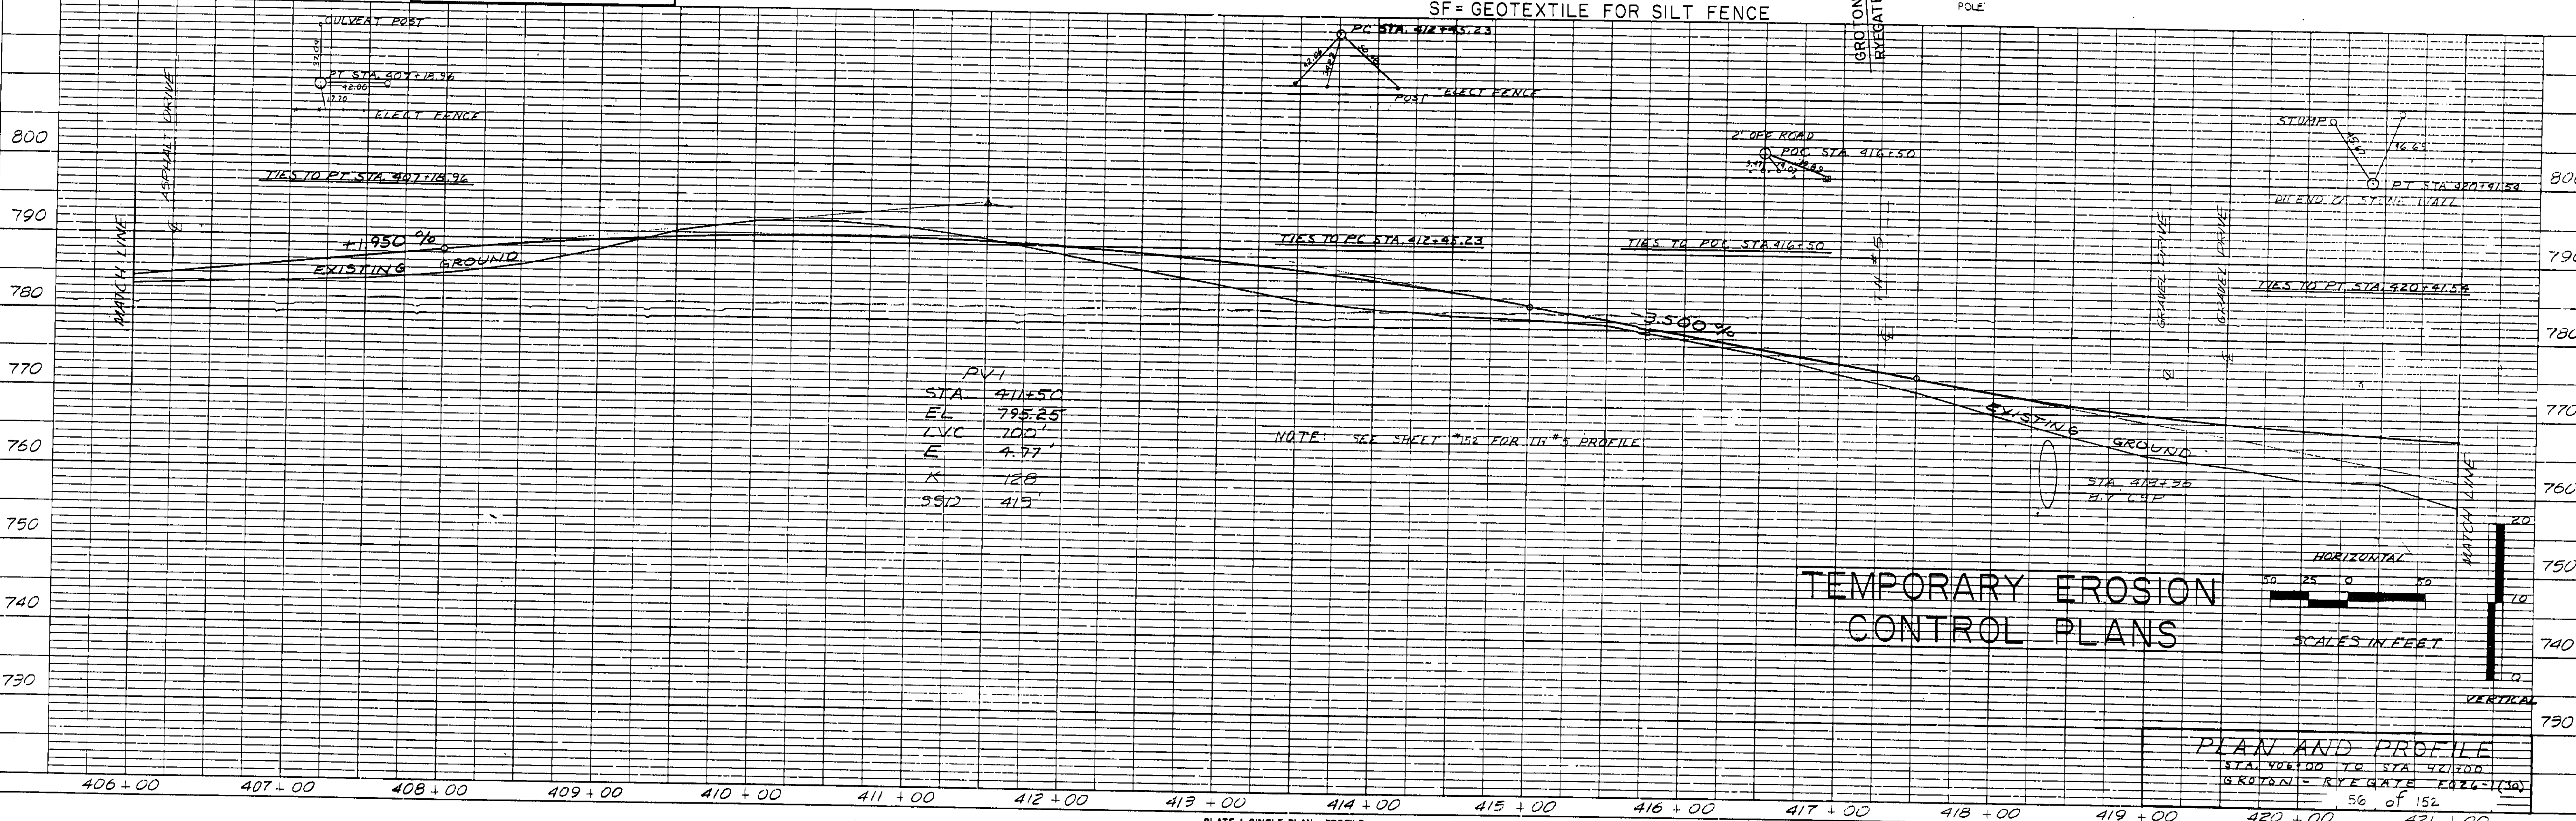


PLATE 1 SINGLE PLAN - PROFILE
CHARLES BRUNING CO.

PLAN AND PROFILE
STA 406+00 TO STA 421+00
GROTON - RYE GATE RD 26-1(10)
56 of 152