


PLAN	DATE	BY
	DESIGNED	BY
	CHECKED	BY
	ALIGNED	BY
	RT. OF WAY	BY
	CHECKED	BY
	NO.	


PROFILE	DATE	BY
	DESIGNED	BY
	CHECKED	BY
	GRADES	BY
	STRUCTURE	BY
	NOTATIONS	BY
	NO.	

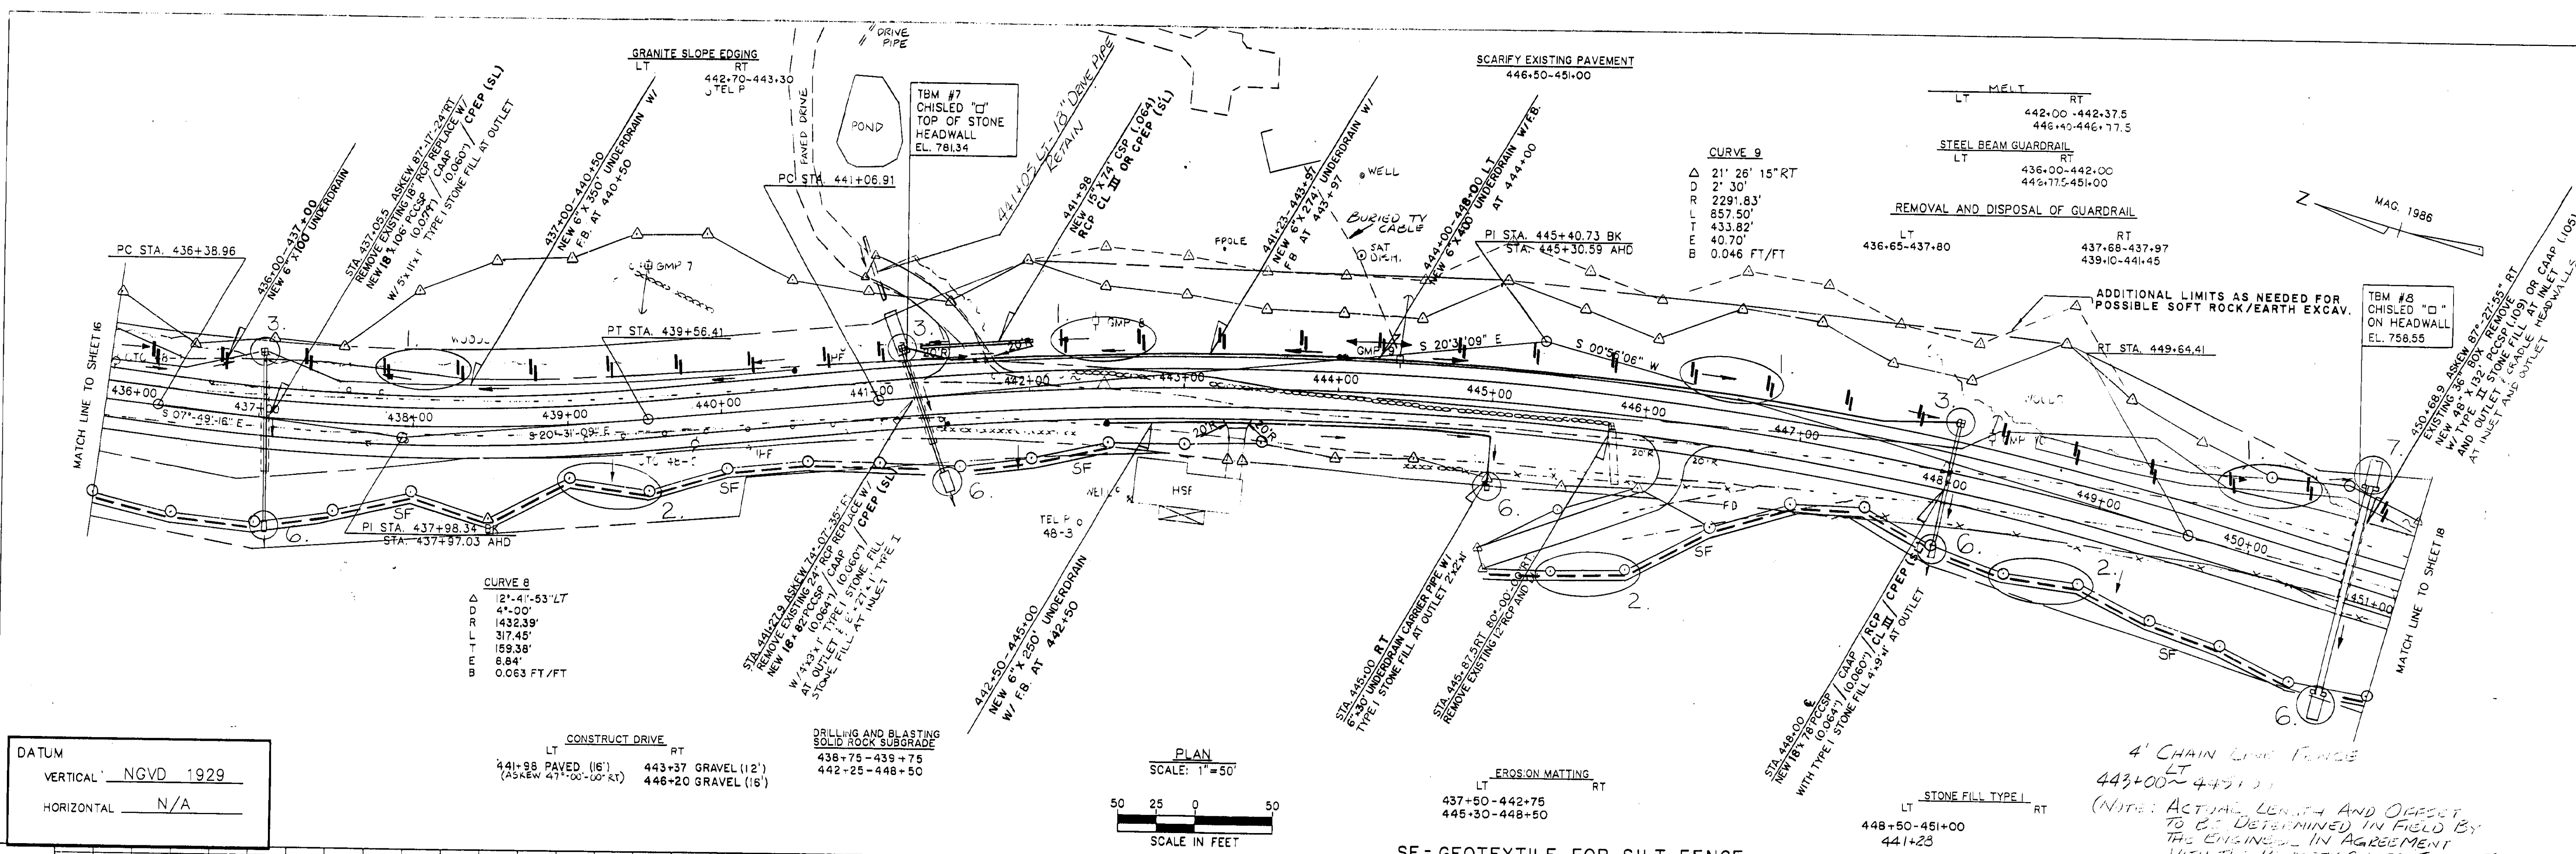

DATUM  
 VERTICAL NGVD 1929  
 HORIZONTAL N/A

**CURVE 8**  
 Δ 21° 41' 53" LT  
 D 41+00'  
 R 1432.39'  
 L 317.45'  
 T 159.38'  
 E 5.84'  
 B 0.063 FT/FT


**CURVE 9**  
 Δ 21° 26' 15" RT  
 D 2' 30"  
 R 2291.83'  
 L 857.50'  
 T 433.82'  
 E 40.70'  
 B 0.046 FT/FT

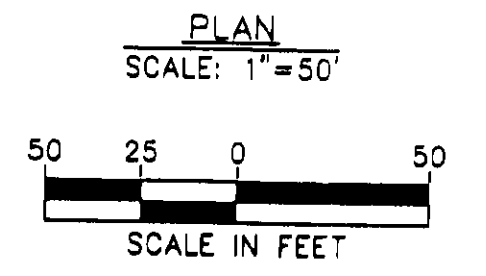

**EROSION MATTING**  
 LT 437+50-442+75  
 RT 445+30-448+50


**STONE FILL TYPE I**  
 LT 448+50-451+00  
 RT 441+23

4' CHAIN LINK FENCE  
 LT 443+00-445+00  
 (NOTE: ACTUAL LENGTH AND OFFSET TO BE DETERMINED IN FIELD BY THE ENGINEER IN AGREEMENT WITH THE PROPERTY OWNER. FENCE TO BE ERECTED OUTSIDE R.O.W. LINE)

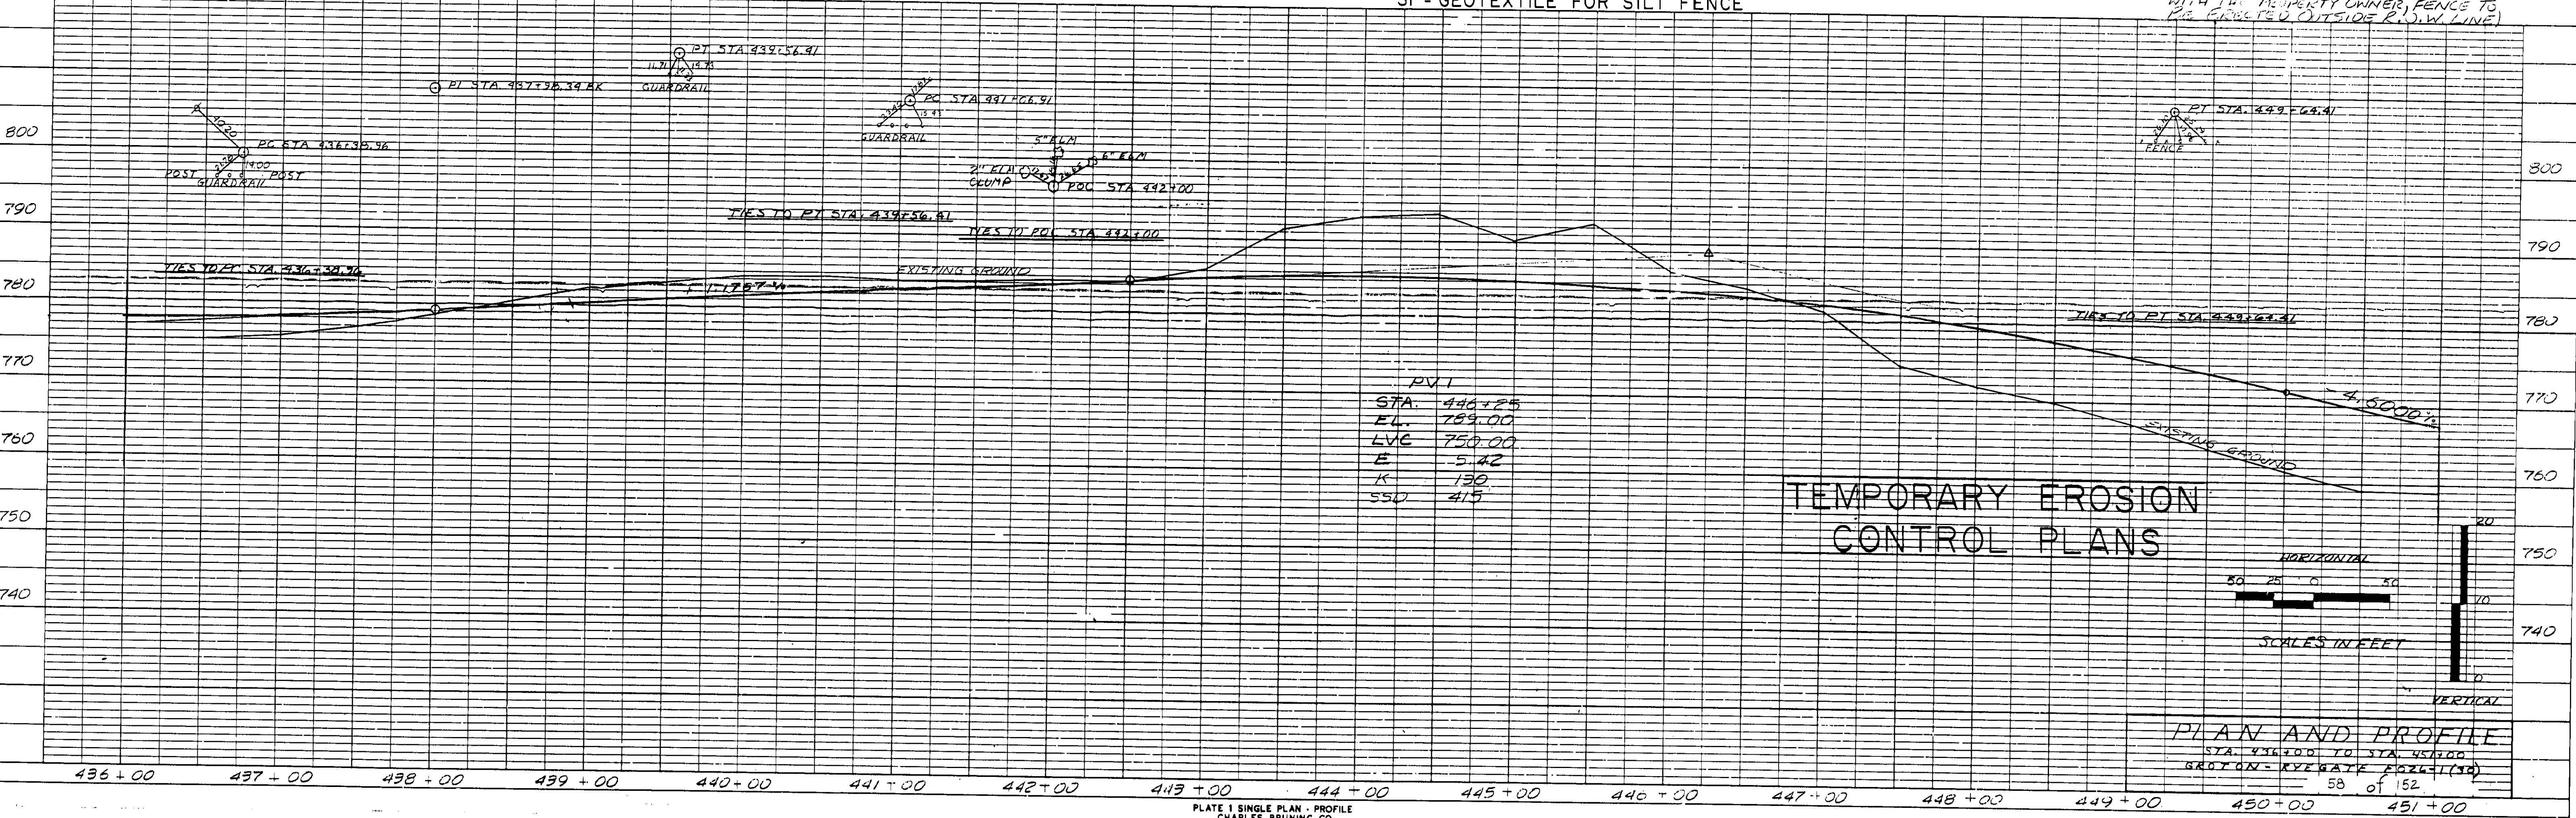

**PVI**  
 STA. 444+25  
 EL. 759.00  
 LVC 750.00  
 E -5.42  
 K 130  
 SSD 415

TEMPORARY EROSION CONTROL PLANS

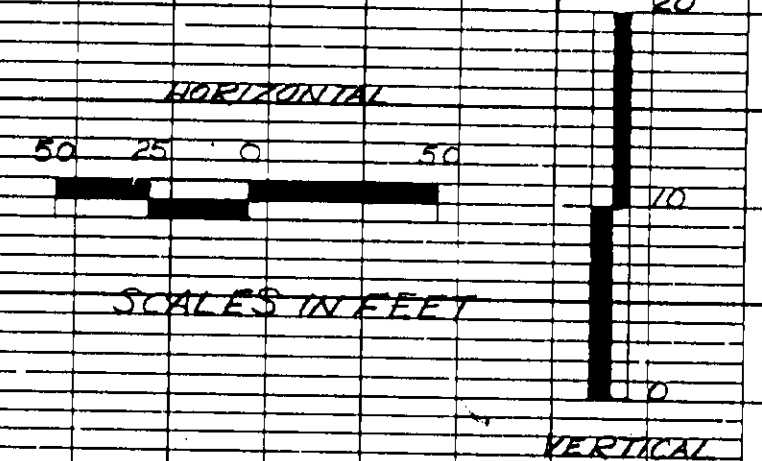

PLAN AND PROFILE  
 STA. 436+00 TO STA. 451+00  
 GROUND - RYZGATE ROAD (100)  
 58 OF 152