


PLAN	DATE	DEC. 84
	BY	D.S.C. W.A.S., G.L.B.
SURVEYED	PLANNED	NOT CHECKED
	NOTED	RT. OF WAY CHECKED
NO.	NO.	

PROFILE	DATE	DEC. 84
	BY	S.C. D.S.C.
SURVEYED	PLANNED	NOT CHECKED
	NOTED	STRUCTURE NOTING OK'D
NO.	NO.	



DATUM
 VERTICAL NGVD 1929
 HORIZONTAL N/A

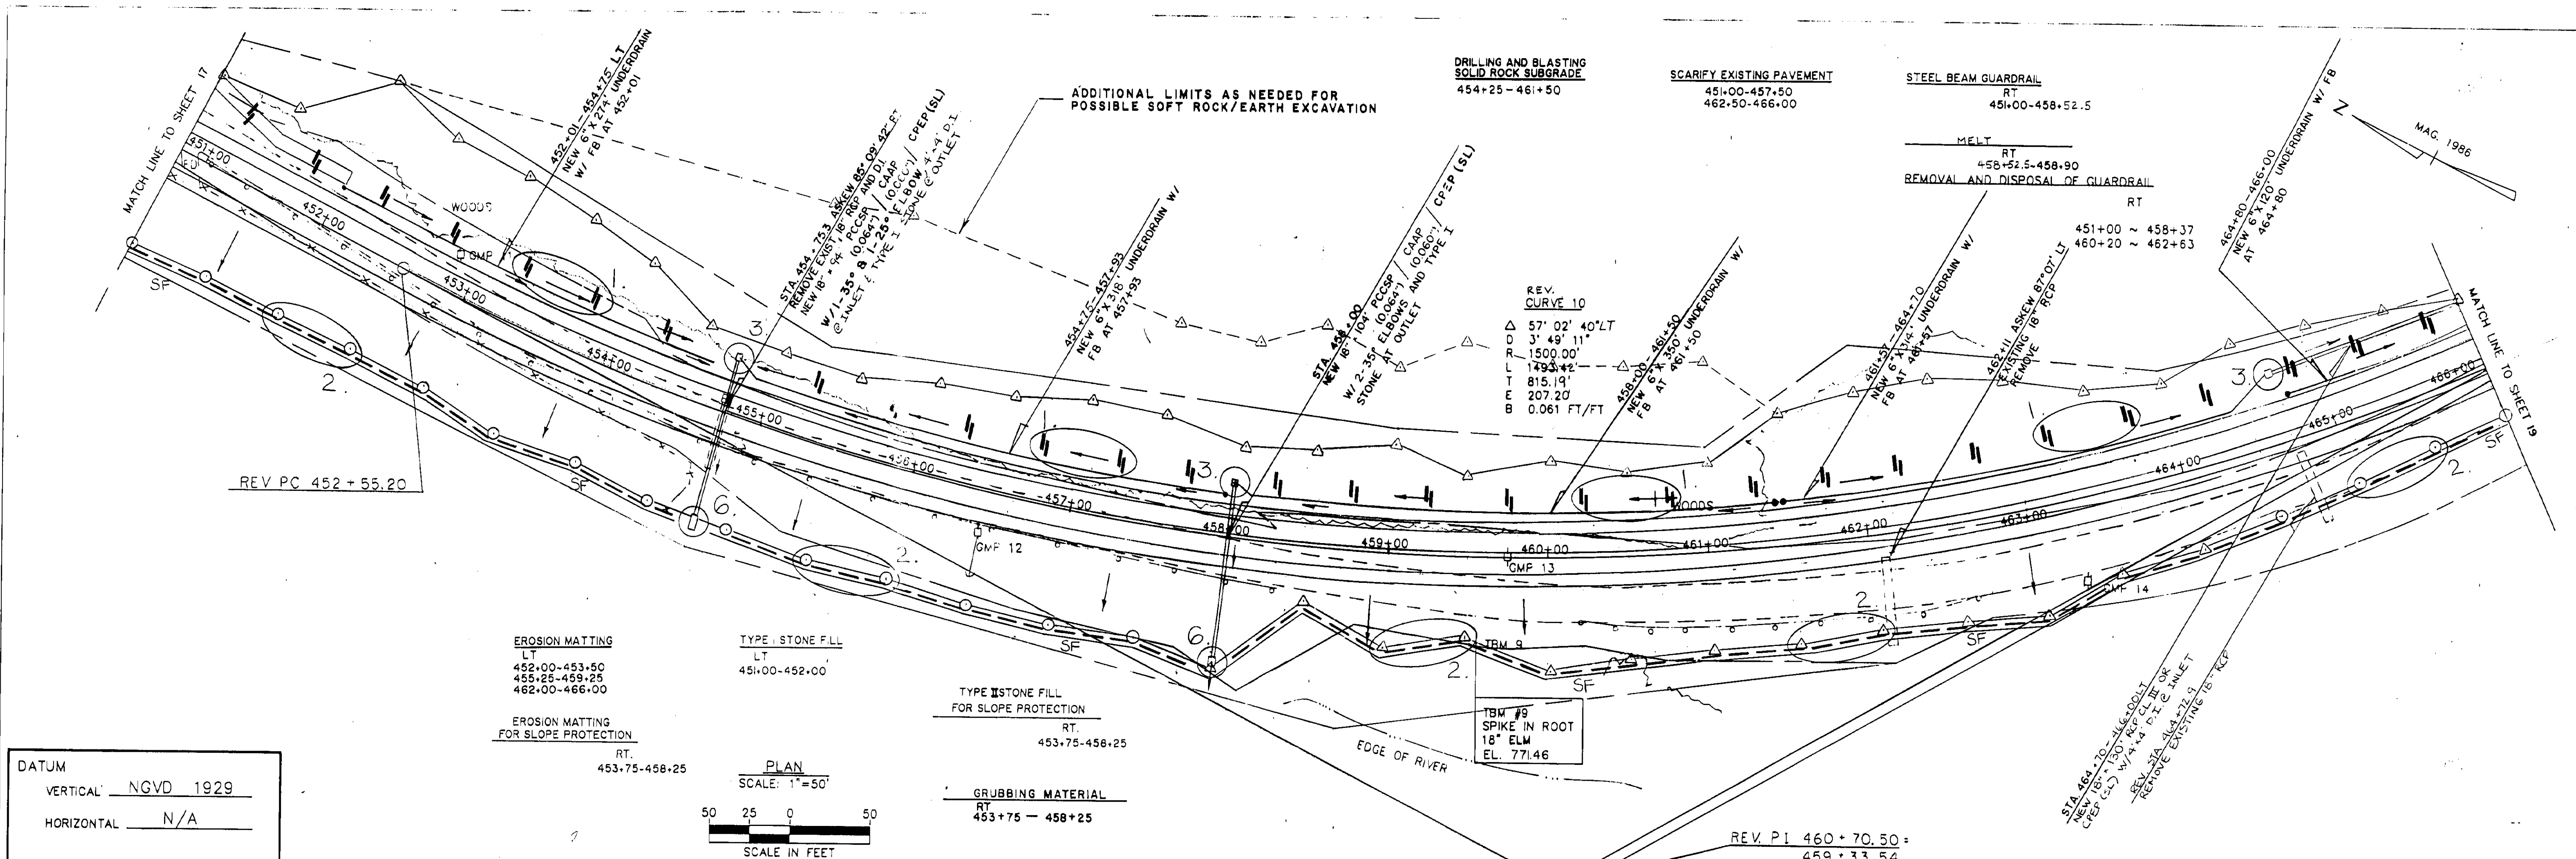