


DATE
BY
SURVEYED
PLOTTED
ALIGNMENT CHECKED
RT. OF WRT CHECKED
NOTE BOOK
NO.

PLAN

DATUM
VERTICAL NGVD 1929
HORIZONTAL N/A

DATE
BY
DESIGNED
CHECKED
PLOTTED
GRADES CHECKED
STRUCTURE NOTATIONS OK'D
NOTE BOOK
NO.

PROFILE

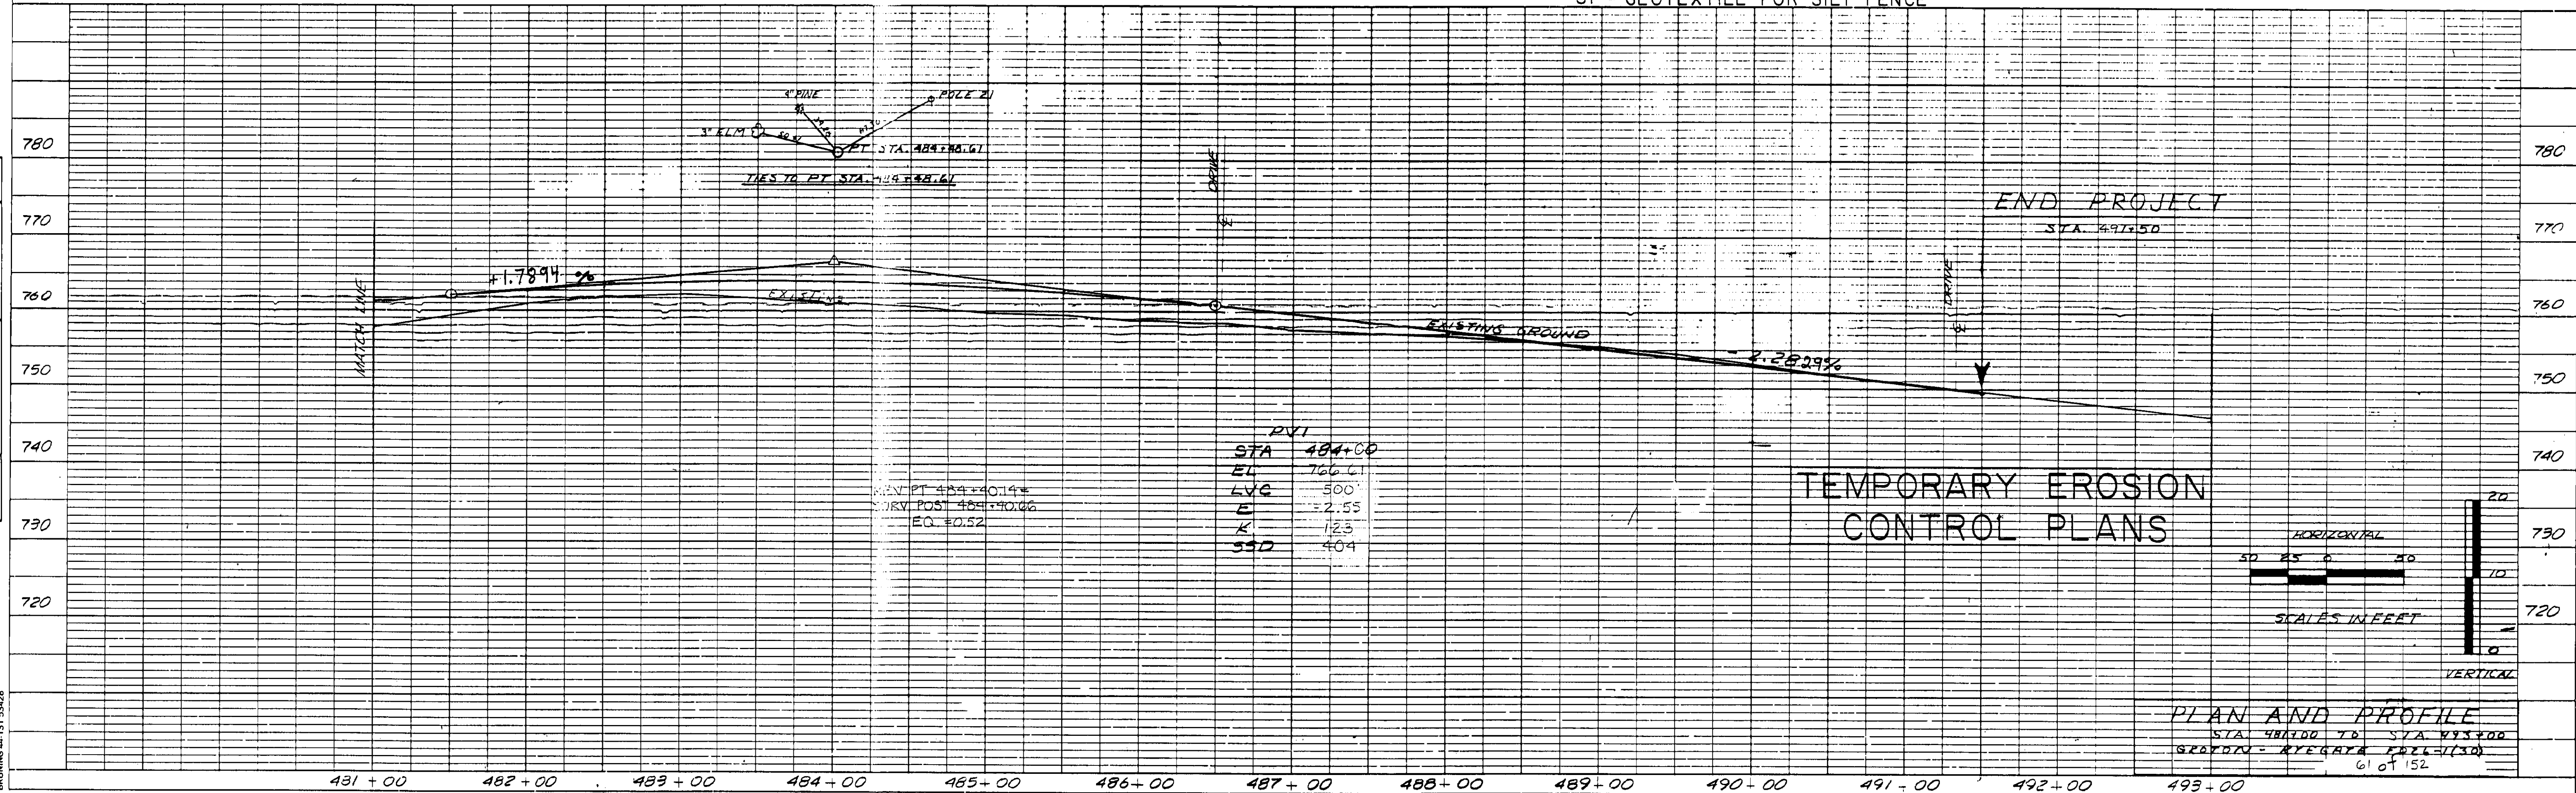

EROSION MATTING	
LT	RT
481+50-486+30	481+00-481+50
489+50-490+85	483+75-485+25

SCARIFY EXISTING PAVEMENT	
LT	RT
484+50	481+00

CONSTRUCT DRIVE	
LT	RT
486+50 GRAVEL (12')	
491+32 GRAVEL (12')	

CONSTRUCT TURNOUT	
LT	RT
487+00-489+50 RT	
W/12" AGGREGATE SURFACE COURSE	

PLANK RAIL	
LT	RT
487+50	489+00

STEEL BEAM GUARDRAIL	
LT	RT
482+65	486+52.5

MELT	
LT	RT
482+75-482+65	
486+52.5-486+30	
489+50-489+67.5	

REMOVE & RESET GUARDRAIL	
LT	RT
489+67.5	491+50

REMOVAL & DISPOSAL OF GUARDRAIL	
LT	RT
486+85 - 487+75	
	483+20 - 484+95
	489+50 - 489+67.5

PVI	
STA	484+00
EL	766.61
LVC	500'
E	-2.55
K	123
SSD	404

REV PT 484+40.14*
SURV POST 484+40.06
EQ = 0.52

PLAN AND PROFILE
STA 481+00 TO STA 493+00
BRUNING - RYEGATE FIELD (130)
61 of 152