


PLAN
SCALE: 1"=50'

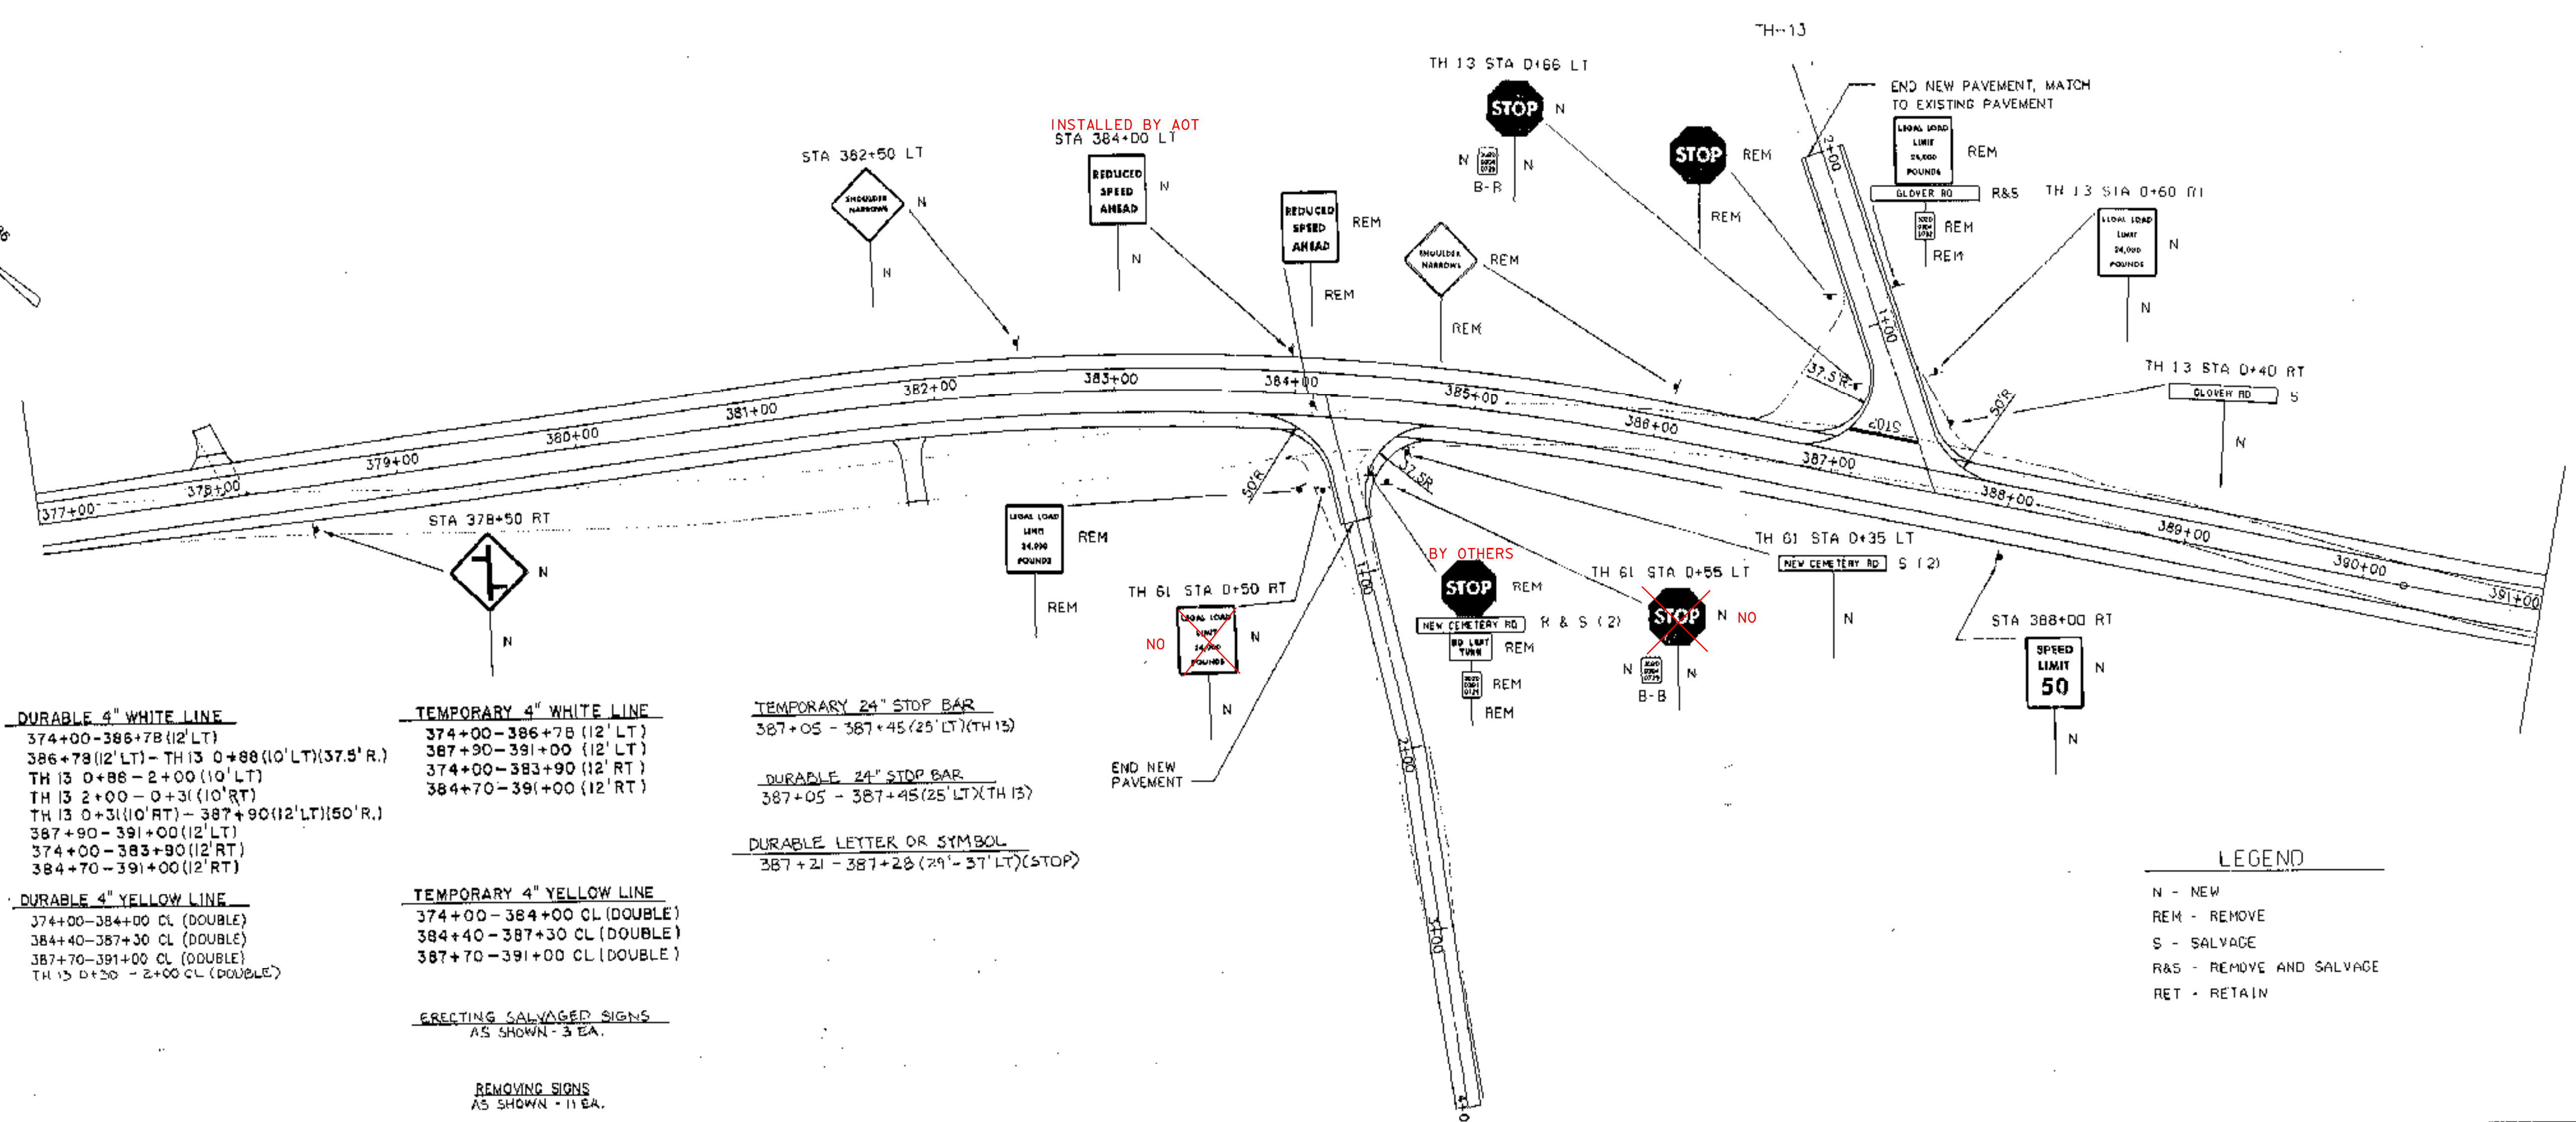

- DURABLE 4" WHITE LINE
- 374+00-386+78 (12' LT)
- 386+78 (12' LT) - TH 13 0+88 (10' LT) (37.9' R.)
- TH 13 0+88 - 2+00 (10' LT)
- TH 13 2+00 - 0+3 (10' RT)
- TH 13 0+3 (10' RT) - 387+90 (12' LT) (50' R.)
- 387+90 - 391+00 (12' LT)
- 374+00 - 383+90 (12' RT)
- 384+70 - 391+00 (12' RT)

- TEMPORARY 4" WHITE LINE
- 374+00 - 386+78 (12' LT)
- 387+90 - 391+00 (12' LT)
- 374+00 - 383+90 (12' RT)
- 384+70 - 391+00 (12' RT)

- TEMPORARY 24" STOP BAR
- 387+05 - 387+45 (25' LT) (TH 13)
- DURABLE 24" STOP BAR
- 387+05 - 387+45 (25' LT) (TH 13)
- DURABLE LETTER OR SYMBOL
- 387+21 - 387+28 (79' - 37' LT) (STOP)

- DURABLE 4" YELLOW LINE
- 374+00-384+00 CL (DOUBLE)
- 384+40-387+30 CL (DOUBLE)
- 387+70-391+00 CL (DOUBLE)
- TH 13 0+30 - 2+00 CL (DOUBLE)

- TEMPORARY 4" YELLOW LINE
- 374+00 - 384+00 CL (DOUBLE)
- 384+40 - 387+30 CL (DOUBLE)
- 387+70 - 391+00 CL (DOUBLE)

ERECTING SALVAGED SIGNS
AS SHOWN - 3 EA.

REMOVING SIGNS
AS SHOWN - 11 EA.

LEGEND

N	- NEW
REM	- REMOVE
S	- SALVAGE
R&S	- REMOVE AND SALVAGE
RET	- RETAIN

PLAN
SCALE: 1"=50'

TRAFFIC SHEETS

PROJECT NAME: CROTON/RYGATE
NO.: F026-1(30)
SHEET 62 OF 152 SHEETS

TRAFFIC SHT. 1 OF 7