


- DURABLE 4" WHITE LINE**
 391+00-416+80 (12' LT)
 417+62-421+00 (12' RT)
 391+00-421+00 (12' RT)
 TH 5 0+58(11' LT)-1+00(11' LT)
 TH 5 0+40(11' RT)-1+00(11' RT)
- DURABLE 4" YELLOW LINE**
 391+00-417+10 CL (DOUBLE)
 417+50-421+00 CL (DOUBLE)
 TH 5 0+25 - 1+00 CL (DOUBLE)
- TEMPORARY 24" STOP BAR**
 TH 5 0+26 (0'-30' LT)
- DURABLE 4" WHITE LINE**
 416+80(12' LT)-TH 5 0+58(11' LT)(37.5 R.)
 TH 5 0+40(11' RT)-417+62(12' LT)(50' R.)
- DURABLE 24" STOP BAR**
 TH 5 0+26 (0'-30' LT)
- DURABLE LETTER OR SYMBOL**
 TH 5 0+31(LT)-0+39(LT) (STOP)
- REMOVING SIGNS**
 AS SHOWN - 5 EA.

- TEMPORARY 4" WHITE LINE**
 391+00 - 416+80 (12' LT)
 417+62 - 421+00 (12' RT)
 391+00 - 421+00 (12' RT)
- TEMPORARY 4" YELLOW LINE**
 391+00 - 417+10 CL (DOUBLE)
 417+50 - 421+00 CL (DOUBLE)

PLAN
SCALE: 1"=50'

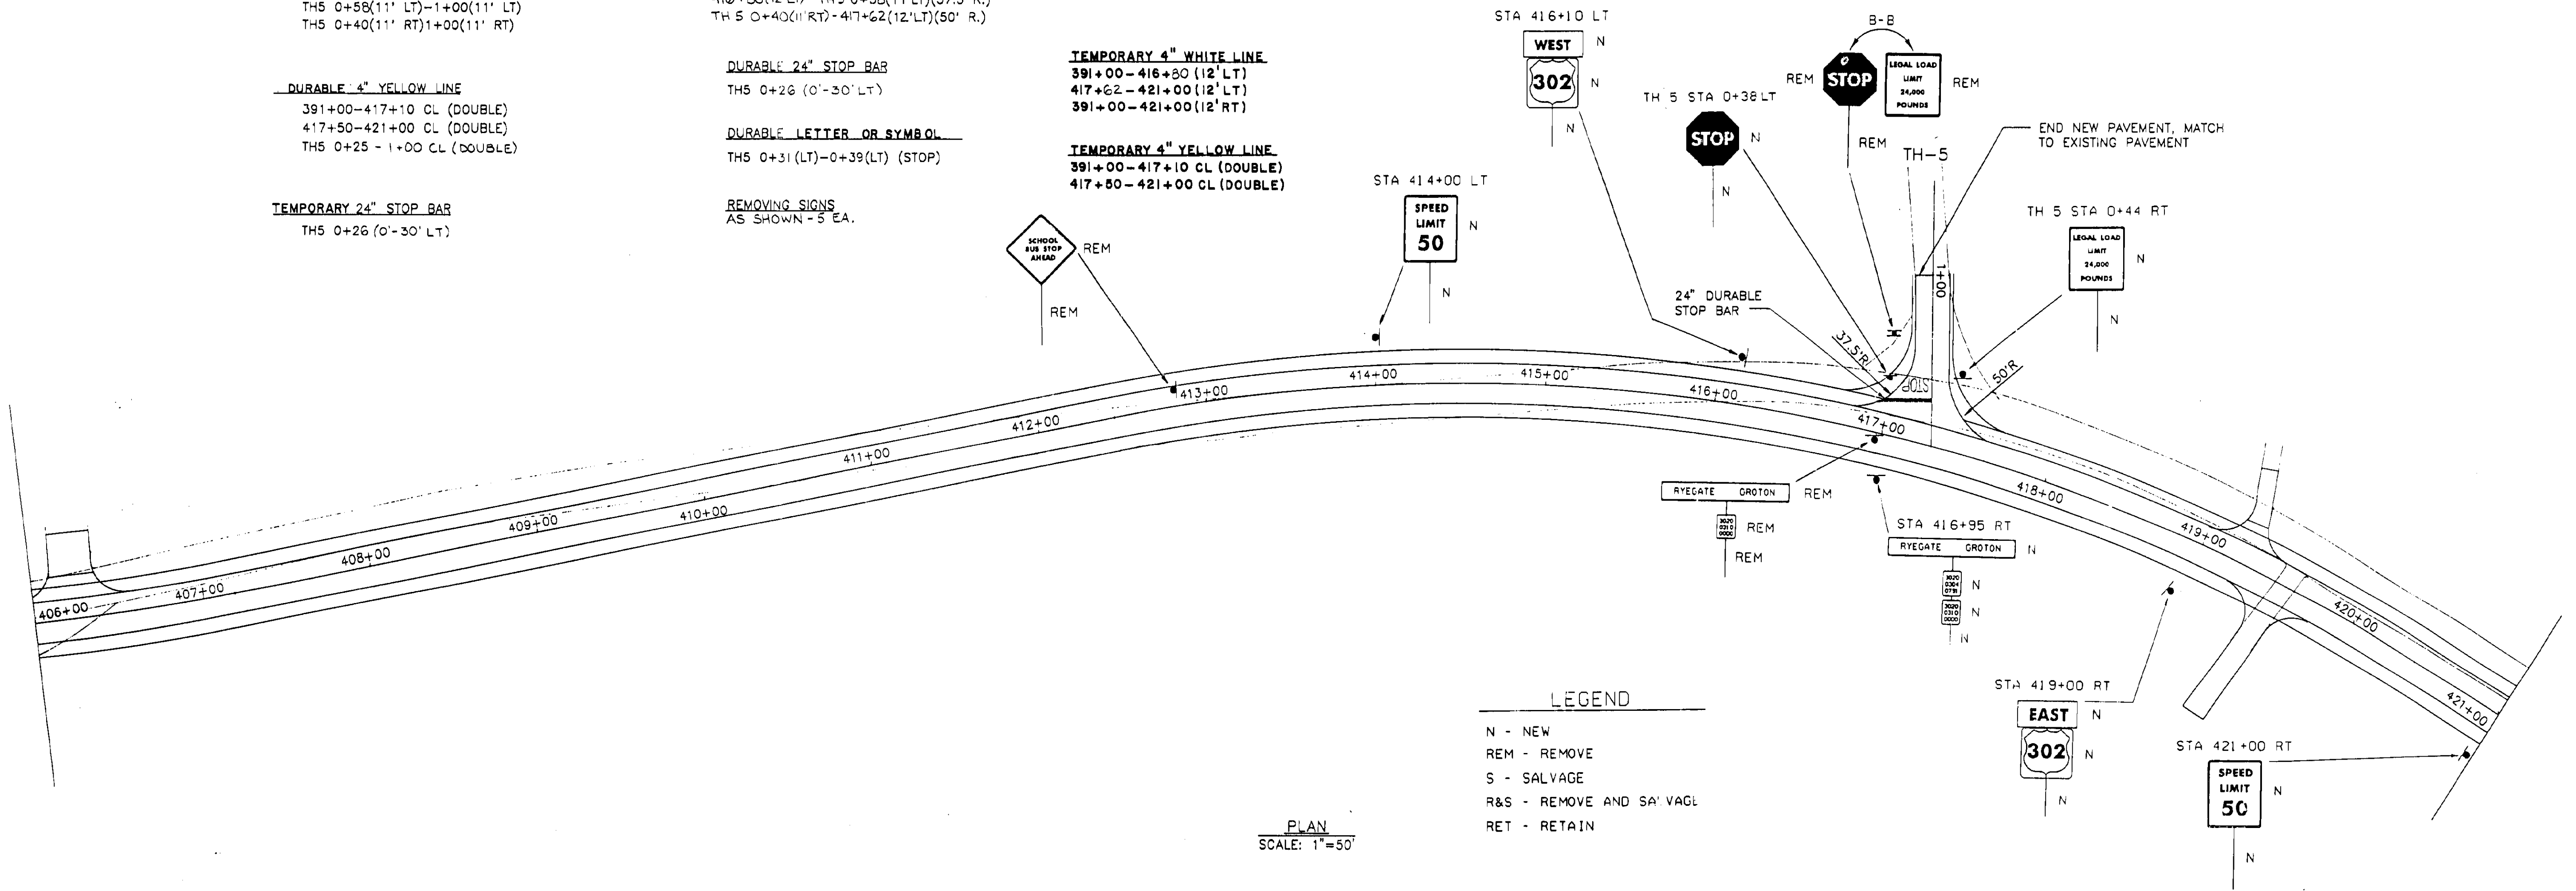

PLAN
SCALE: 1"=50'

- LEGEND**
- N - NEW
 - REM - REMOVE
 - S - SALVAGE
 - R&S - REMOVE AND SALVAGE
 - RET - RETAIN