

DURABLE 4" WHITE LINE
 451+00-491+00, 12' LT
 451+00-491+00, 12' RT

DURABLE 4" YELLOW LINE
 451+00-491+00, Q (DOUBLE)


REMOVING SIGNS
 AS SHOWN - 1 EA.

ERECTING SALVAGED SIGNS
 AS SHOWN - 1 EA.

TEMPORARY 4" WHITE LINE
 451+00- 491+00, 12' LT
 451+00- 491+00, 12' RT

TEMPORARY 4" YELLOW LINE
 451+00- 491+00, Q (DOUBLE)


PLAN
 SCALE: 1"=50'

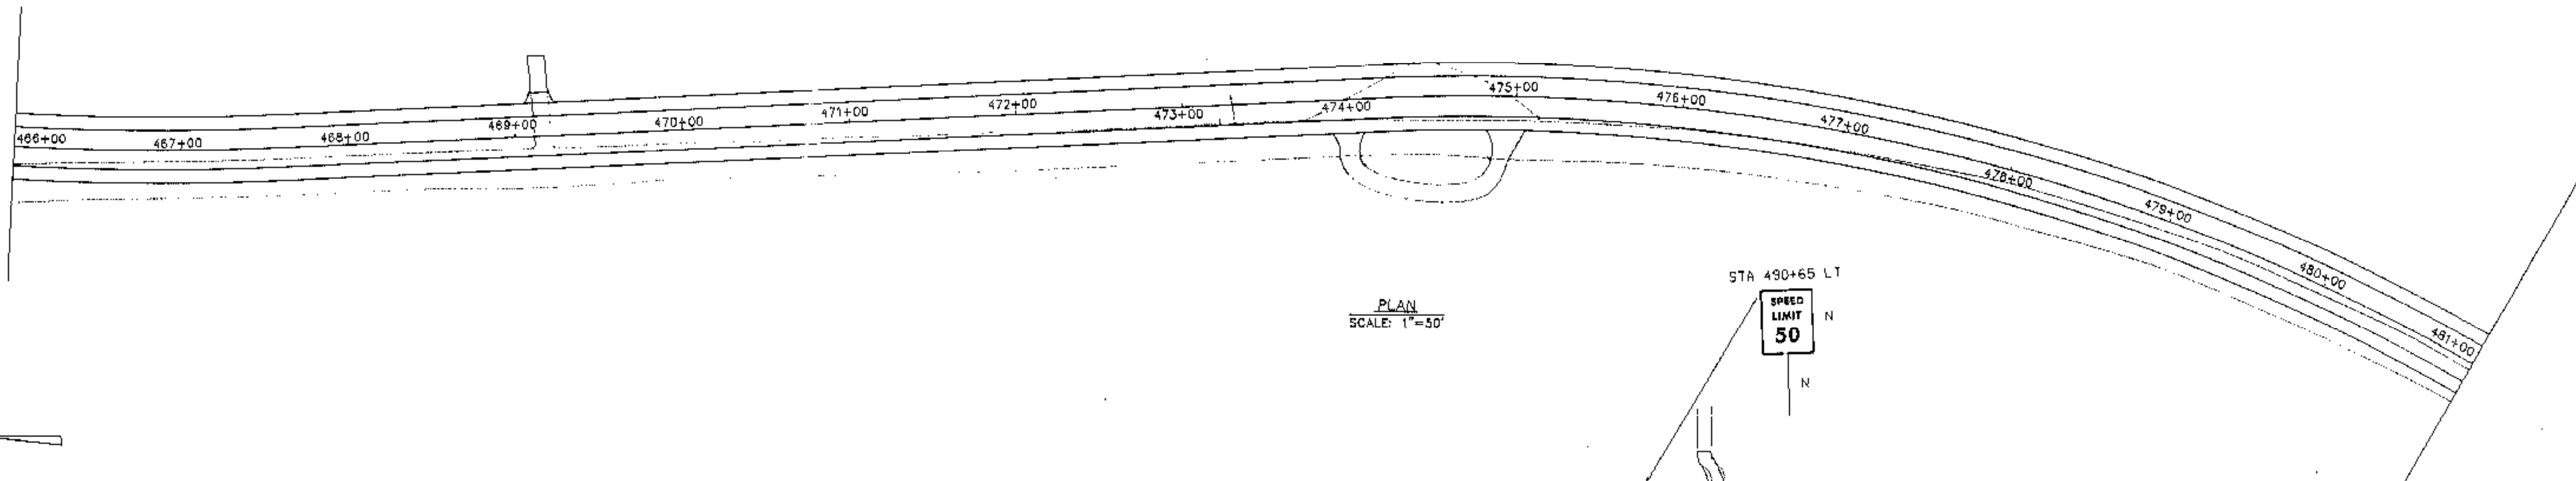

PLAN
 SCALE: 1"=50'

STA 490+65 LT

SPEED
 LIMIT
 50

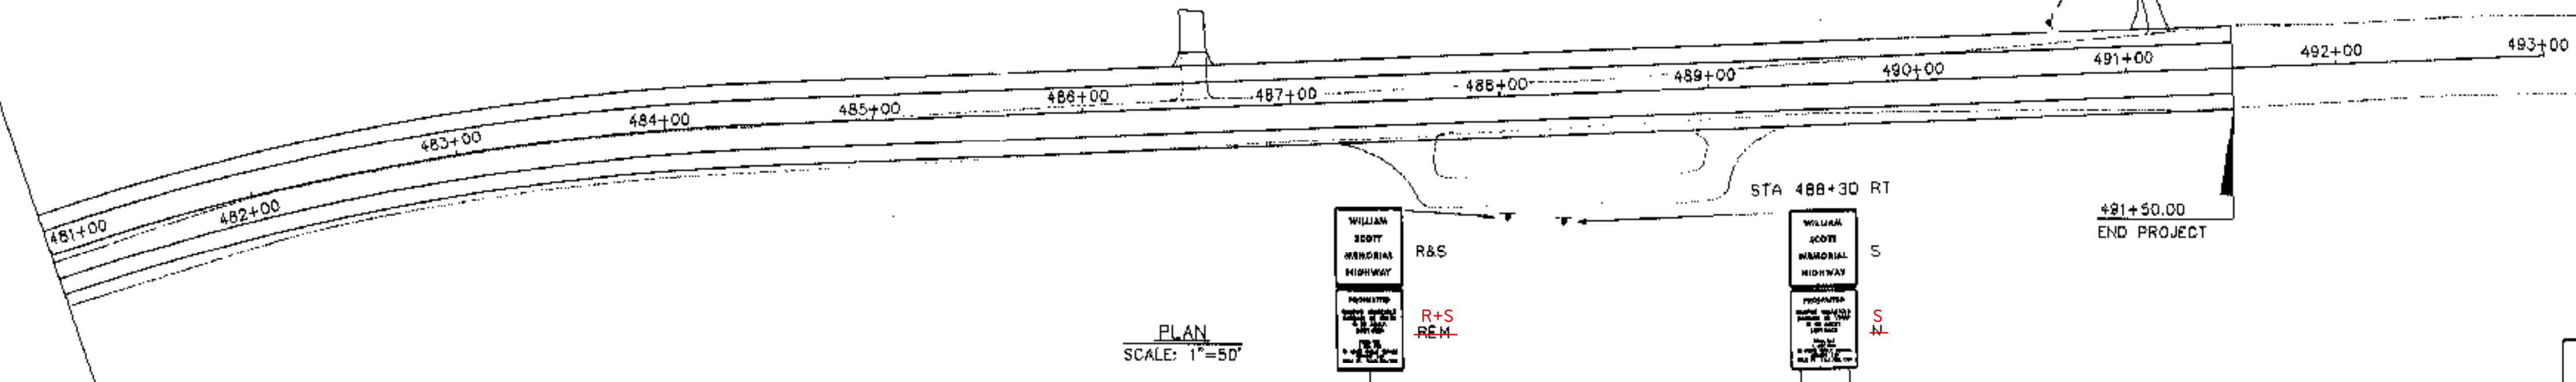

PLAN
 SCALE: 1"=50'

STA 488+30 RT

491+50.00
 END PROJECT



LEGEND

- N - NEW
- REM - REMOVE
- S - SALVAGE
- R&S - REMOVE AND SALVAGE
- RET - RETAIN

TRAFFIC SHEETS

PROJECT NAME: CROTON/RYEGATE
 NO.: F026-1(30)
 SHEET 65 OF 122 SHEETS

TRAFFIC SHT. 4 OF 7