
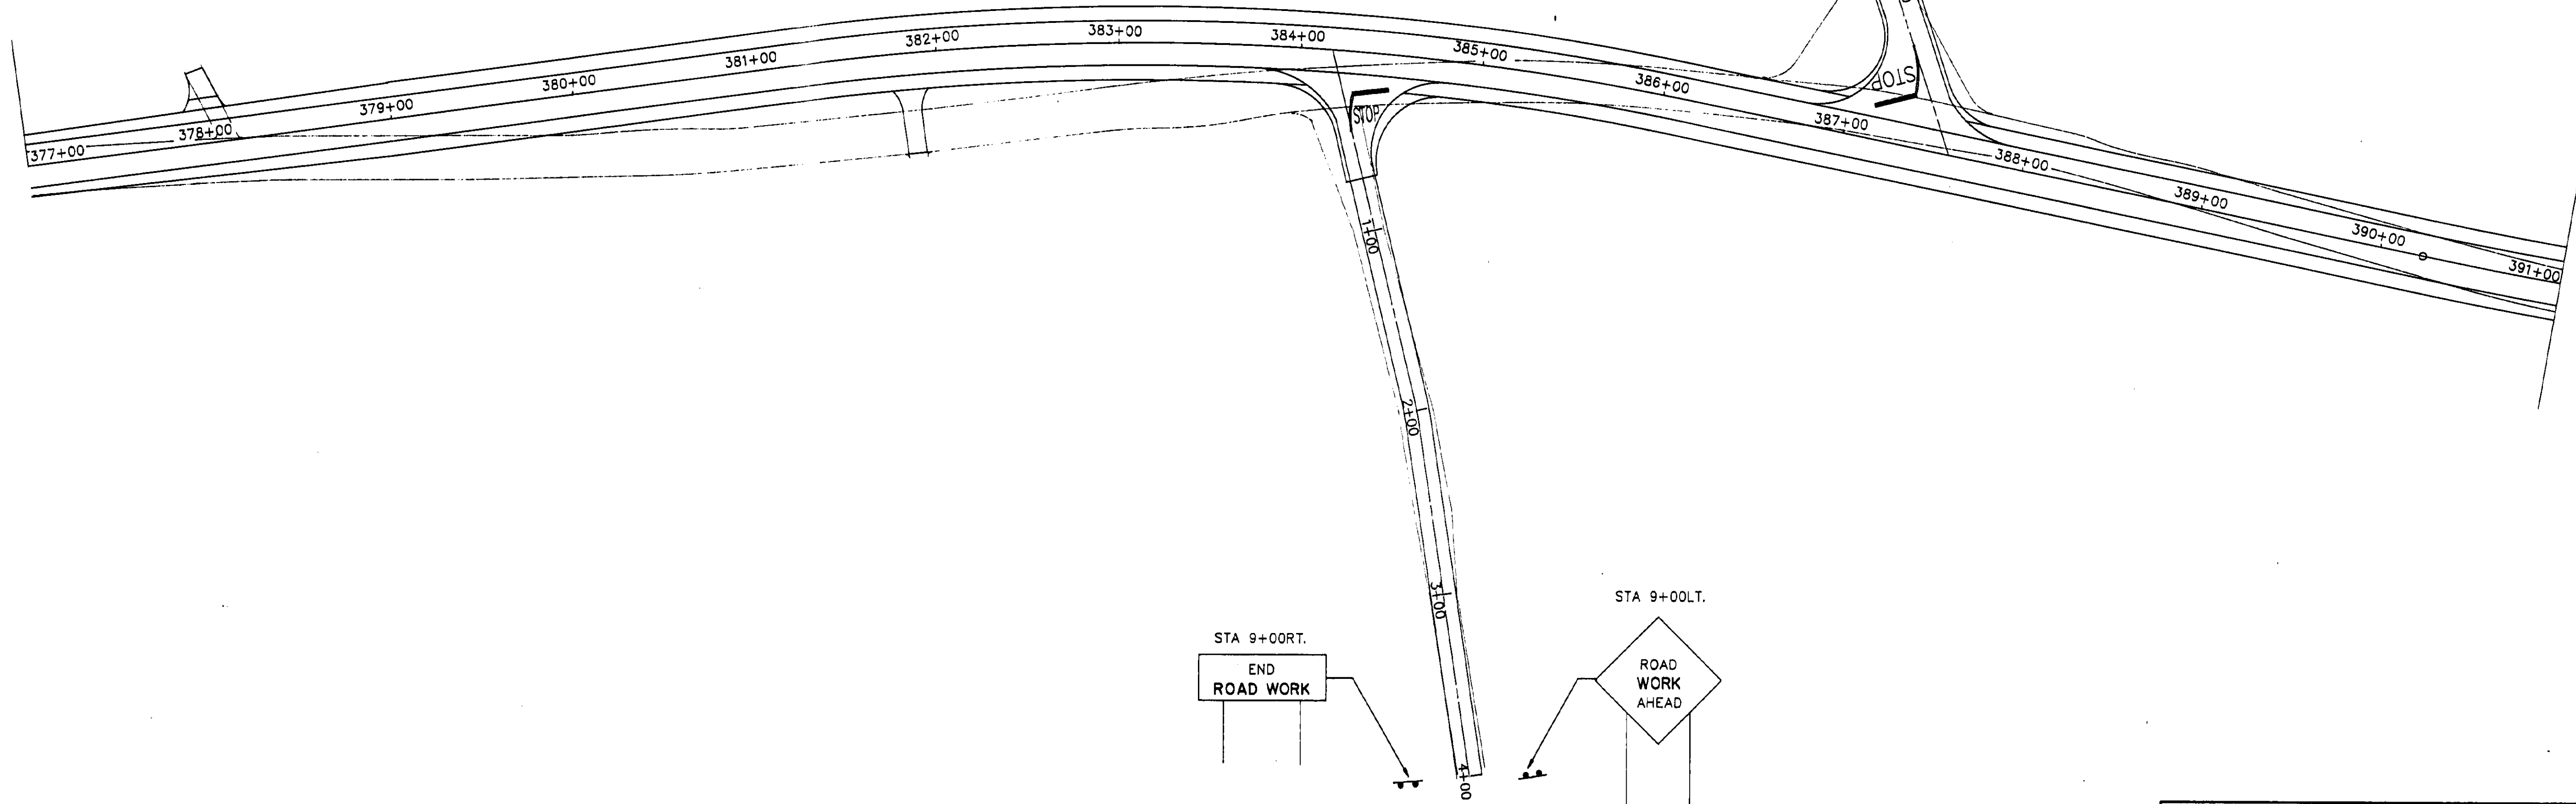


PLAN
SCALE: 1"=50'

NOTE:
ALL CONSTRUCTION SIGNS TO BE
MOUNTED ON TWO POSTS.

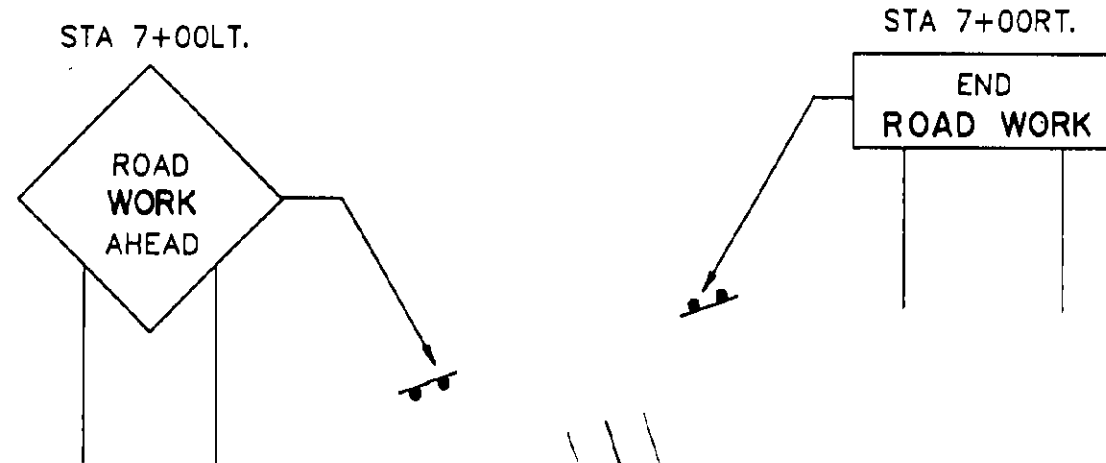

PLAN
SCALE: 1"=50'

TRAFFIC SHEETS	
PROJECT NAME:	GROTON/RYGATE
NO.:	F026-1(30)
SHEET 71 OF 152 SHEETS	CONSTRUCTION SHT. 1 OF 4

