
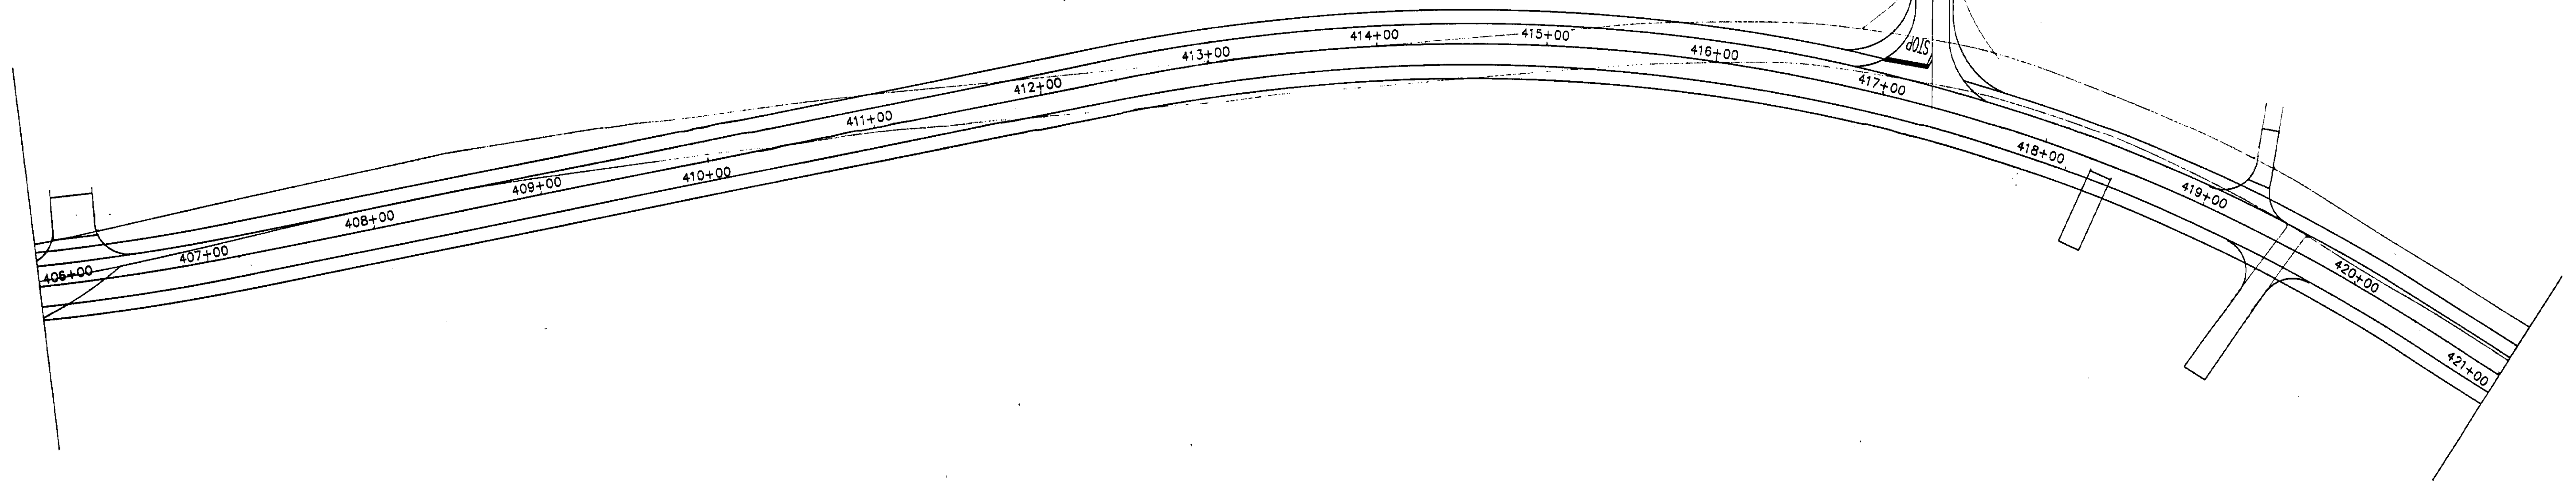
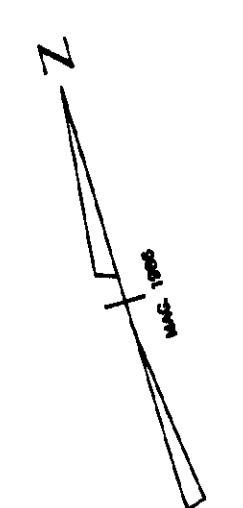


PLAN
SCALE: 1"=50'

NOTE:
ALL CONSTRUCTION SIGNS TO BE
MOUNTED ON TWO POSTS.

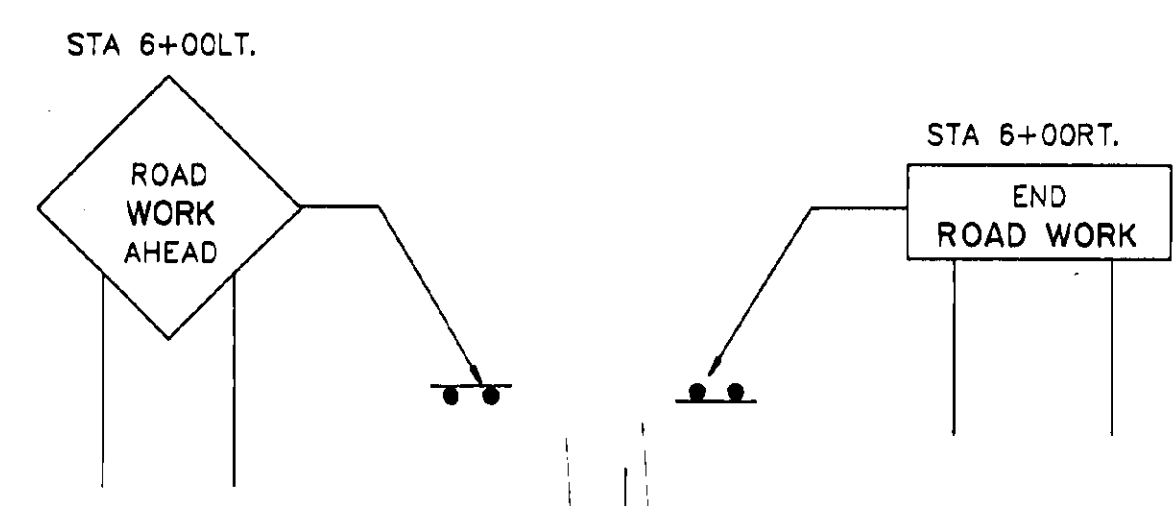

PLAN
SCALE: 1"=50'