
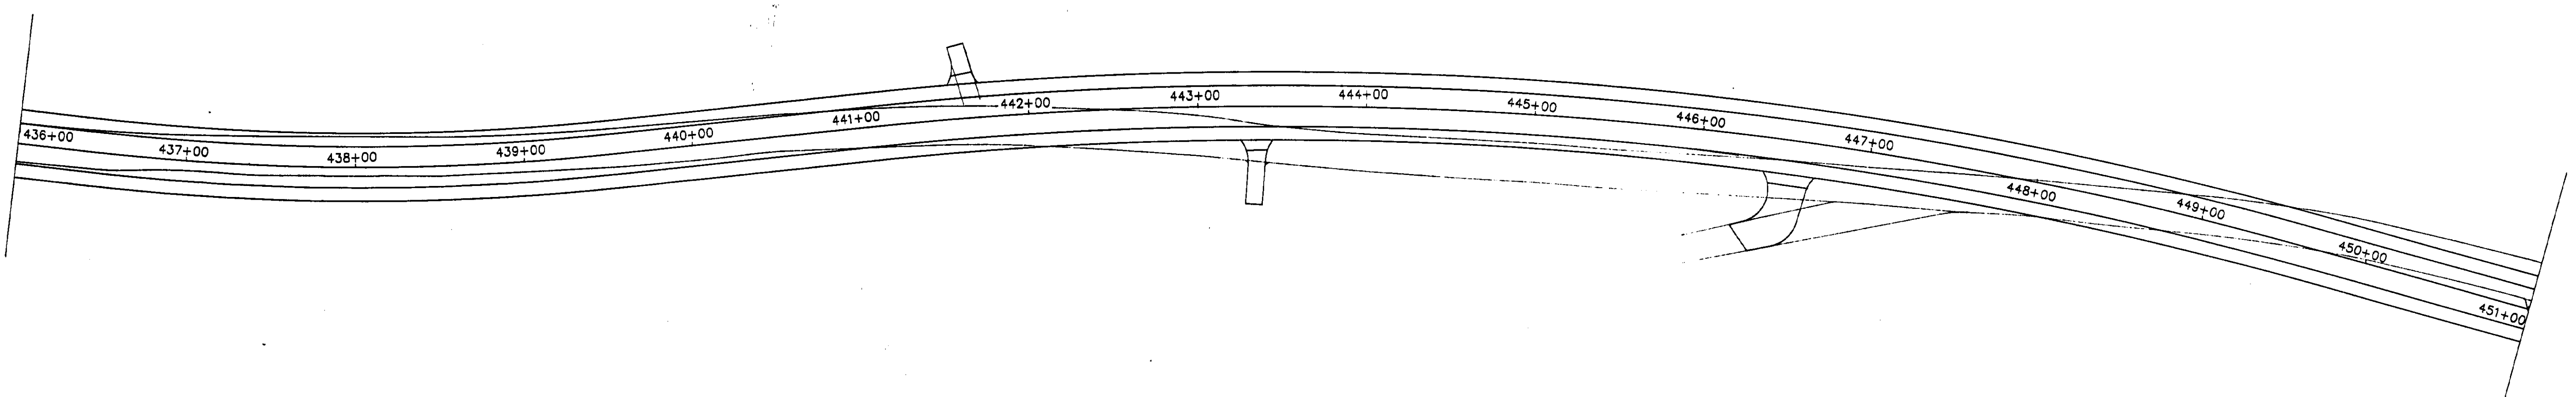


PLAN
SCALE: 1"=50'

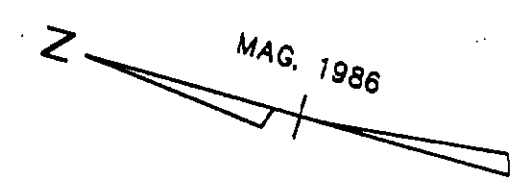

PLAN
SCALE: 1"=50'

NOTE:
ALL CONSTRUCTION SIGNS
TO BE MOUNTED ON TWO POSTS.

TRAFFIC SHEETS

PROJECT NAME: GROTON/RYEGATE
NO.: F026-1(30)
SHEET 73 OF 152 SHEETS CONSTRUCTION SHT. 3 OF 4