


PLAN
SCALE: 1"=50'


NOTE:
ALL CONSTRUCTION SIGNS TO BE
MOUNTED ON TWO POSTS.

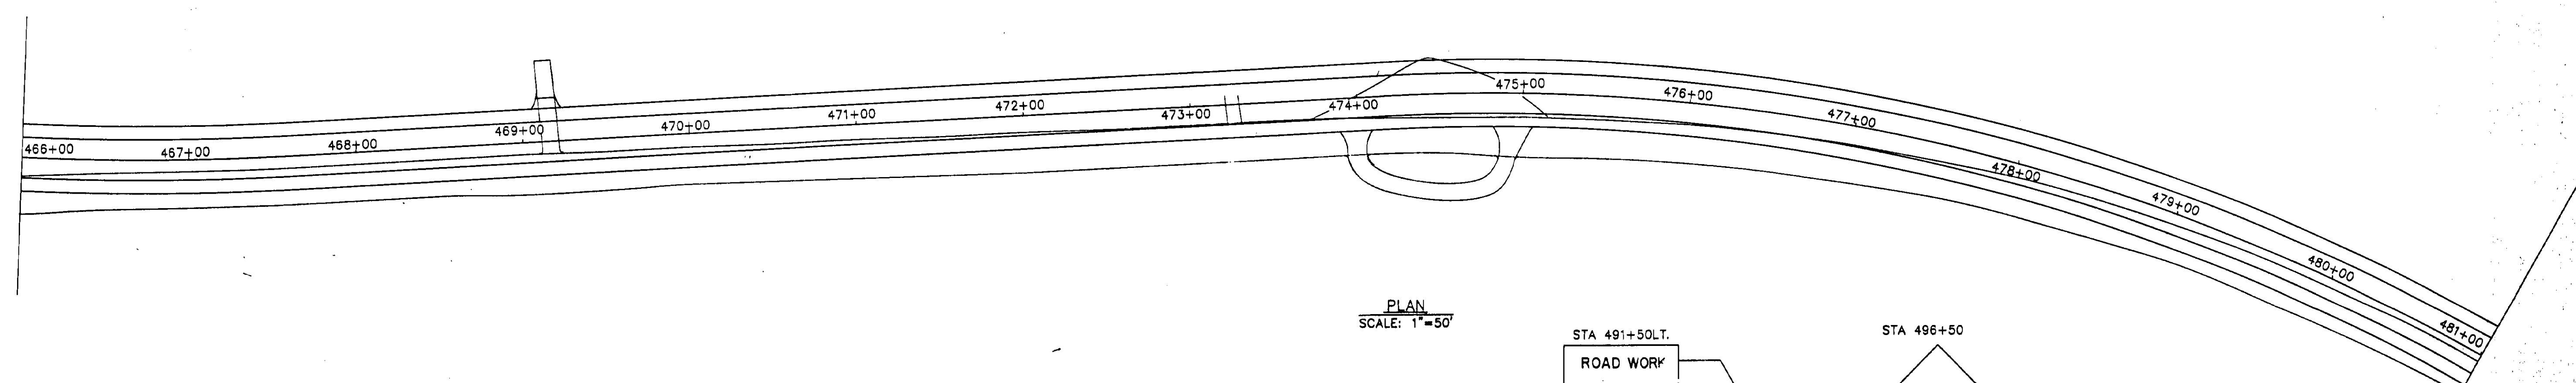

PLAN
SCALE: 1"=50'

STA 491+50LT.
ROAD WORK
NEXT 2 MILES

STA 496+50
ROAD WORK
500FT

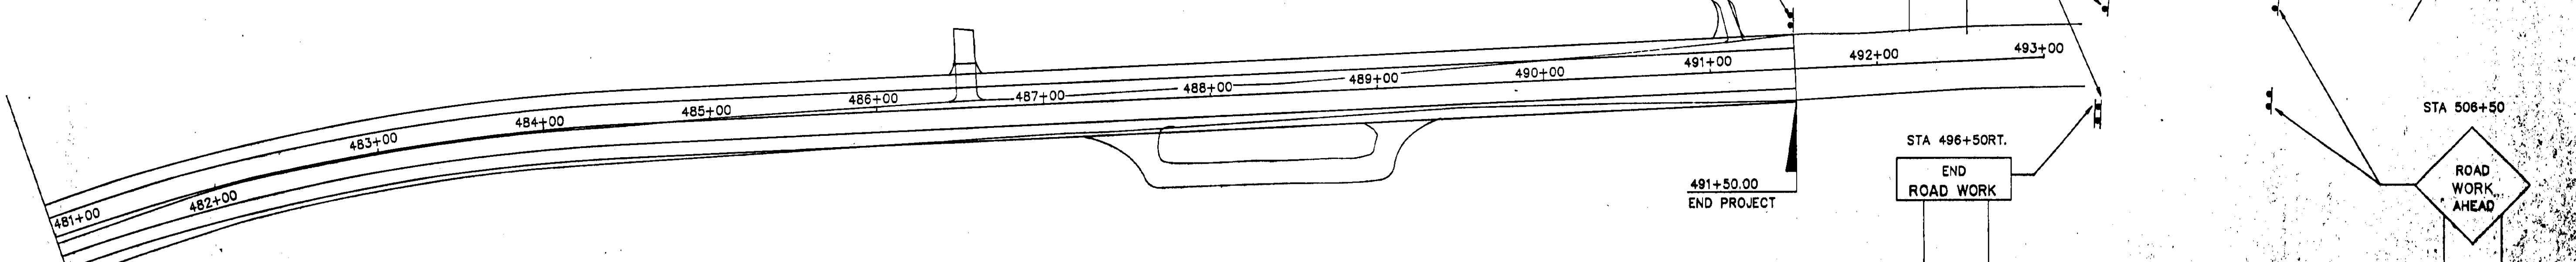

PLAN
SCALE: 1"=50'

STA 496+50RT.
END
ROAD WORK

STA 506+50
ROAD
WORK
AHEAD

TRAFFIC SHEETS

PROJECT NAME: GROTON/RYEGATE
 NO.: F026-1(30)
 SHEET 74 OF 152 SHEETS

CONSTRUCTION SH. 4 OF 1