



CROSS SECTION DARIUS JAMES DETOUR  
SCALE: HORIZONTAL 1" = 10'  
VERTICAL 1" = 10'

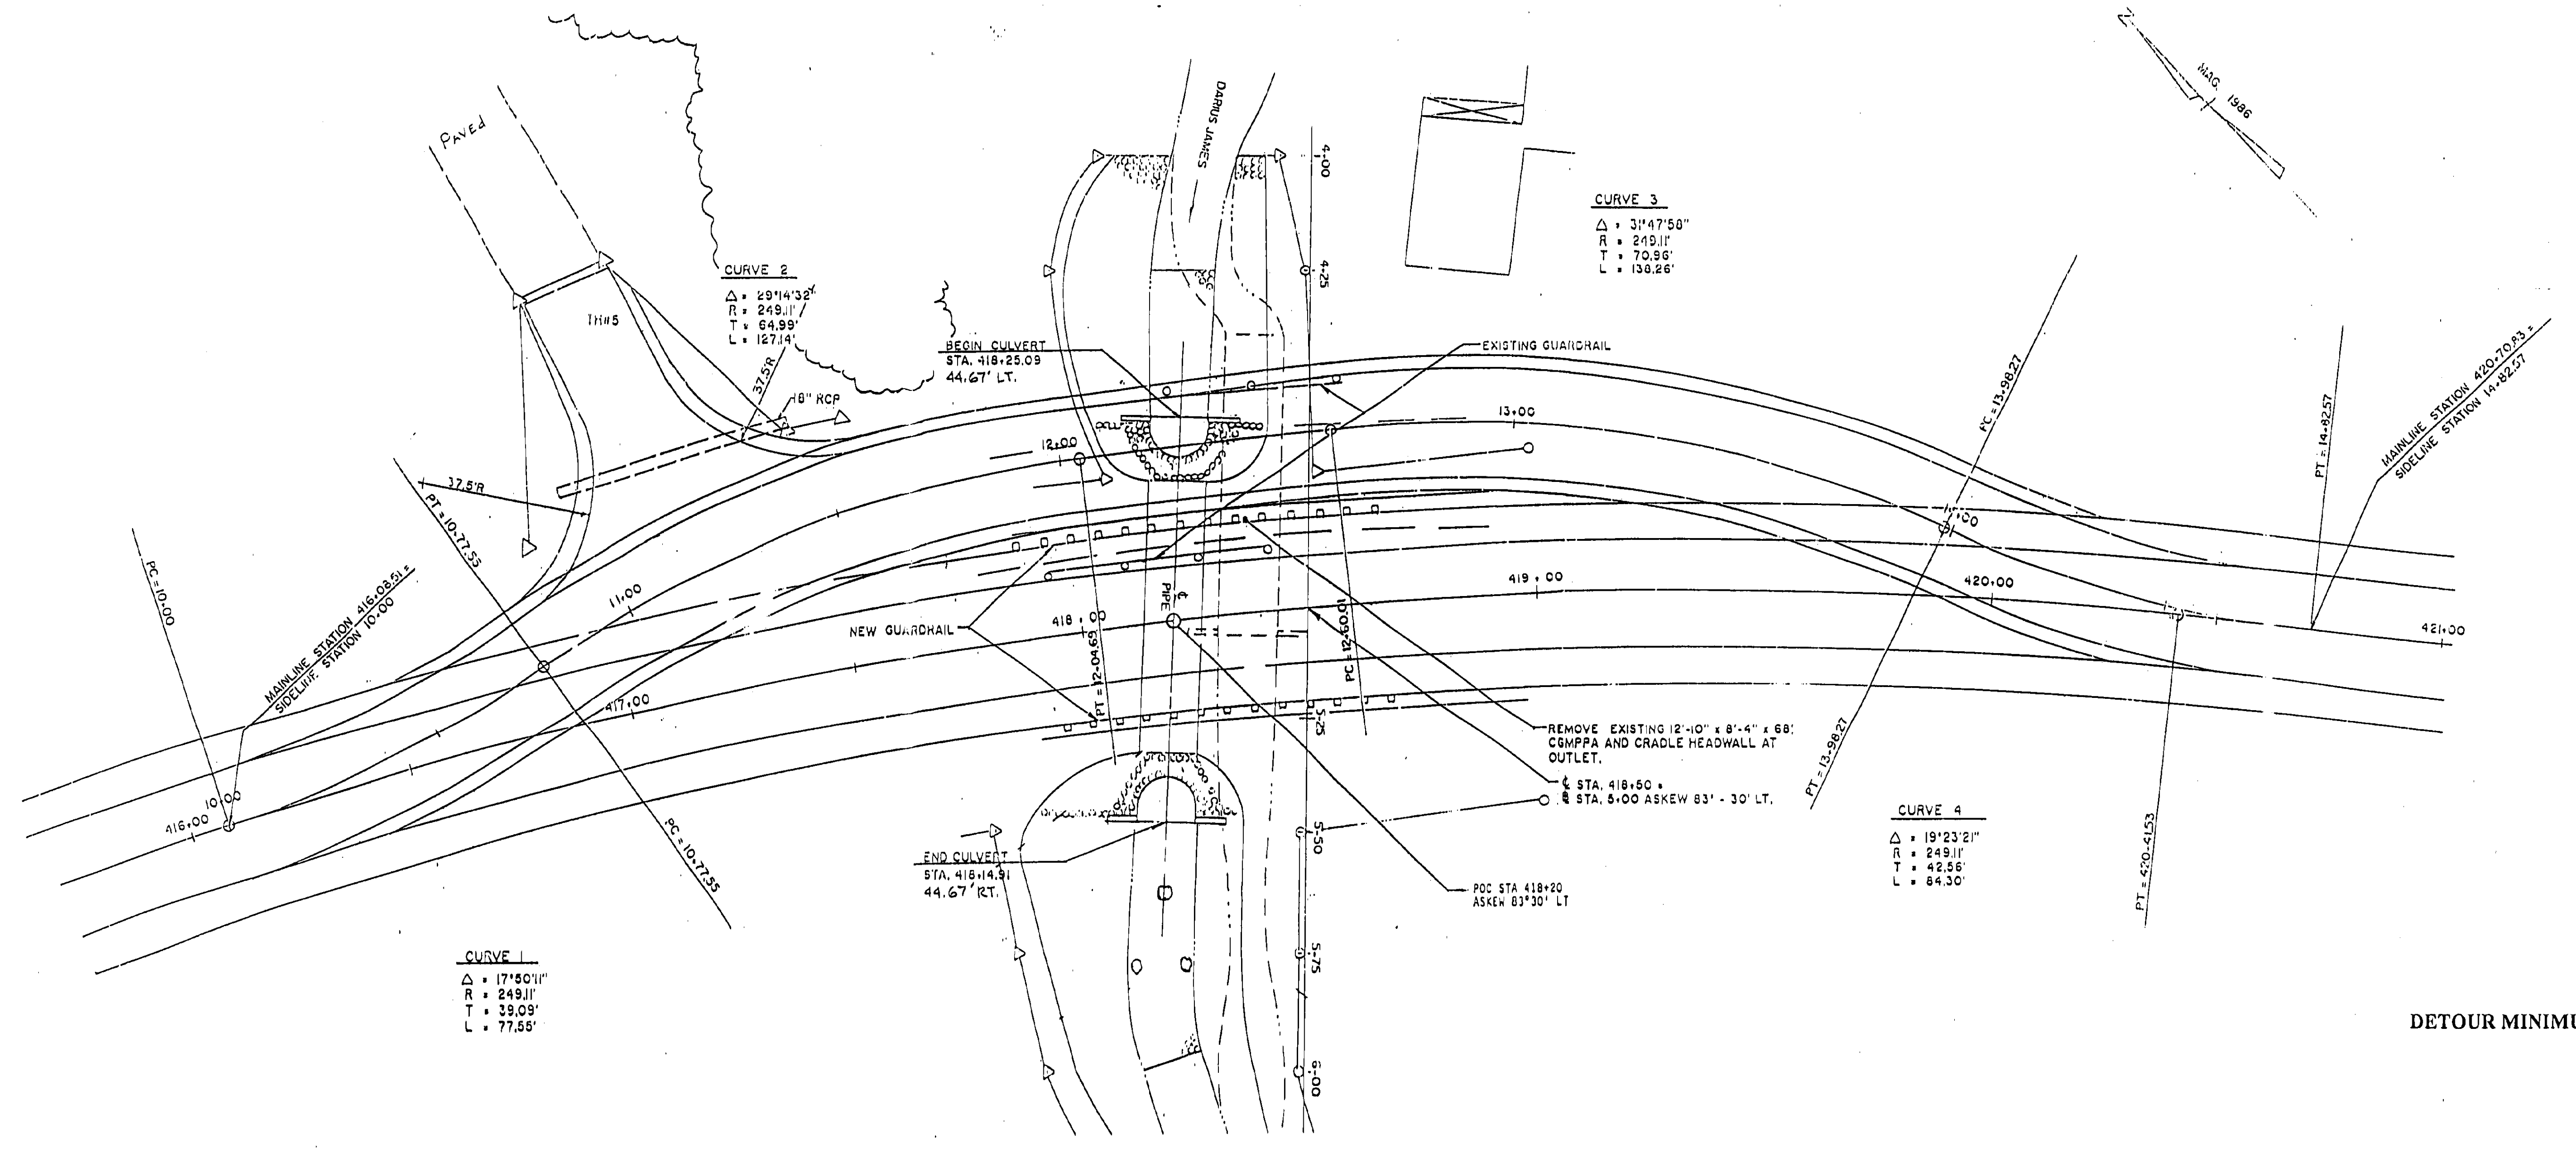

DARIUS JAMES BROOK CROSSING DETOUR  
PLAN VIEW

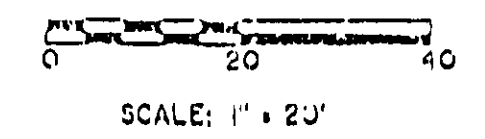

DETOUR MINIMUM DESIGN SPEED 25 M.P.H.