


DATE	
BY	
REVIEWED	
PLOTTED	
TEMPERATURE	
NO. OF SHEETS	
NO. OF SHEETS CHECKED	
FINAL SURVEY	
NOTE BOOK	
NO.	


DATE	DEC 86
BY	E.C.S., R.S.B., G.F.
REVIEWED	G.P.F., P.V.B.
PLOTTED	G.W.
TEMPERATURE	52.5
NO. OF SHEETS	57/77
NO. OF SHEETS CHECKED	
ORIGINAL SURVEY	
NOTE BOOK	
NO.	

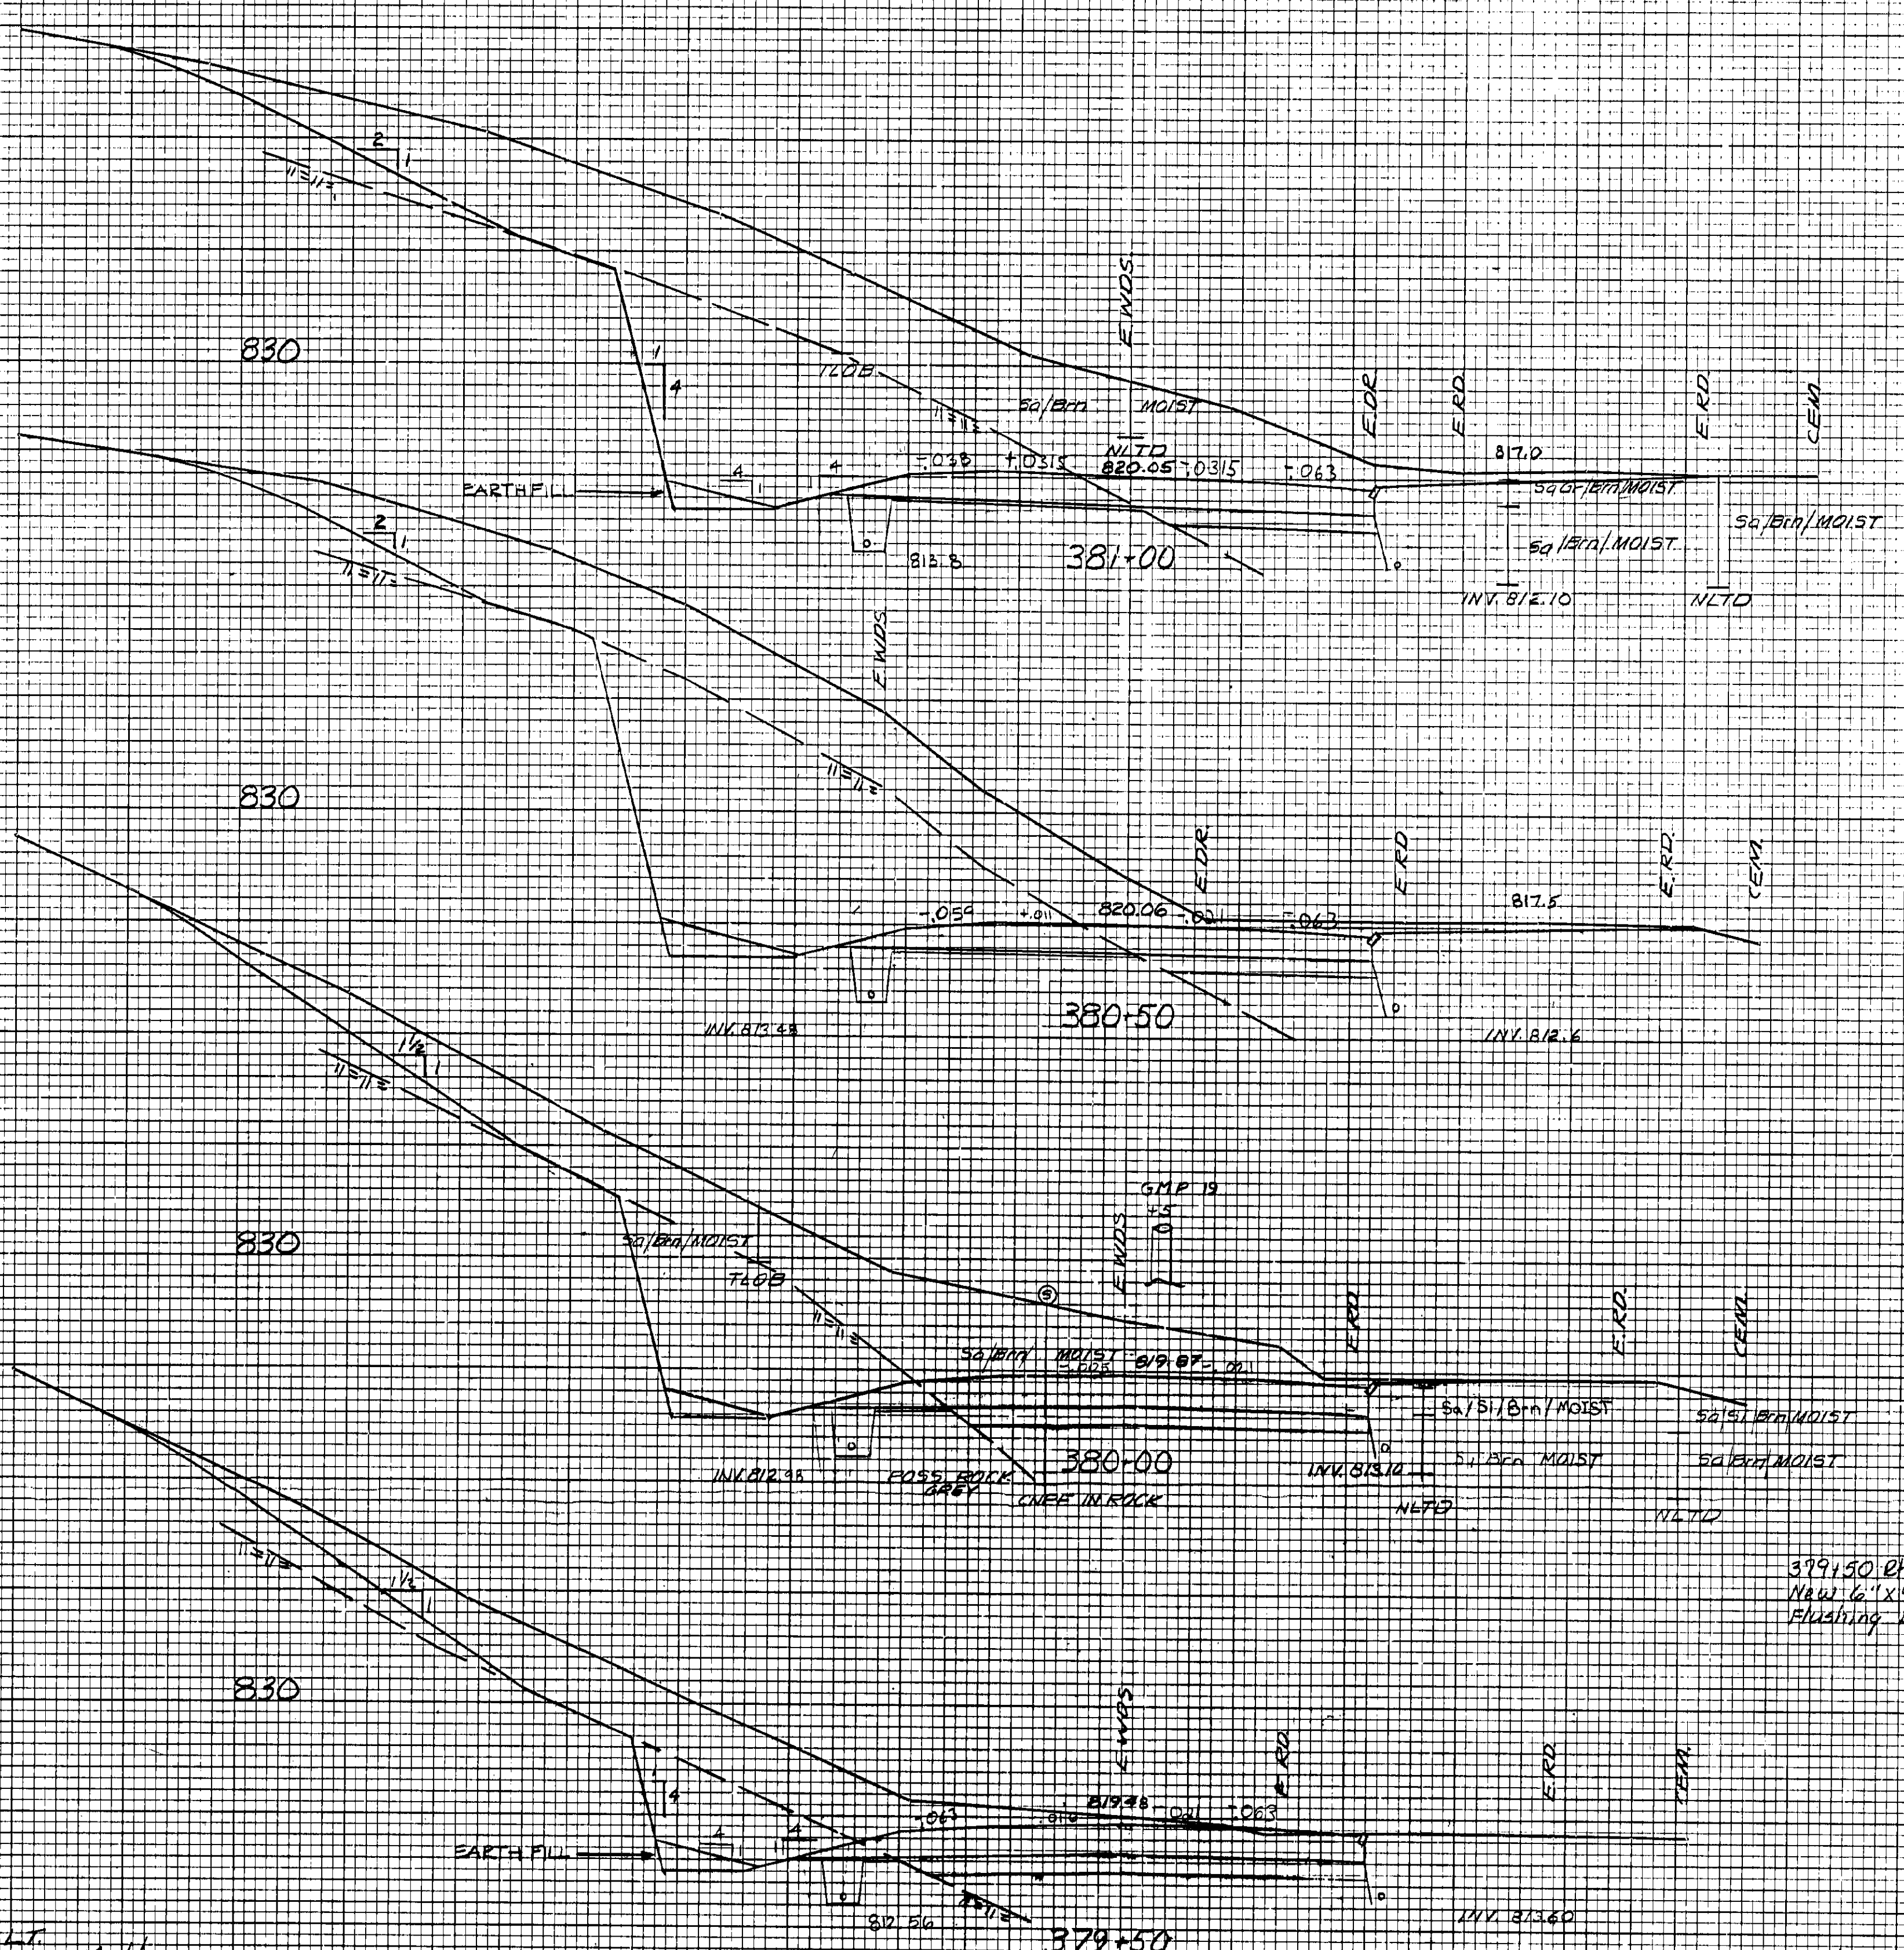

379+50 Lt.  
End Erosion Matting

379+25  
Begin Drilling and Blasting of  
Solid Rock Subgrade

BEGIN PROJECT  
END APPROACH

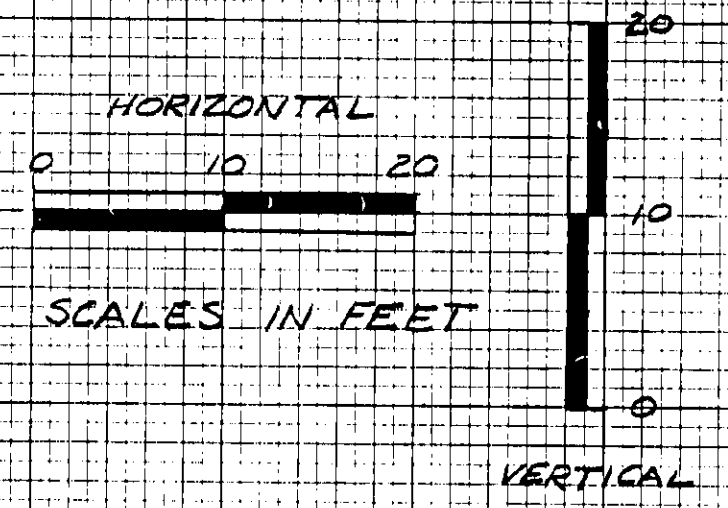

CROSS SECTIONS  
STA. 379+50 TO STA. 381+00  
GROUT-RYEGATE F026-1(30)  
SHEET 90 OF 152