
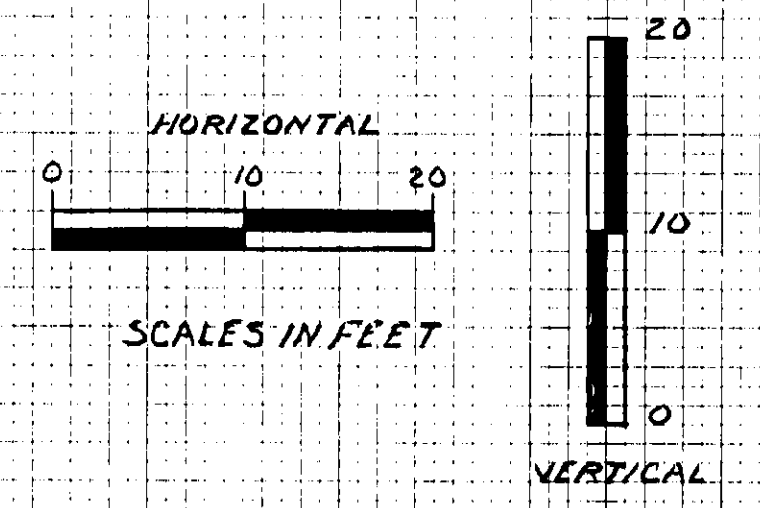


DATE	
BY	
PROJECT	
NO. 211537	
DATE	
BY	
PROJECT	
NO. 211537	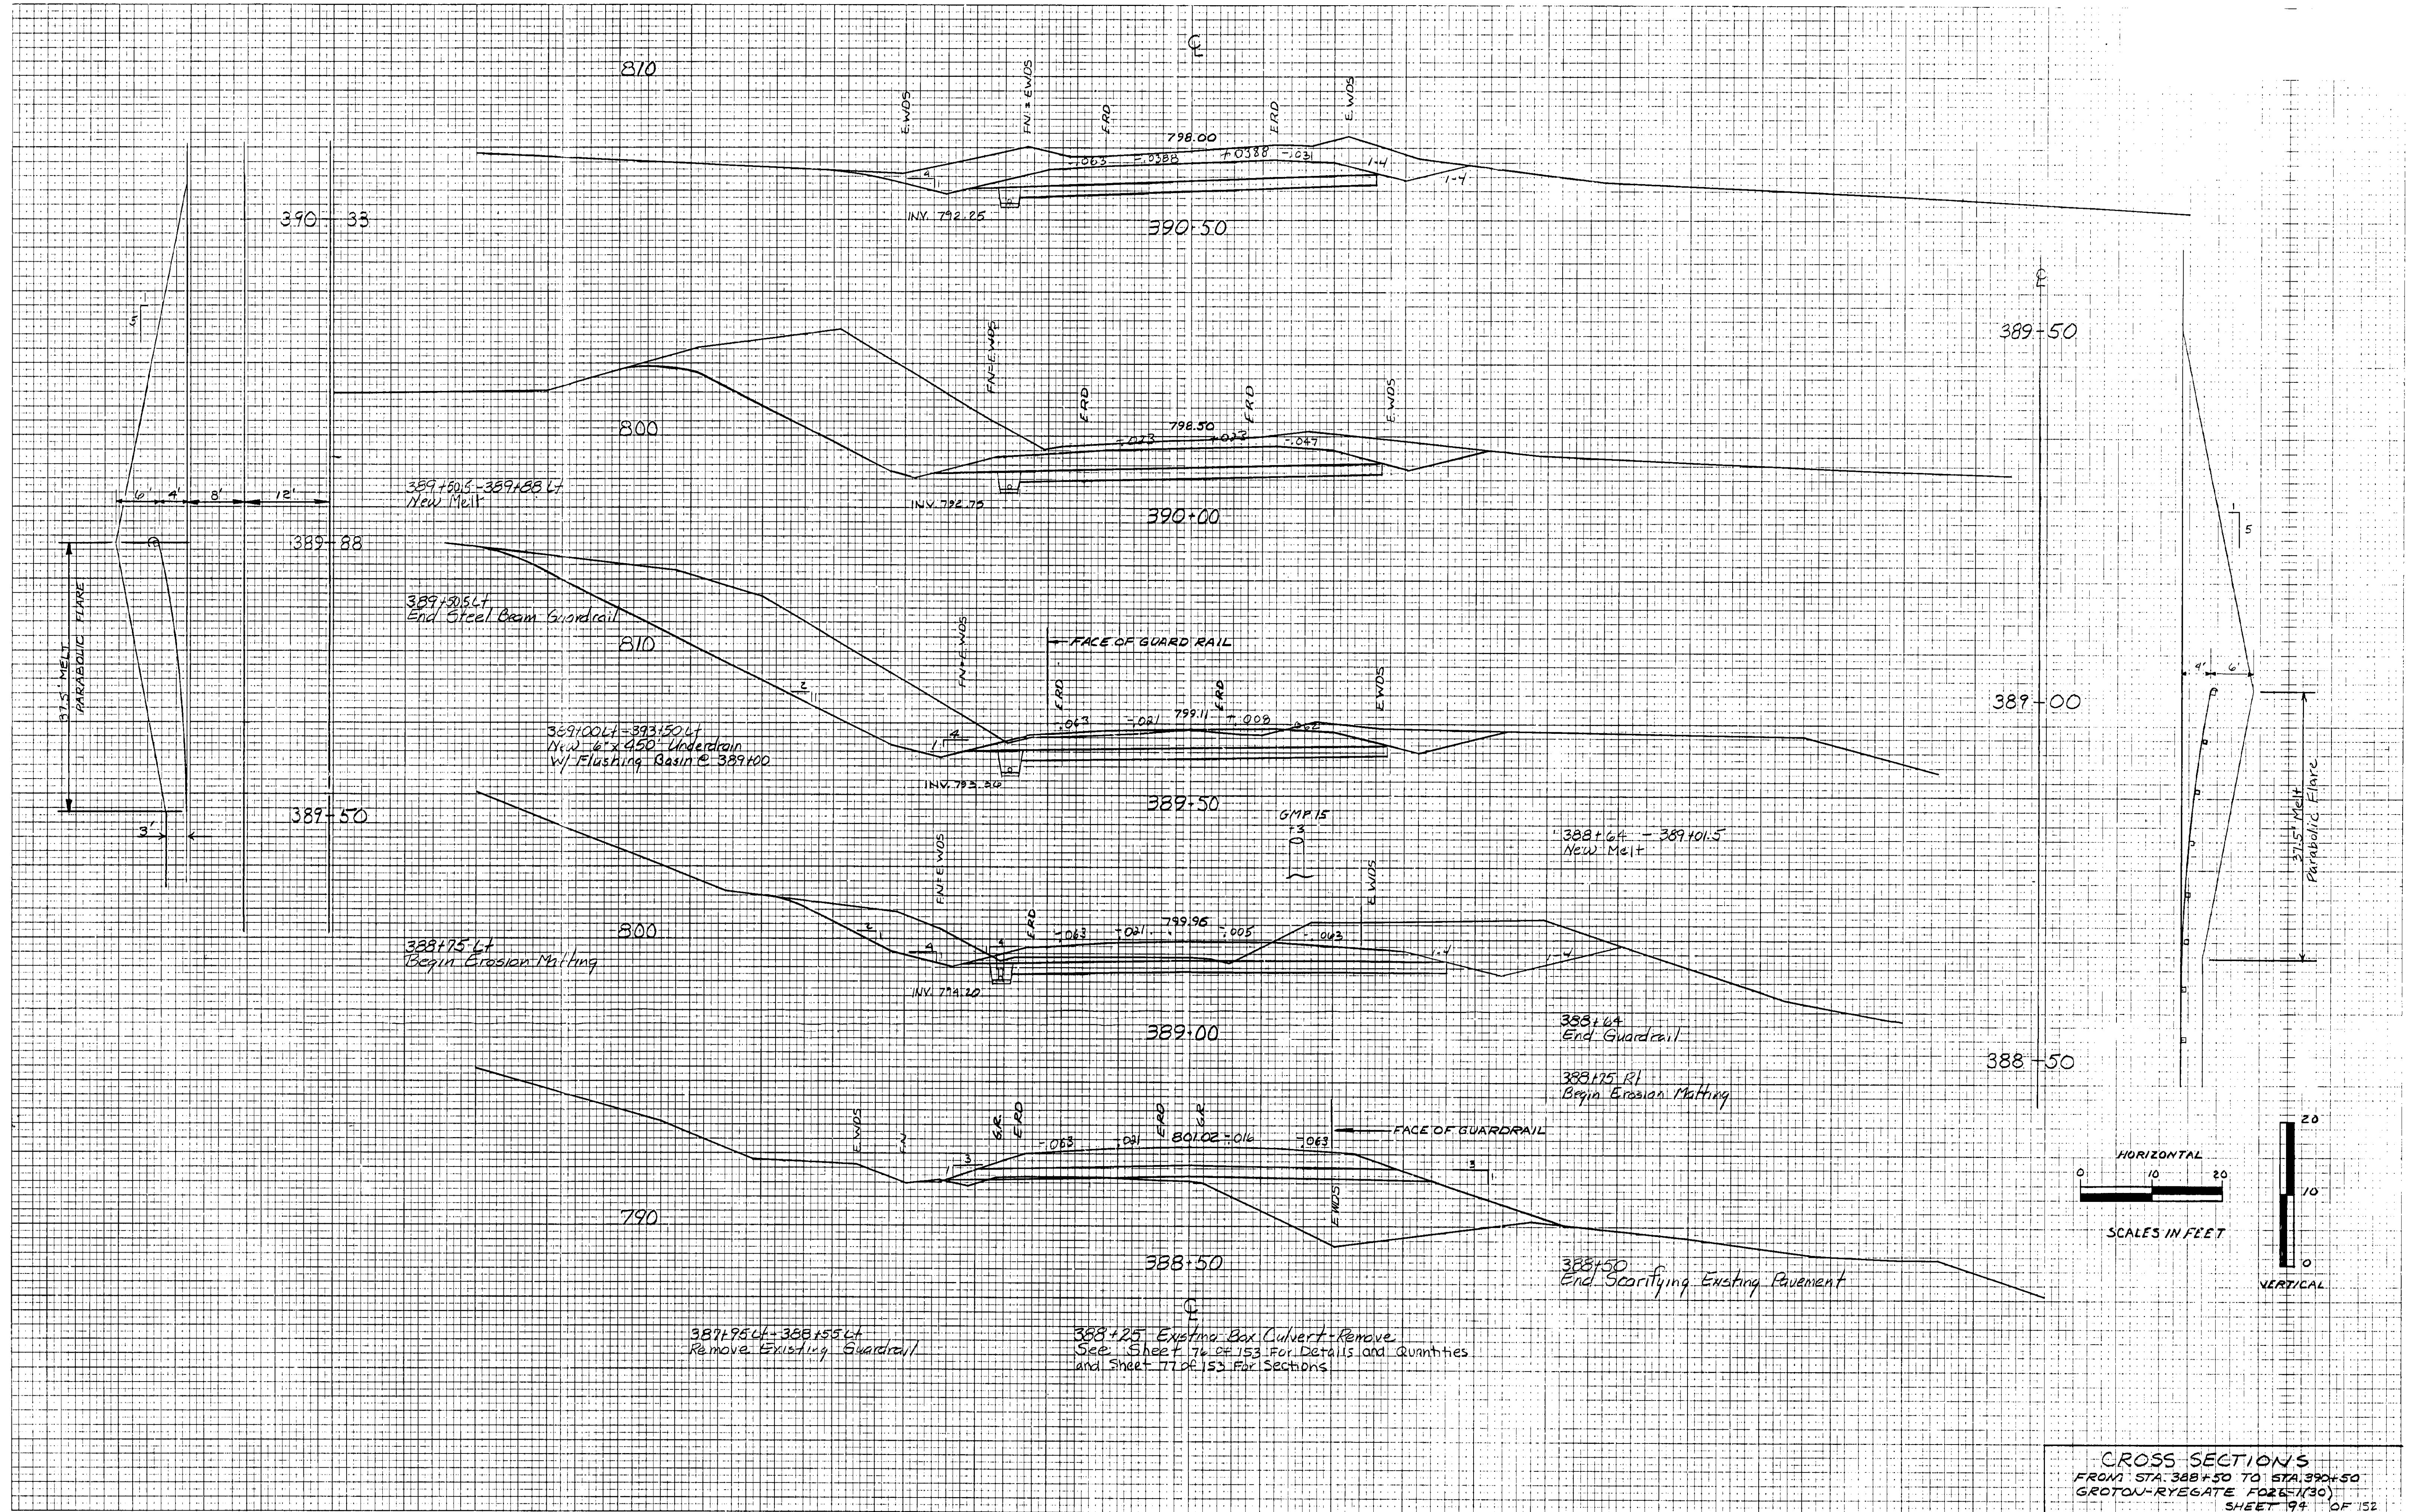
CROSS SECTIONS
FROM STA. 388+50 TO STA. 390+50
GROTON-RYEGATE F026-1(30)
SHEET 99 OF 152