
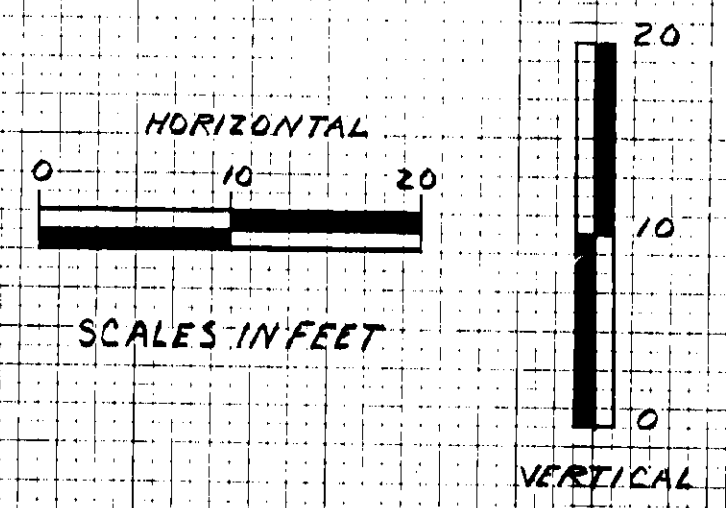


DATE	
BY	
NO. OF SHEETS	
NO. OF SHEETS PLOTTED	
NO. OF SHEETS CHECKED	
NO.	

DATE	DEC 14
BY	ECS, J.B.G.F.F.
NO. OF SHEETS	10
NO. OF SHEETS PLOTTED	10
NO. OF SHEETS CHECKED	10
NO.	277, 278

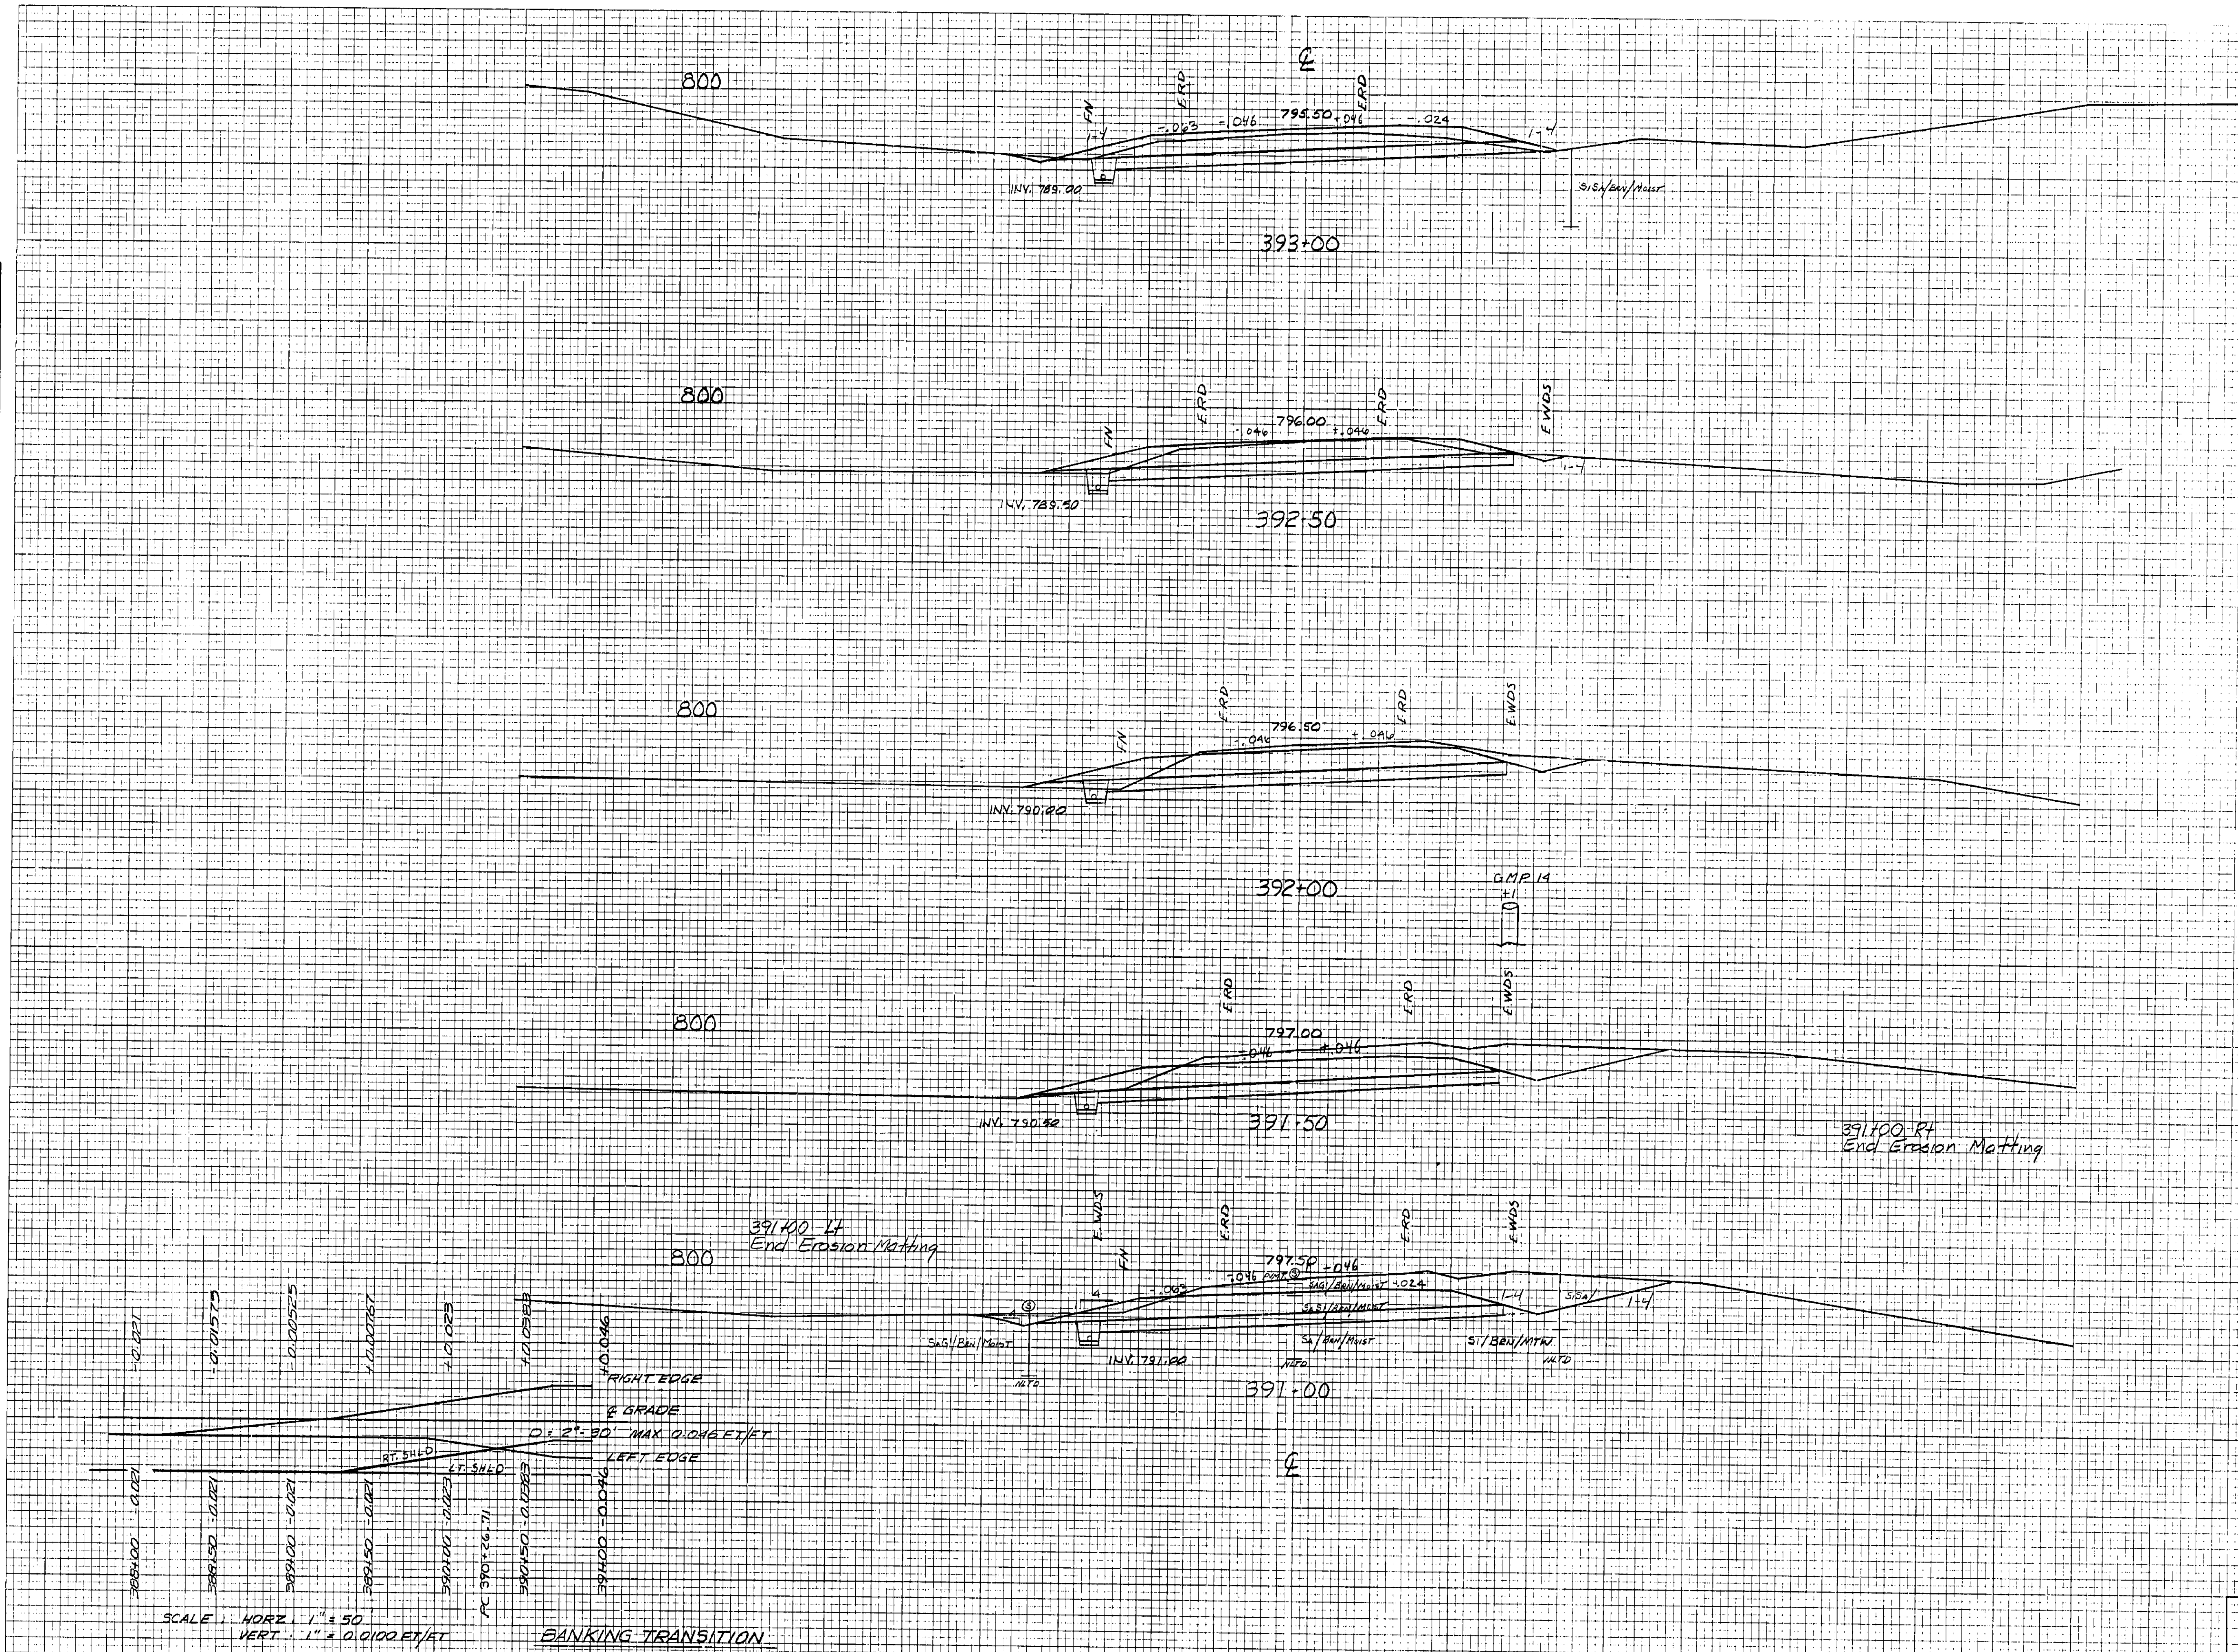

CROSS SECTIONS
STA. 391+00 TO STA. 393+00
GROTON-RYEGATE FOEG-1(30)
SHEET 96 OF 152