
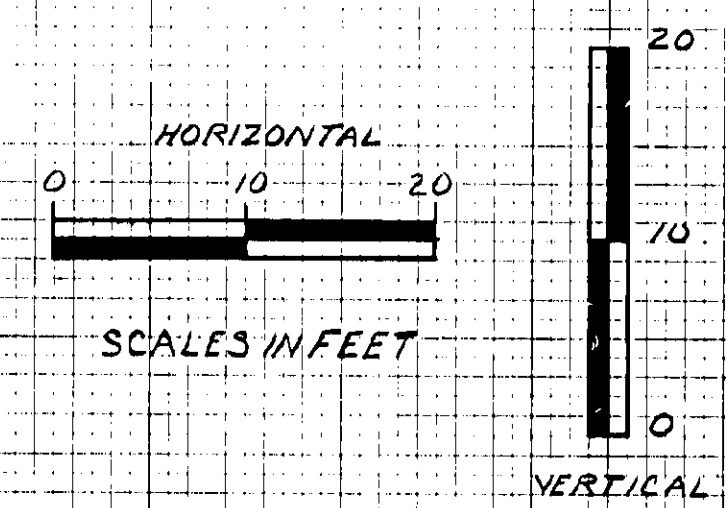


DATE	
BY	
PROJECT	
PLANT	
NO.	
FINAL SURVEY NOTE BOOK NO.	

DATE	
BY	
PROJECT	
PLANT	
NO.	
ORIGINAL SURVEY NOTE BOOK NO.	

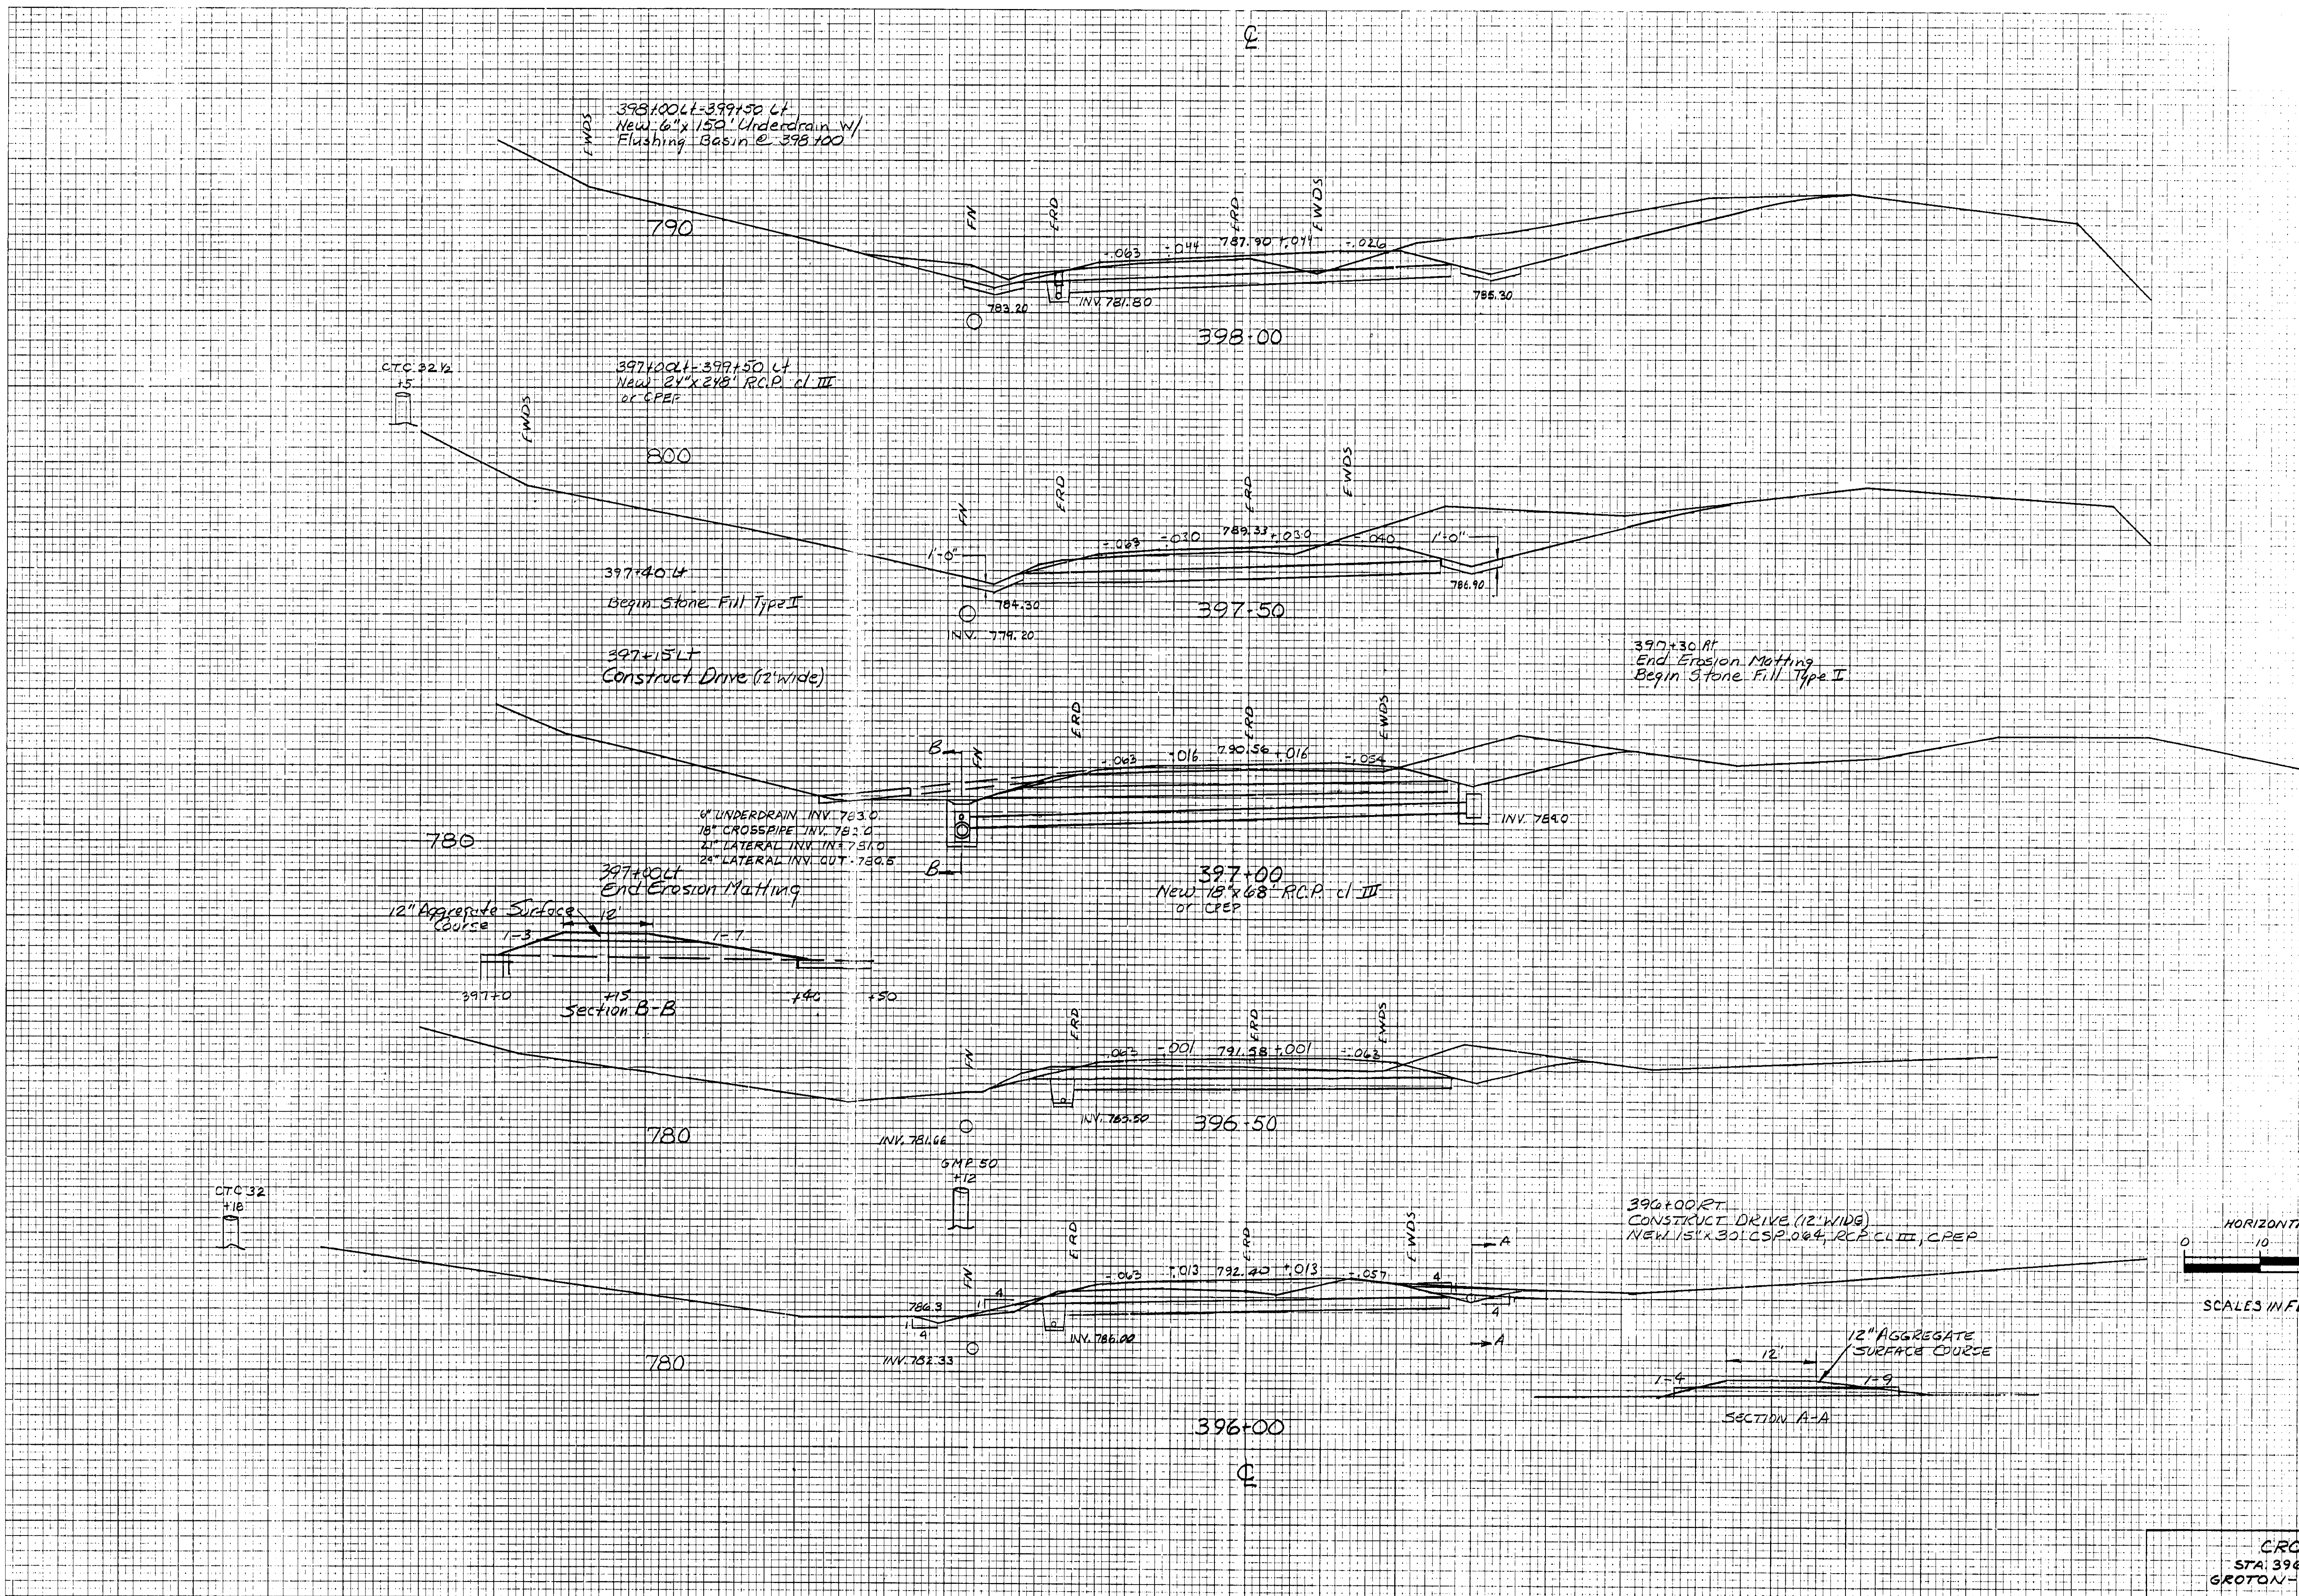

CROSS SECTIONS
STA: 396+00 TO STA: 398+00
GROTON-RYEGATE RD 26-1(30)
SHEET 97 OF 152