
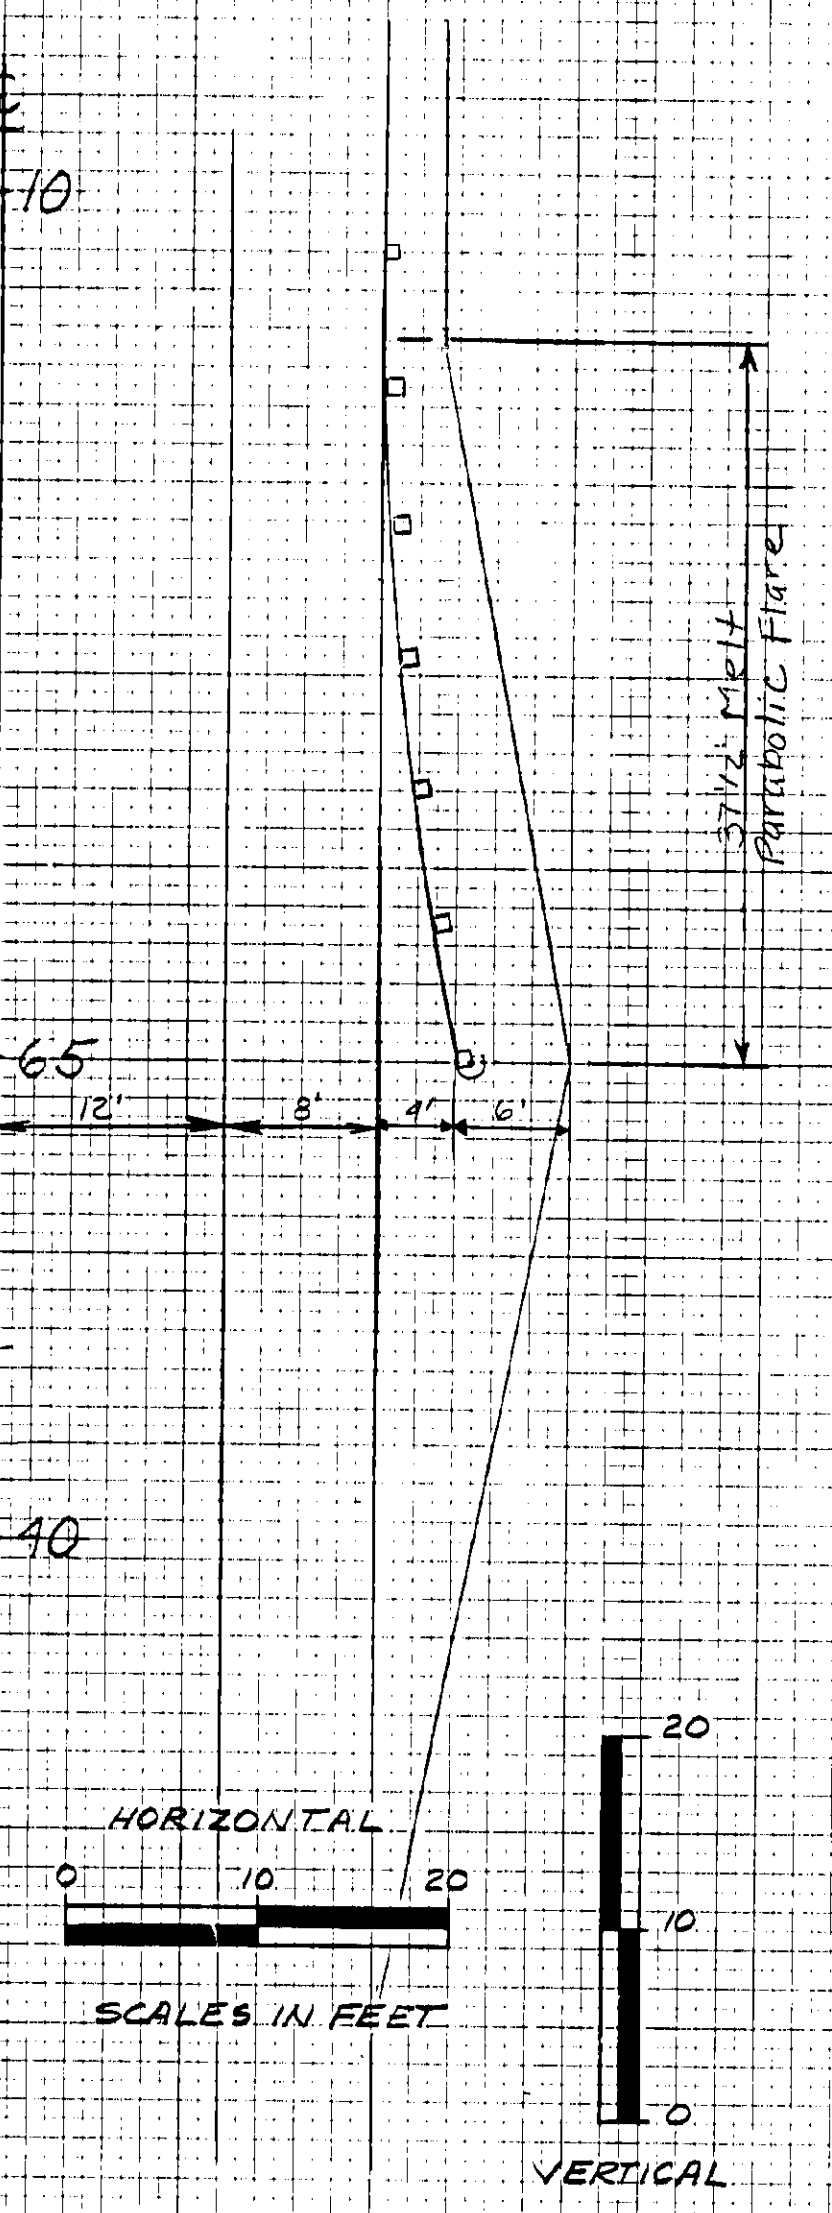


DATE	
BY	
DESIGNED	
CHECKED	
PLOTTED	
DATE	
NO.	

DATE	
BY	
DESIGNED	
CHECKED	
PLOTTED	
DATE	
NO.	

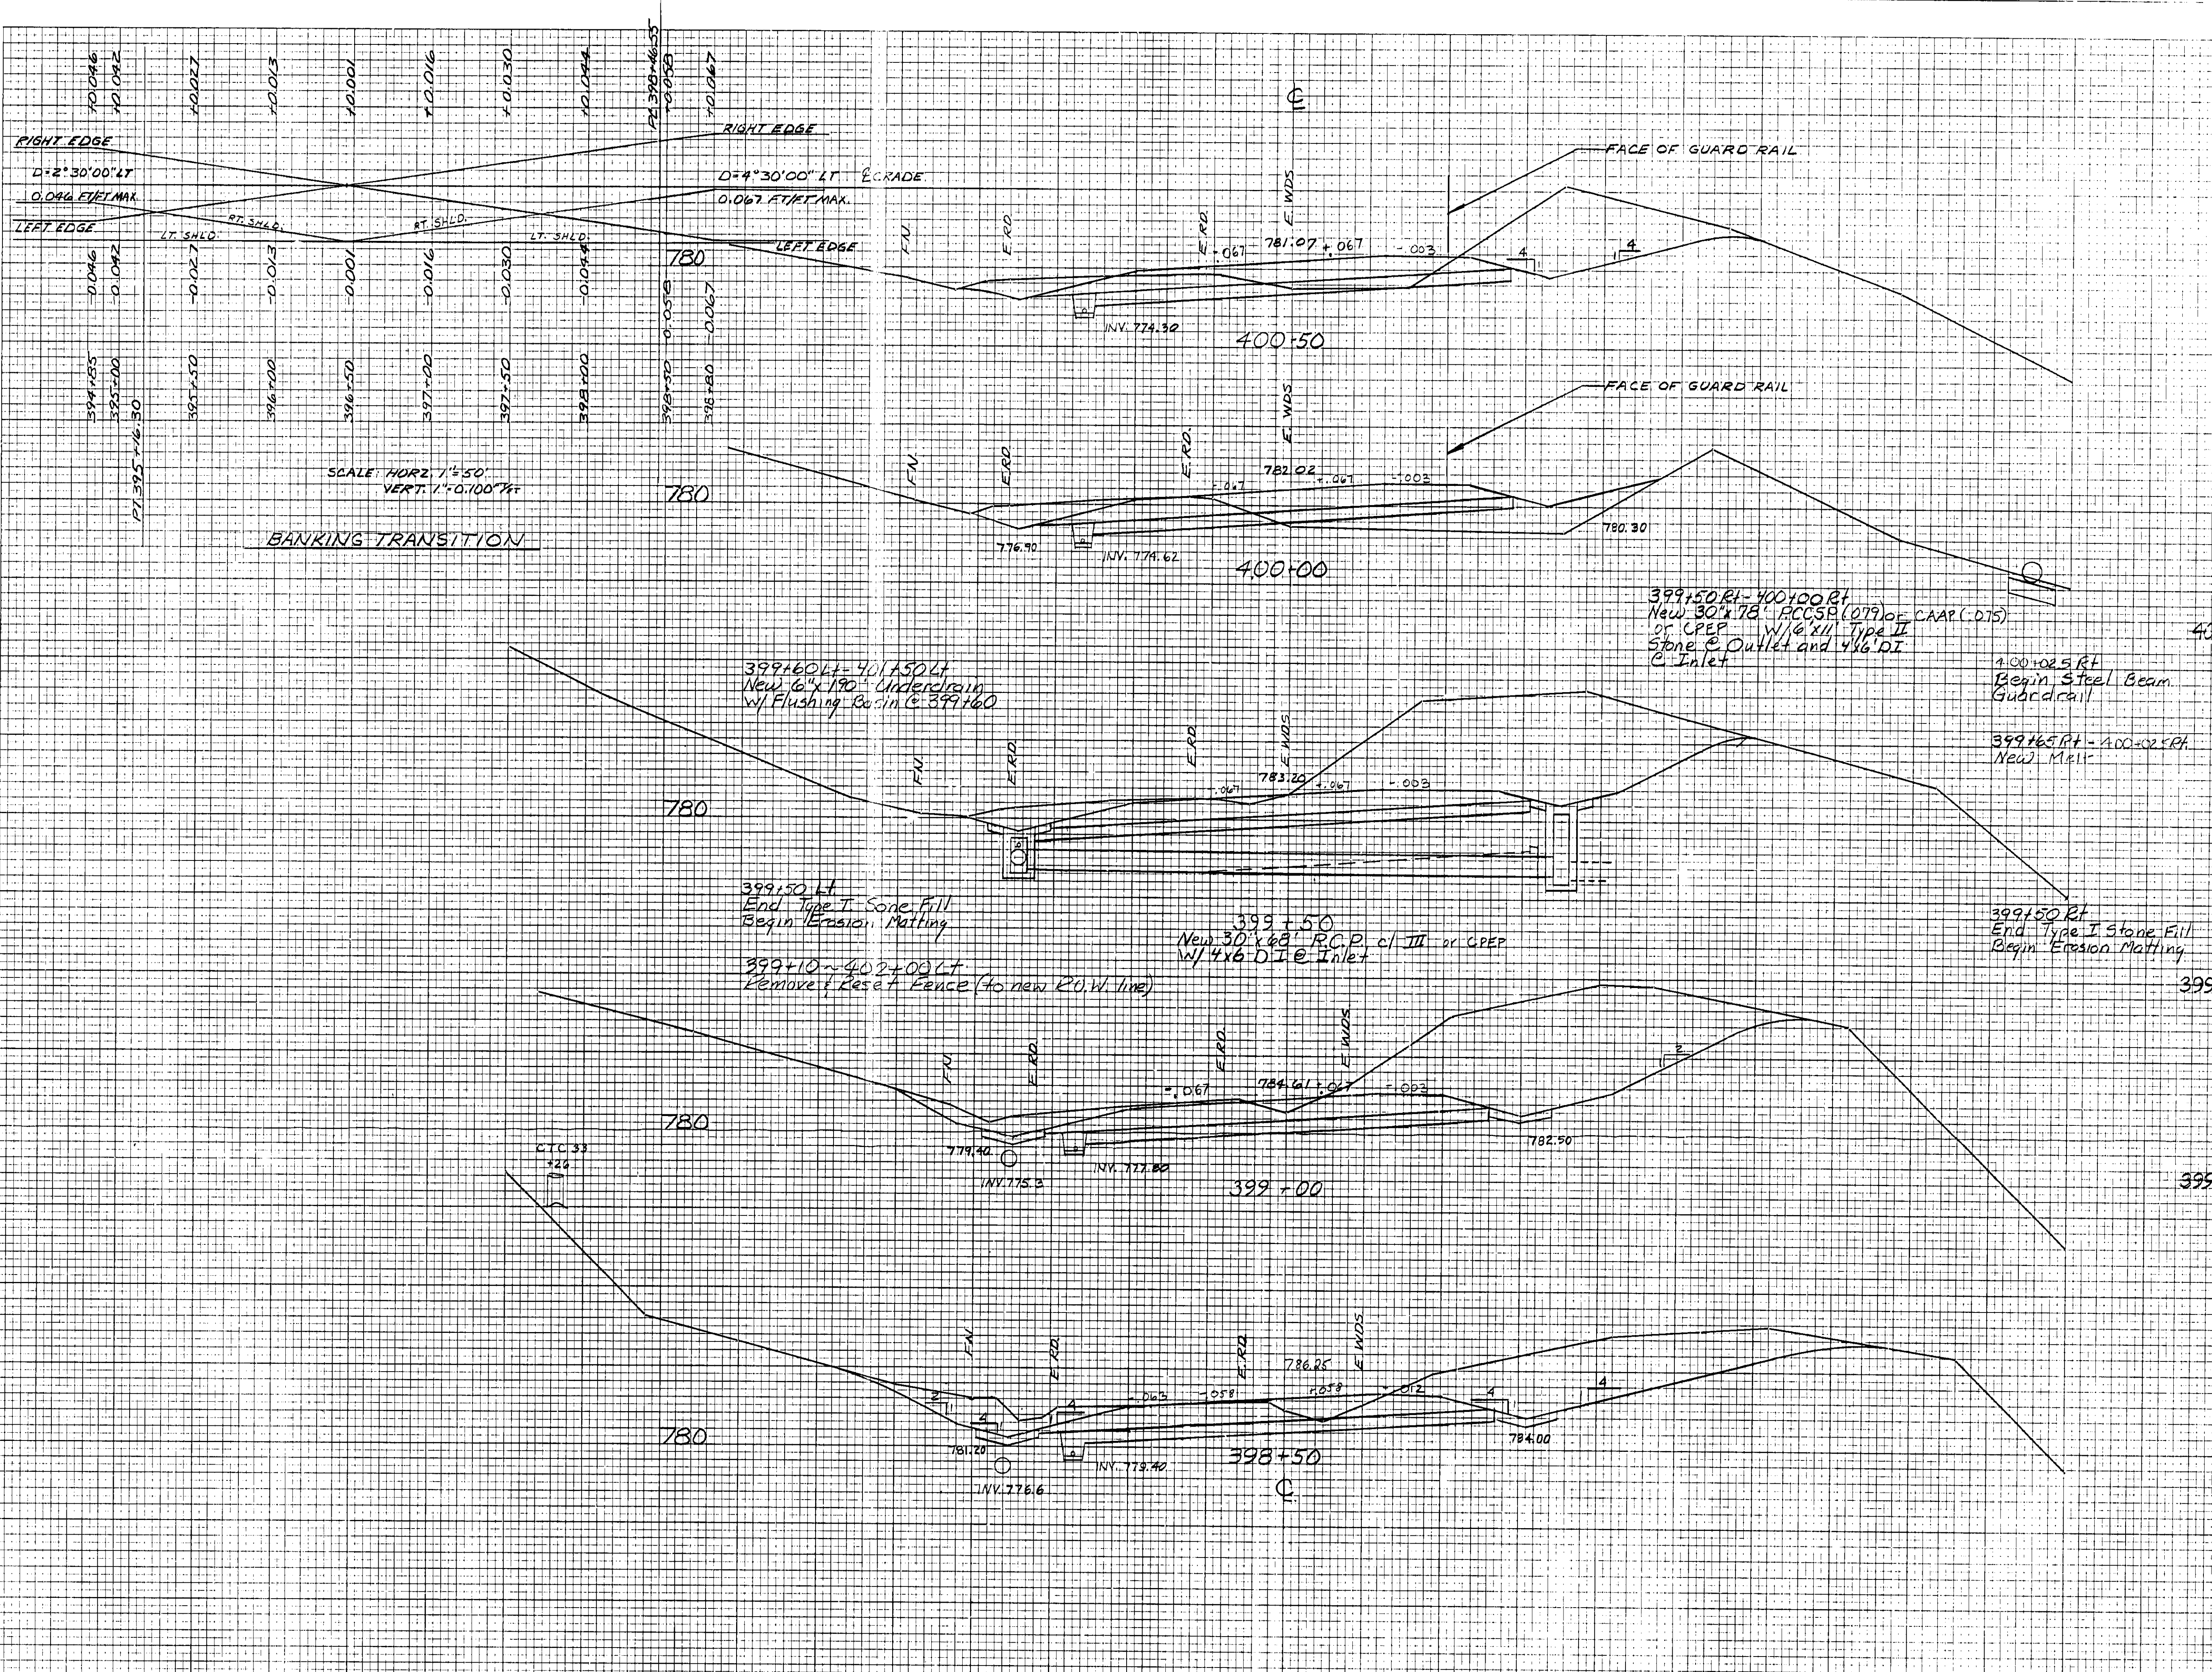

CROSS SECTIONS  
 STA 398+50 TO STA 400+50  
 GROTON - RYEGATE RD 26-71(30)  
 SHEET 98 OF 152