
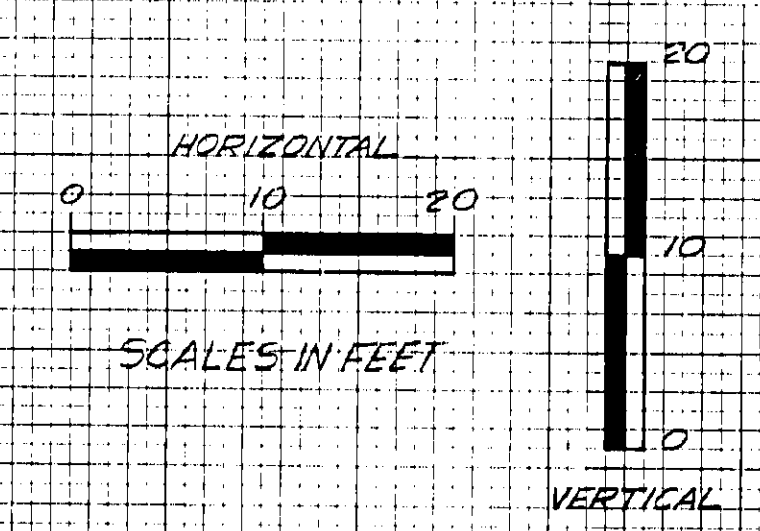


FINAL SURVEY	DATE
NOTE BOOK	BY
NO. 47153	
AREAS CHECKED	

ORIGINAL SURVEY	DATE
NOTE BOOK	BY
NO. 47153	
AREAS CHECKED	

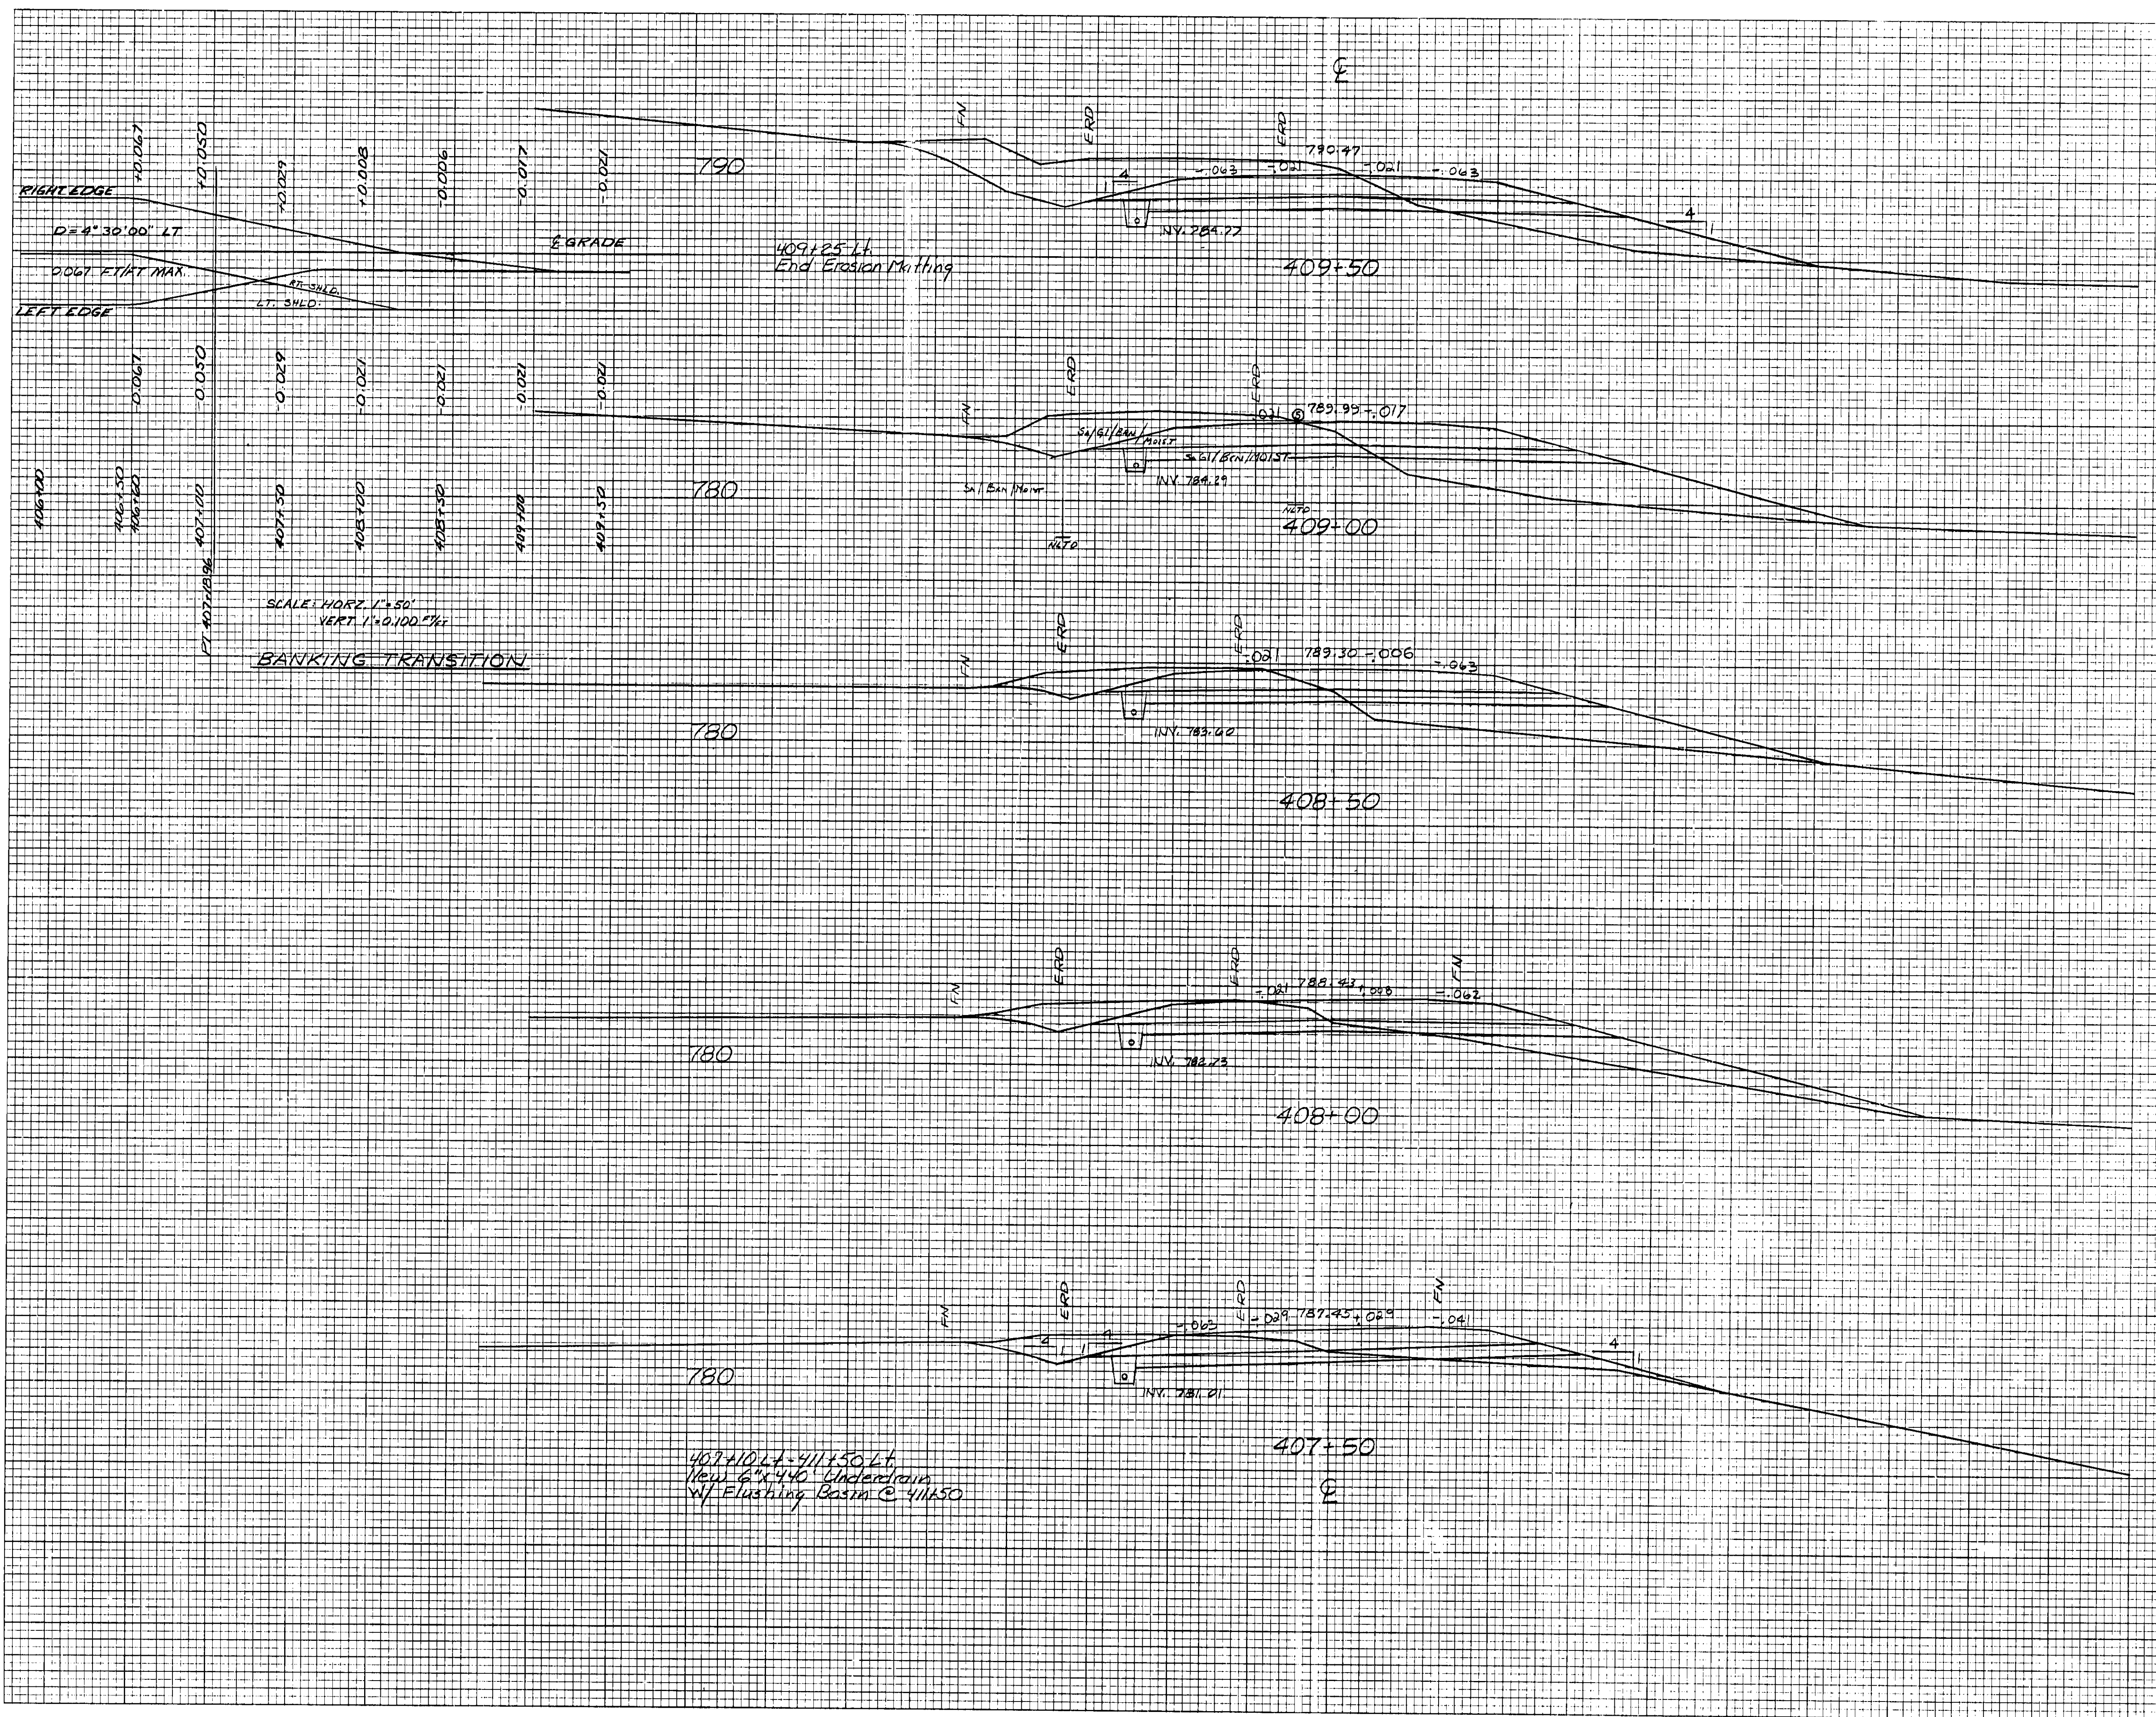

CROSS SECTIONS
 STA. 407+50 TO STA. 409+50
 GROTON-RYEGATE JCT. 1026-1730
 SHEET 102 OF 152