
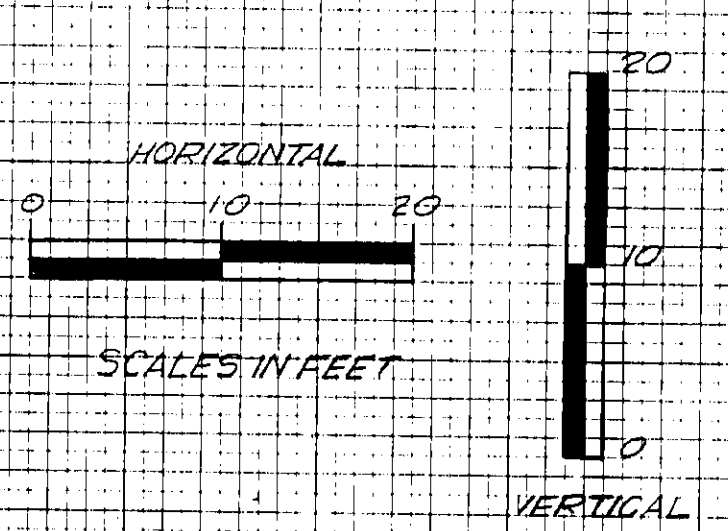


DATE	
BY	
SURVEYED	
PLOTTED	
TRIMMED	
AREAS CHECKED	
FINAL SURVEY NOTE BOOK No.	

DATE	DEC 26 1957
BY	E.L. GIBB
SURVEYED	
PLOTTED	
TRIMMED	
AREAS CHECKED	
FINAL SURVEY NOTE BOOK No.	427,457

44x20 G.L. Existing 18" R.C.P. Remove
 New 18x90" R.C.C.P. (1064) of cker. or
 (A.A.P.C. 1060) w/ Type I Stone @ Inlet and Outlet
 See Sheet 143 for details (End Section @ Inlet)

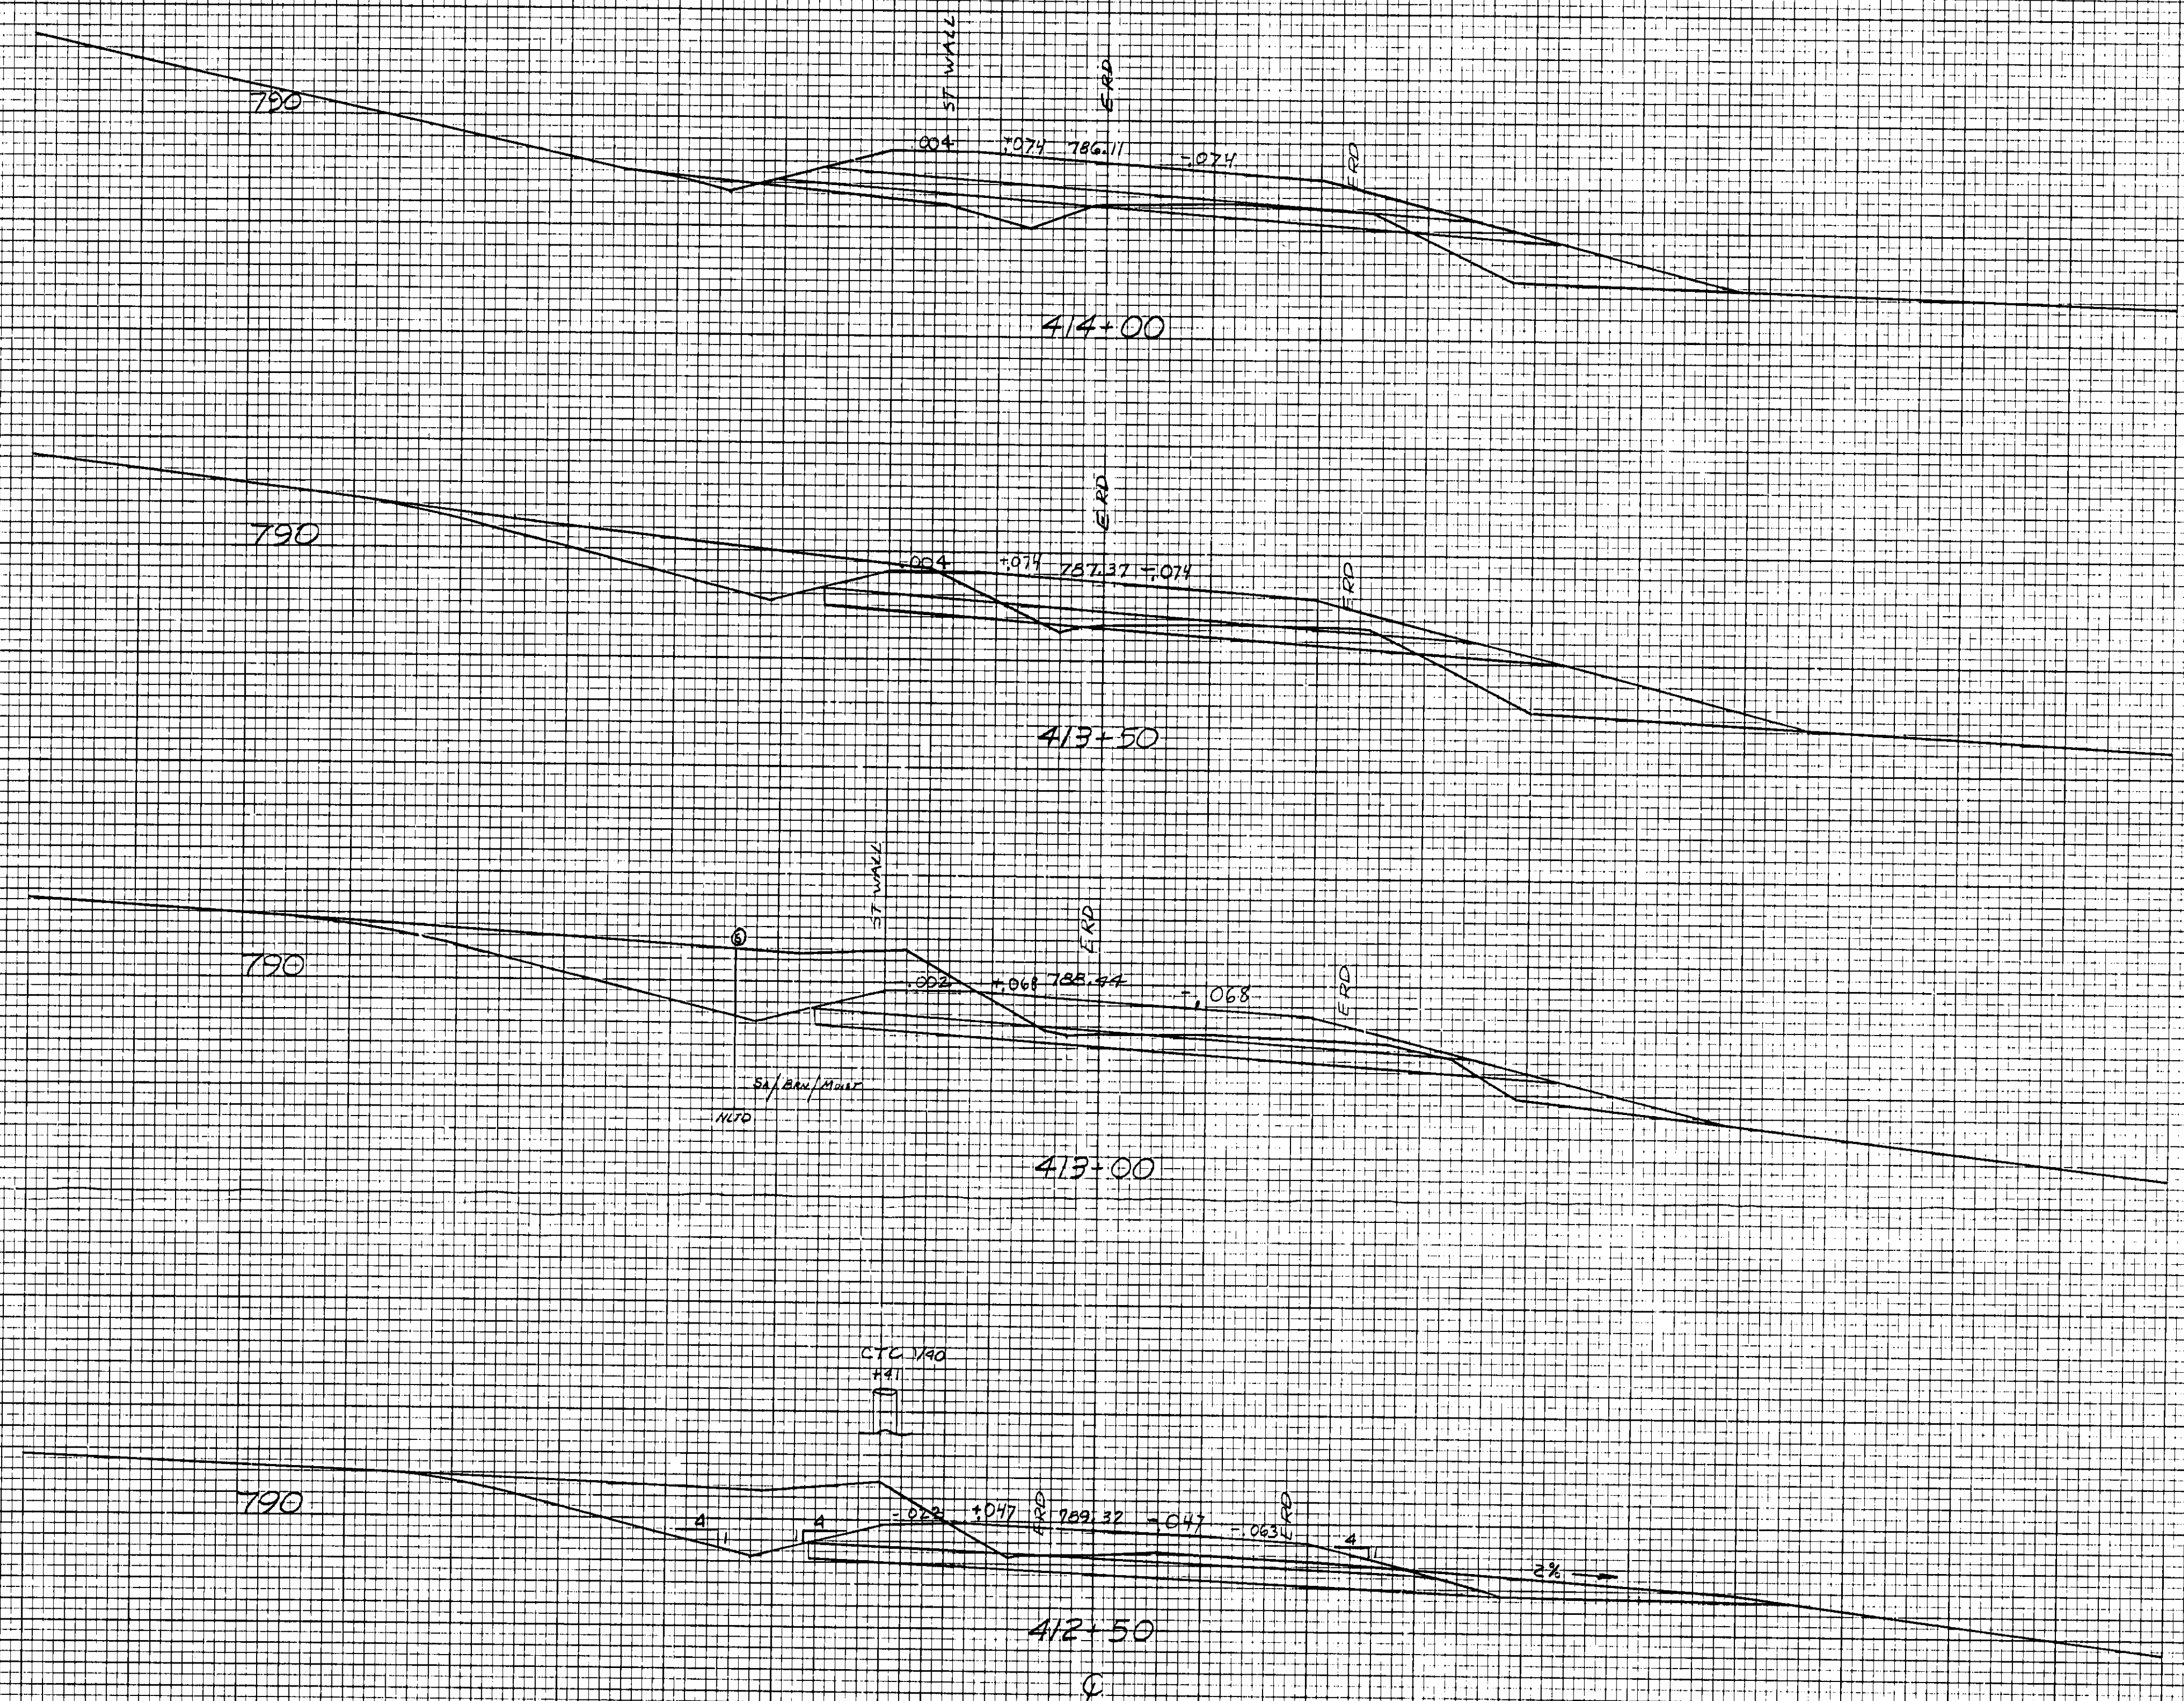

CROSS SECTIONS
 STA 412+50 TO STA 414+00
 GROTON-RYEGATE RD 267(130)
 SHEET 104 OF 152