
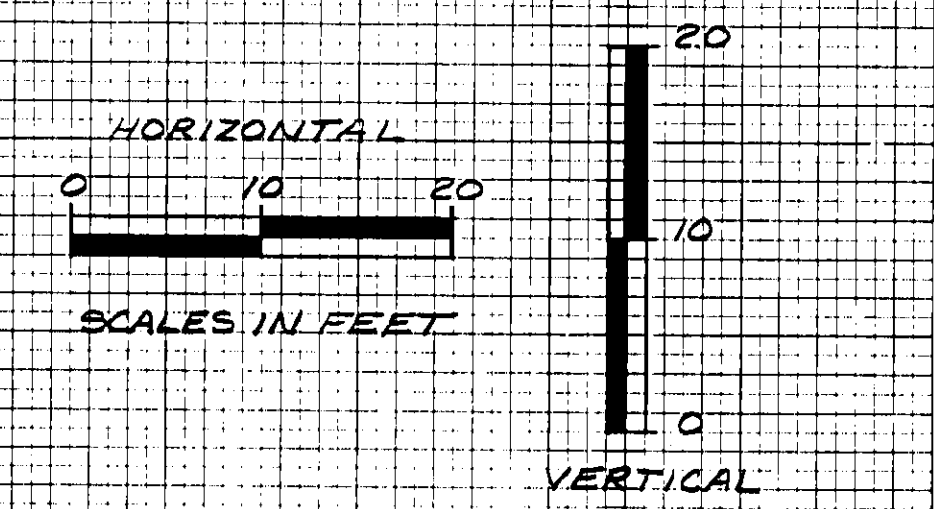
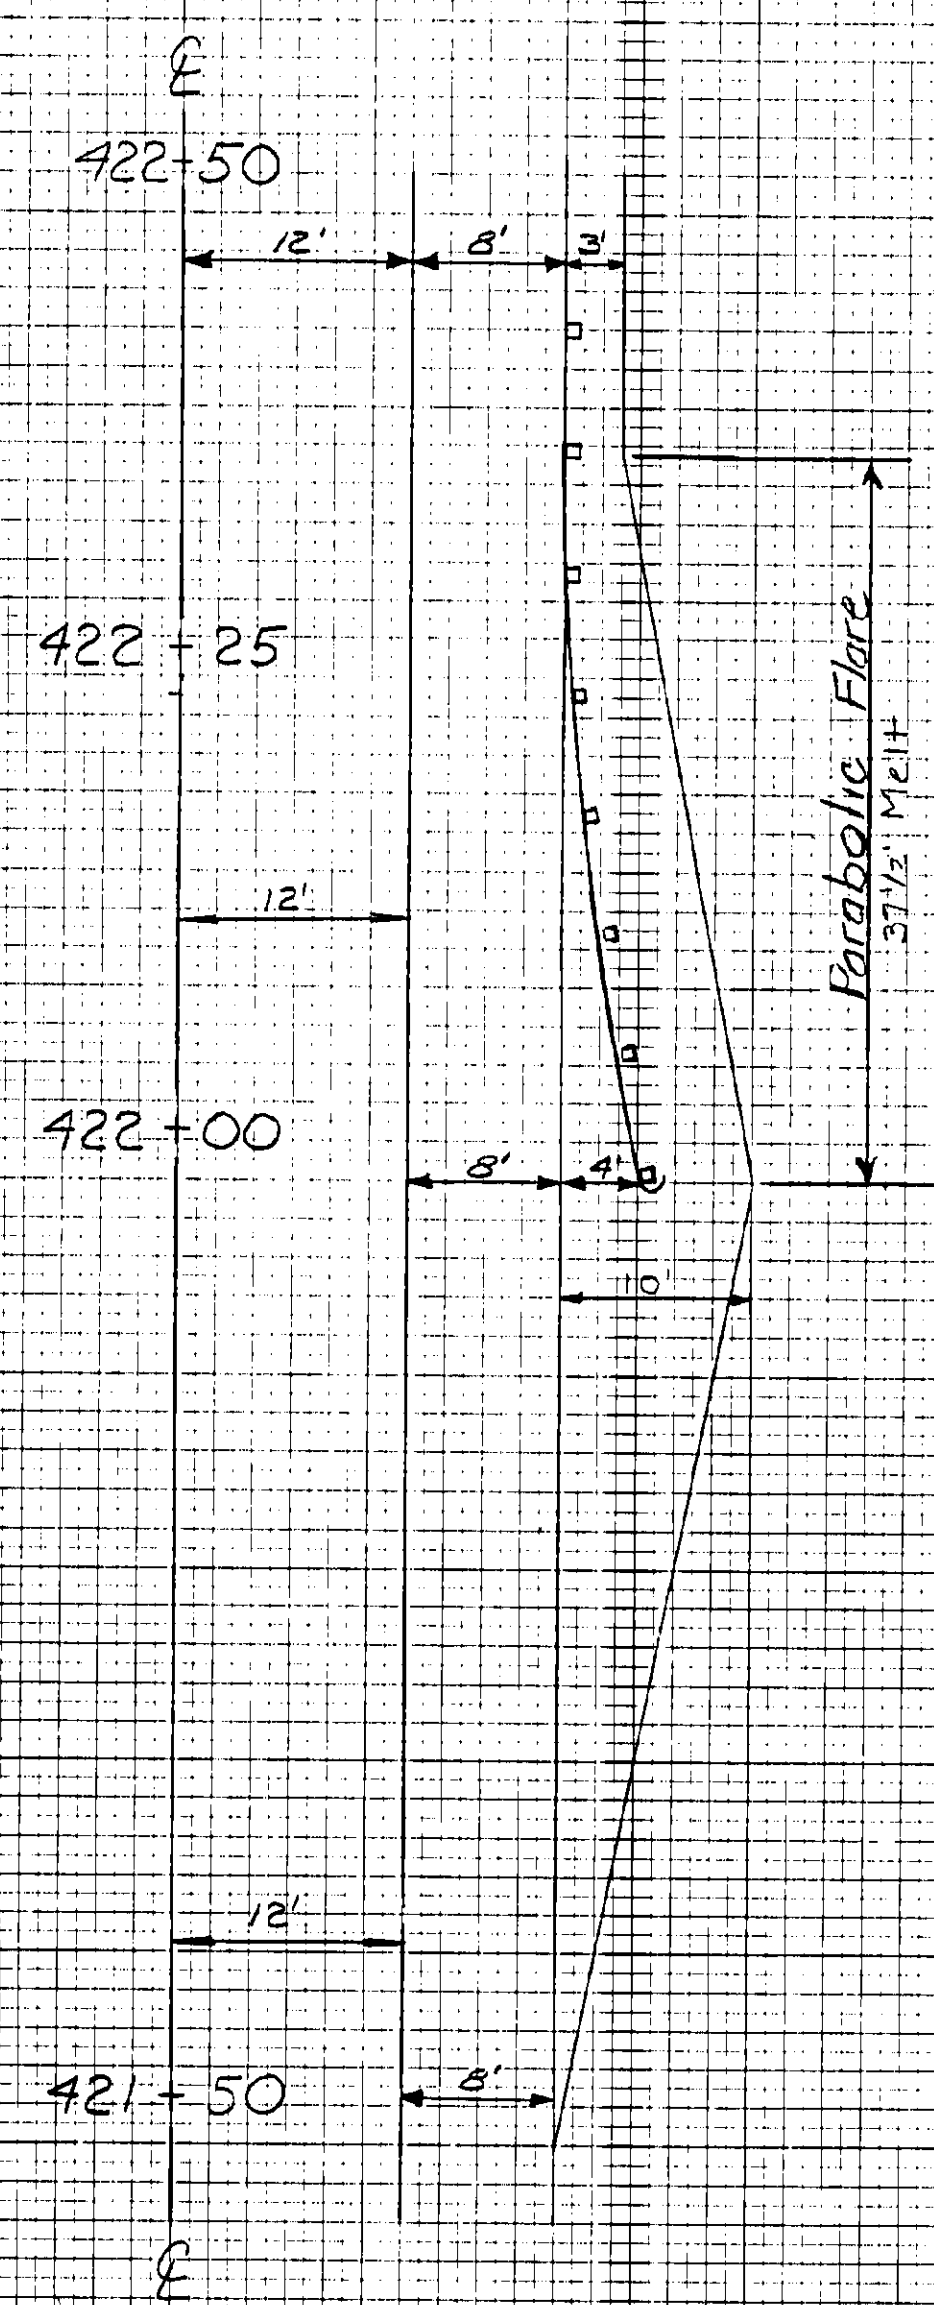


DATE	
BY	
DESIGNED	
PLOTTED	
NOTE BOOK	
NO.	
AREAS CHECKED	

DATE	DEC. 86
BY	ECG, ECG, GFE
DESIGNED	ECG, ECG, GFE
PLOTTED	ECG, ECG, GFE
NOTE BOOK	
NO.	
AREAS CHECKED	

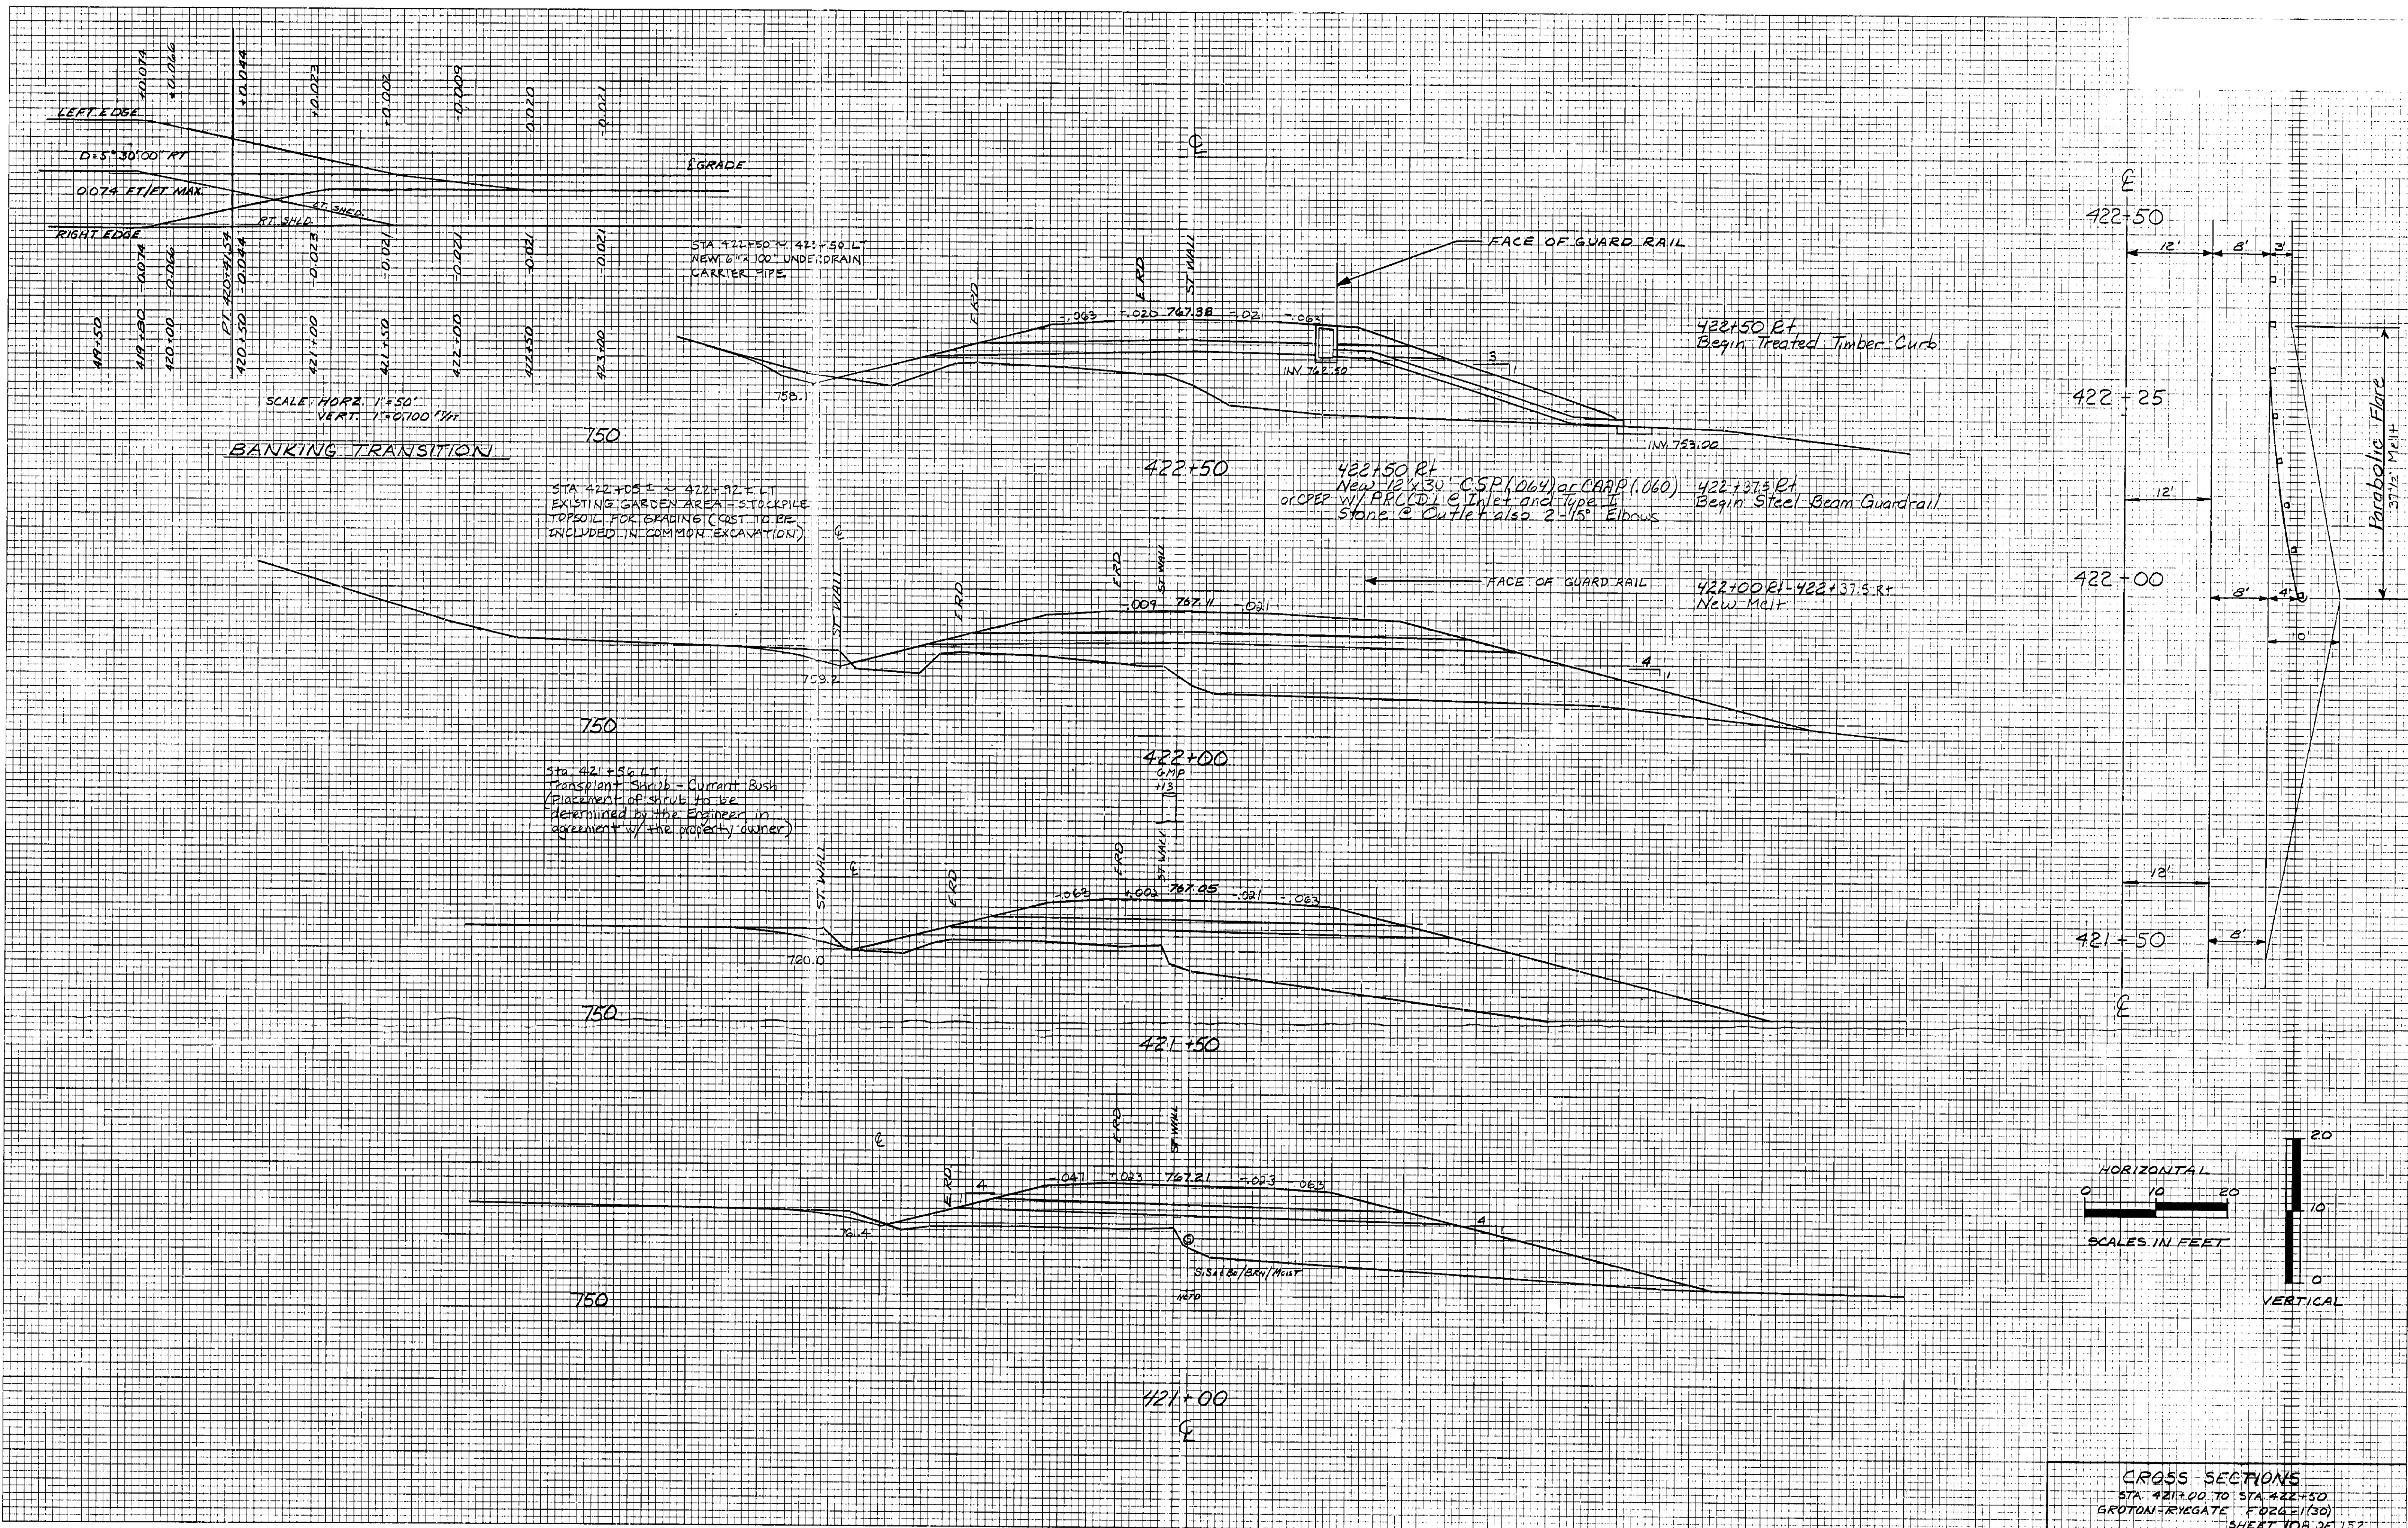

CROSS SECTIONS
STA 421+00 TO STA 422+50
GROTON RYEGATE FORG=1(30)
SHEET 108 OF 152