
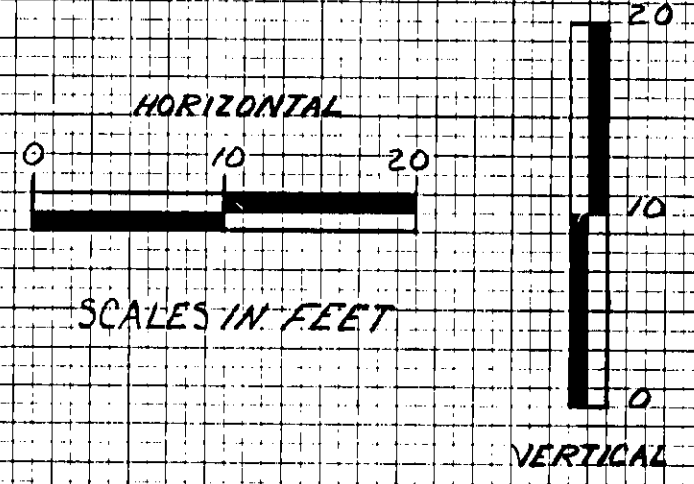


FINAL SURVEY	SURVEYED	DATE
	PLOTTED	
NOTE BOOK	BY	
	NO.	
	APPROVED	
	DATE	

ORIGINAL SURVEY	SURVEYED	DATE
	PLOTTED	
NOTE BOOK	BY	
	NO.	
	APPROVED	
	DATE	

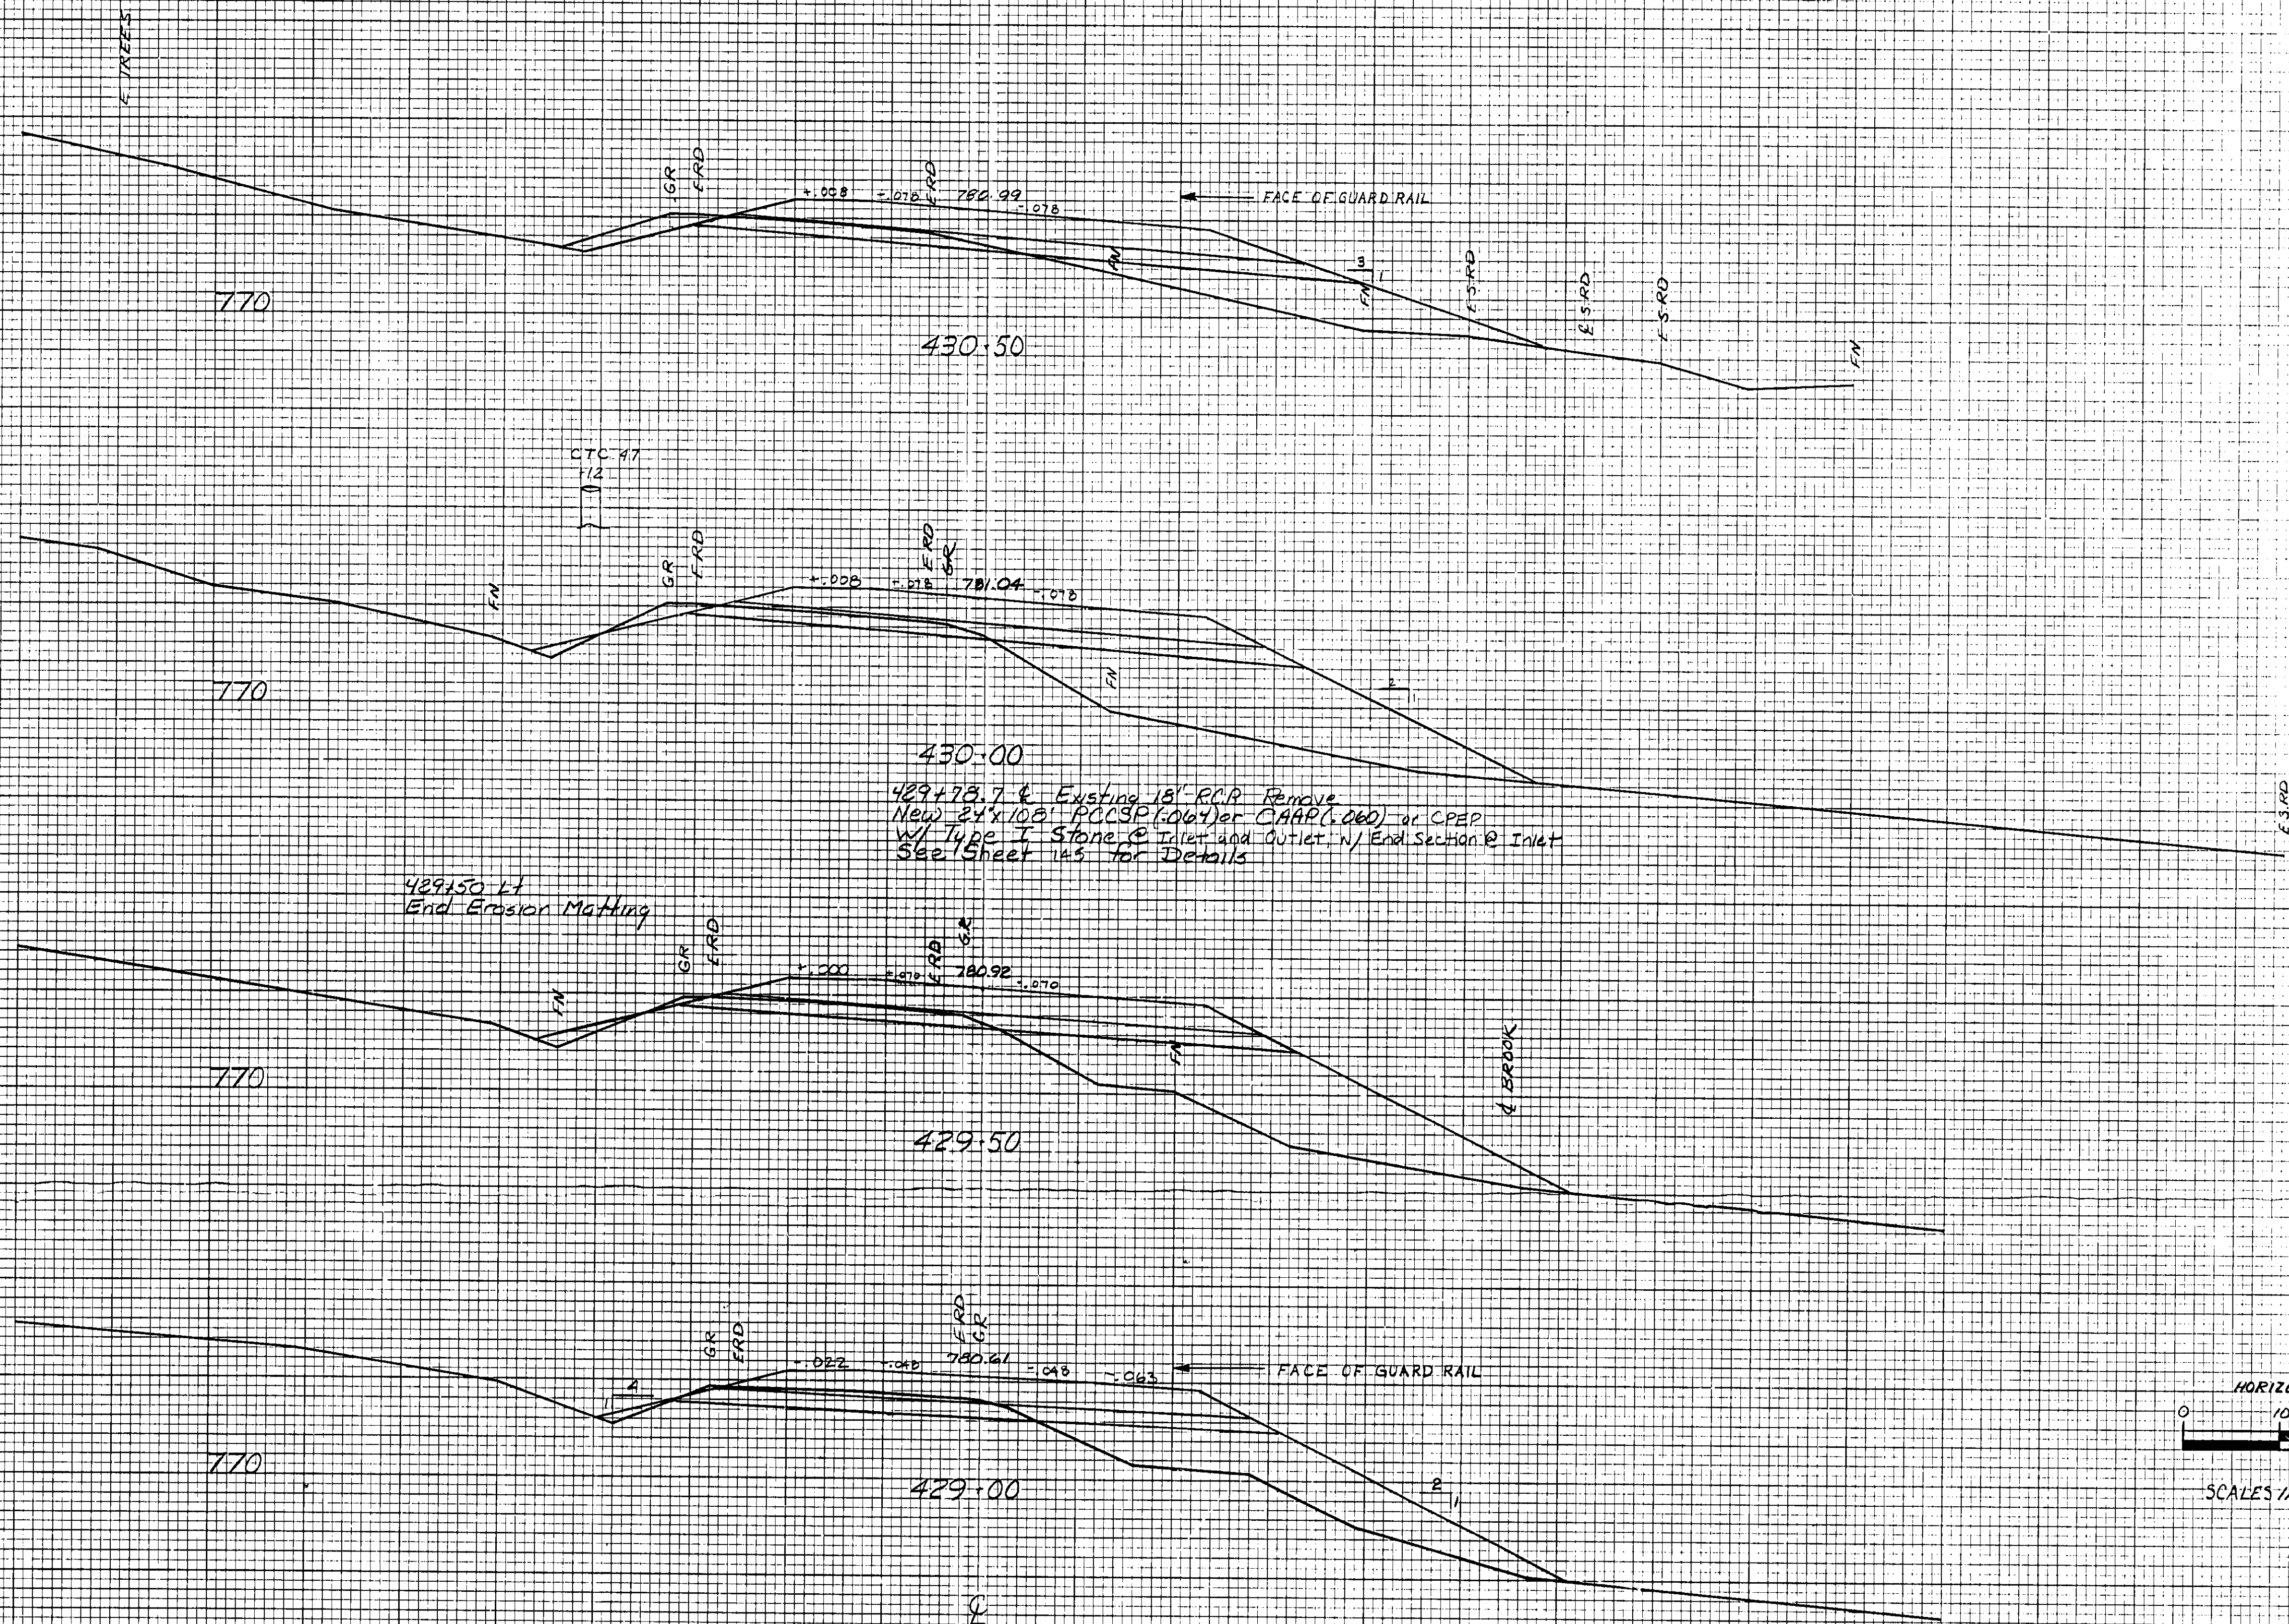

CROSS SECTIONS  
 STA 429+00 TO STA 430+50  
 GROTON BYEGATE F026=1/30  
 SHEET 112 OF 152