
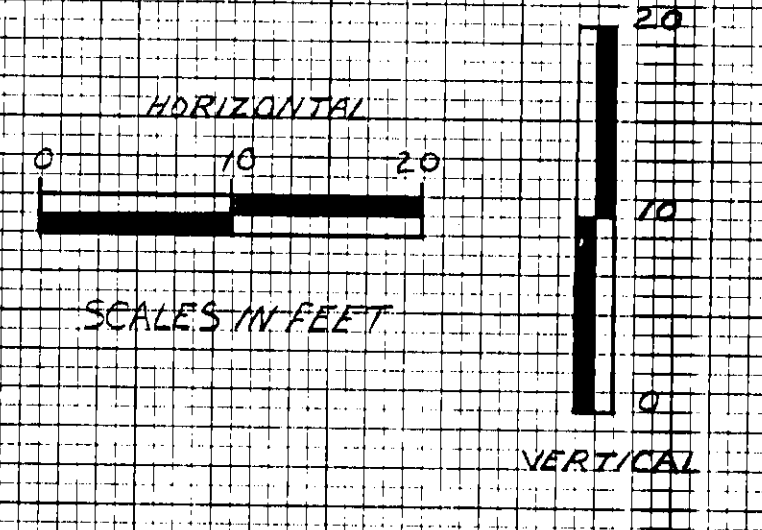


DATE: _____
 BY: _____
 CHECKED: _____
 DATE: _____
 NO. _____

DATE: _____
 BY: _____
 CHECKED: _____
 DATE: _____
 NO. _____

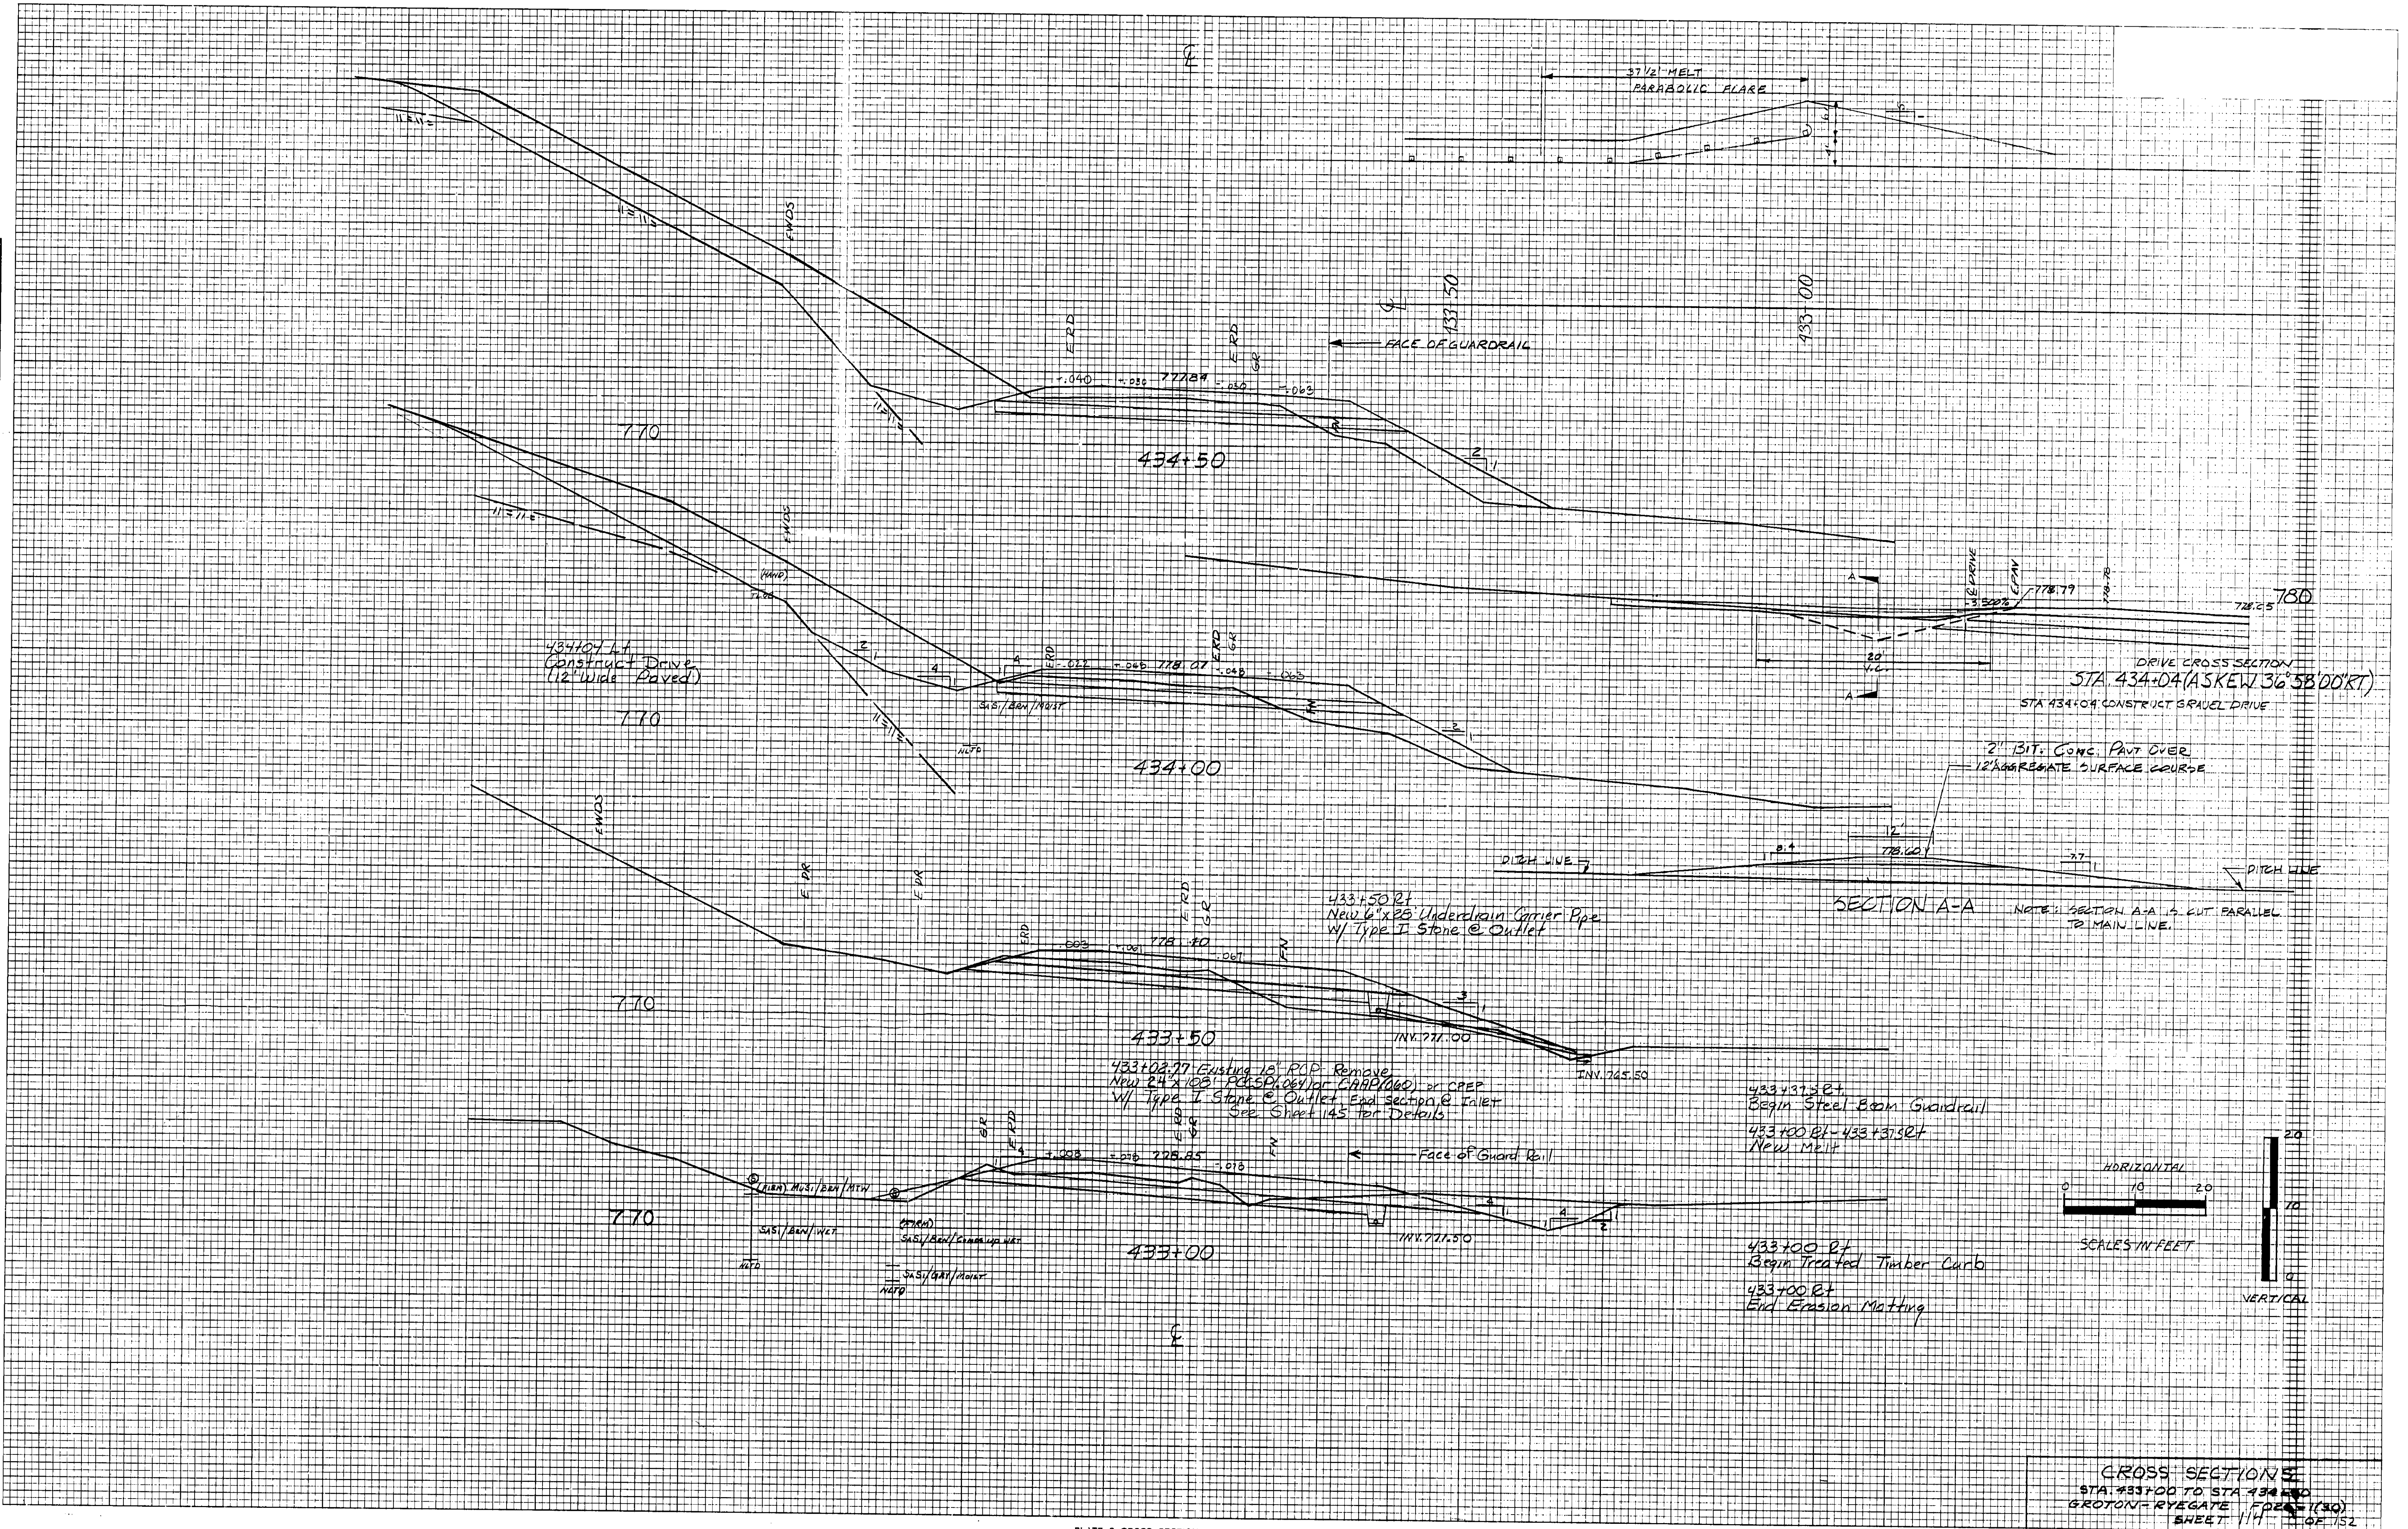

CROSS SECTION E
 STA. 433+00 TO STA. 434+50
 GROTON-RYEGATE ROAD (130)
 SHEET 111 OF 152