
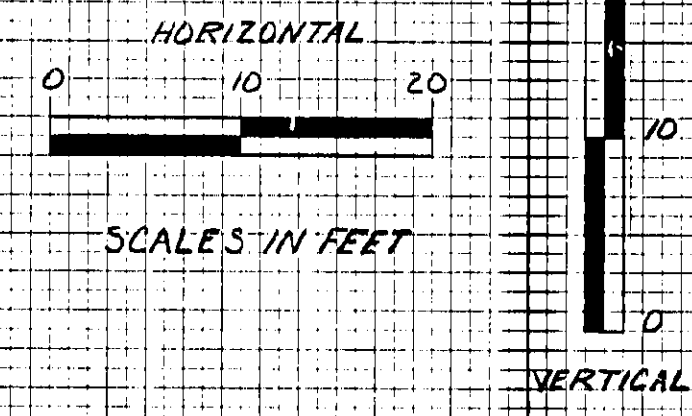


FINAL SURVEY NOTE BOOK NO.	SURVEYED	DATE
	PLOTTED	BY
	TEMPERATURE	
	AREAS CHECKED	

ORIGINAL SURVEY NOTE BOOK NO.	SURVEYED	DATE	DEC. 88
			APR. 89
			APR. 89
			SEPT. 90
			SEPT. 90
			SEPT. 90

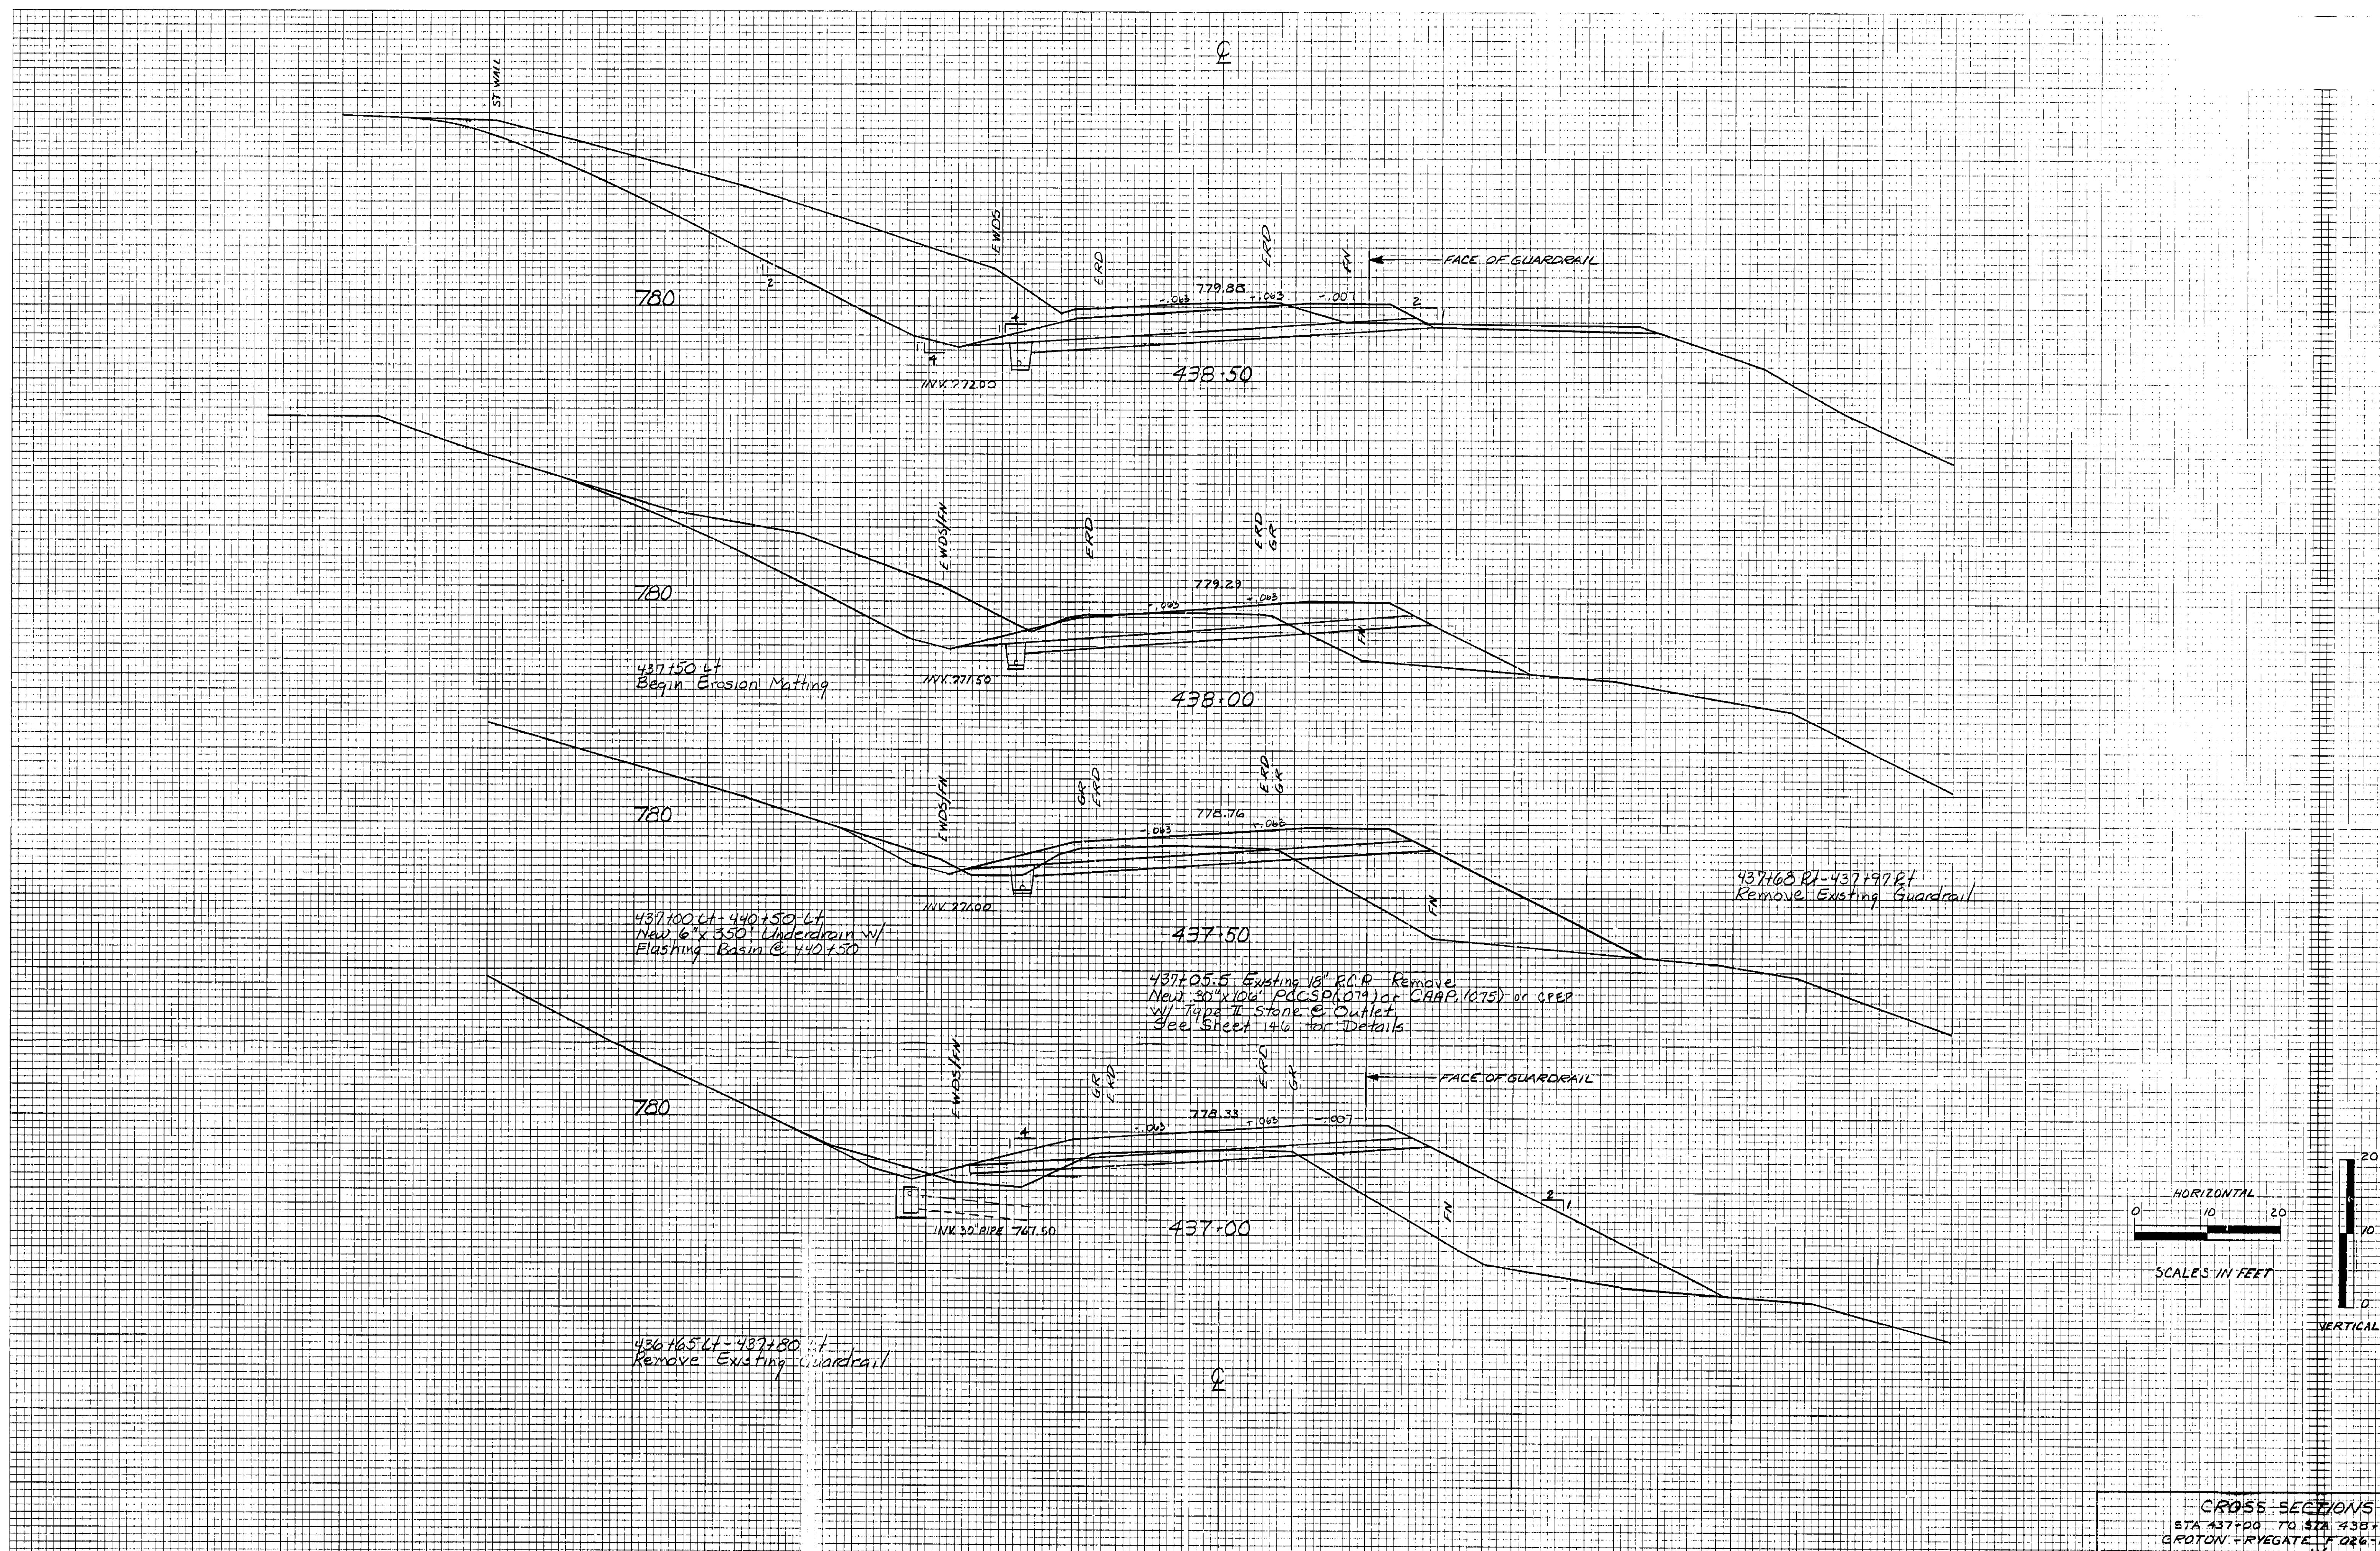

CROSS SECTIONS  
STA 437+00 TO STA 438+50  
GROTON - RYEGATE, F.D. 26-1(30)  
SHEET 116 OF 152