
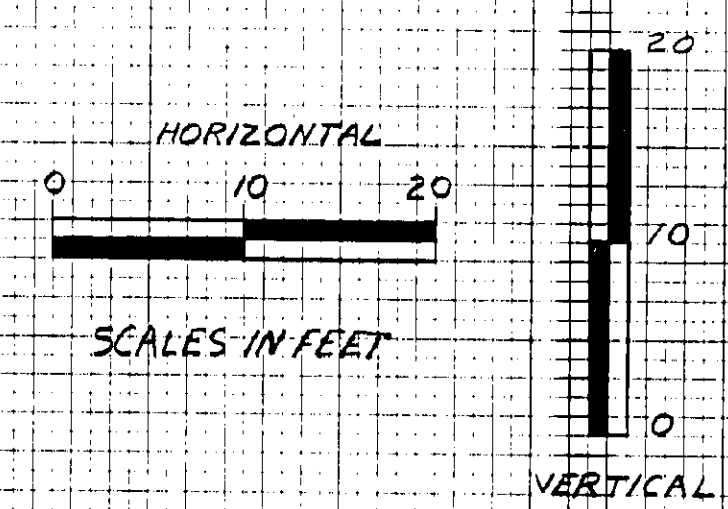


DATE	
BY	
DESIGNED	
PLOTTED	
NOTE BOOK	
NO.	
AREA CHECKED	

DATE	
BY	
DESIGNED	
PLOTTED	
NOTE BOOK	
NO.	
AREA CHECKED	

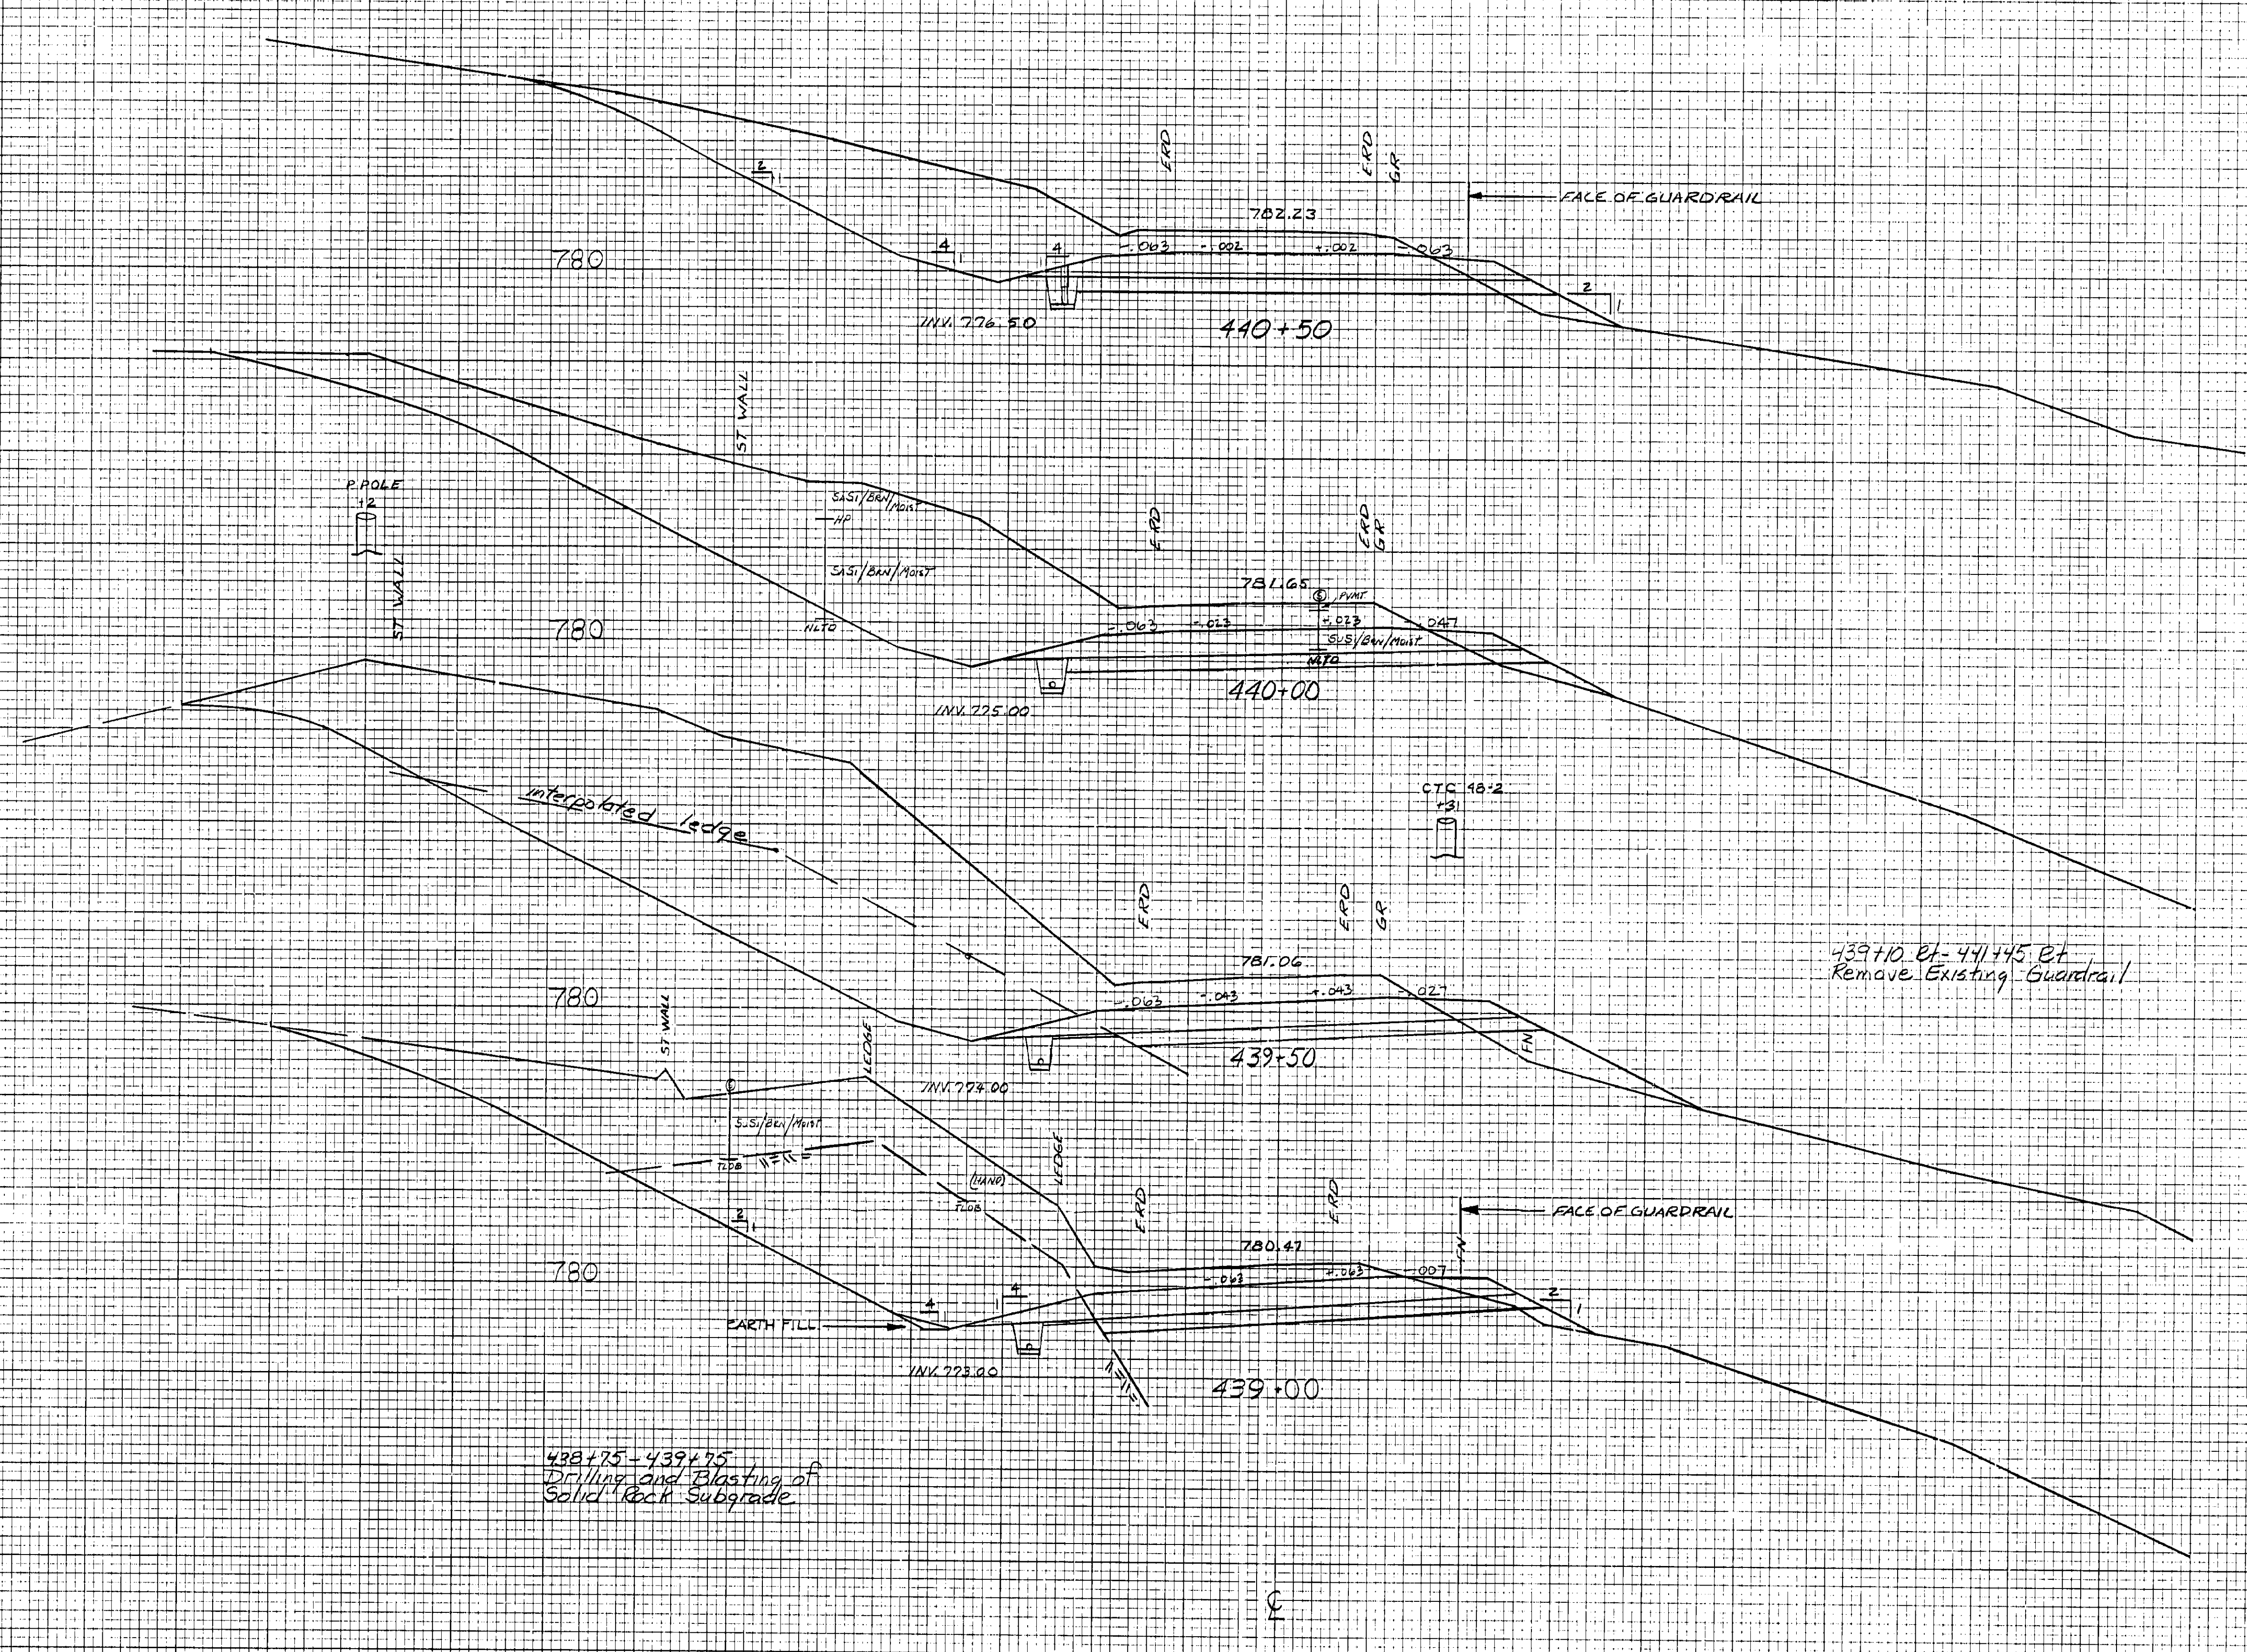

CROSS SECTIONS  
 STA 439+00 TO STA 440+50  
 GROTON - RYE GATE RD 26-1(30)  
 SHEET 117 OF 152