
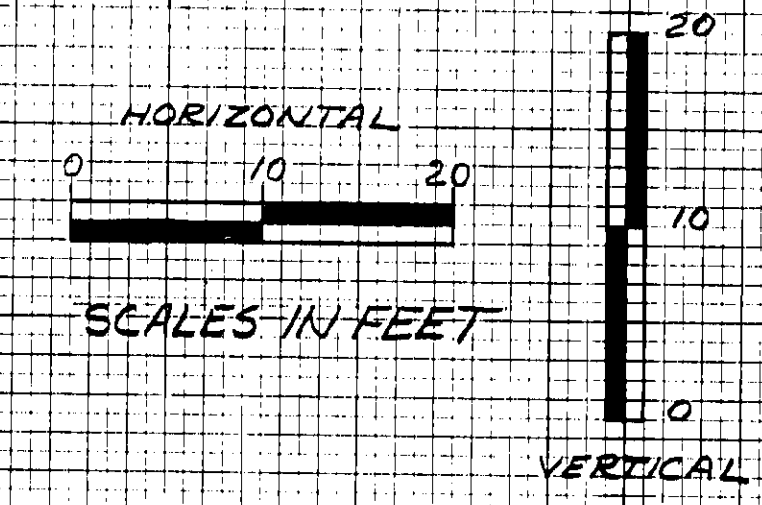
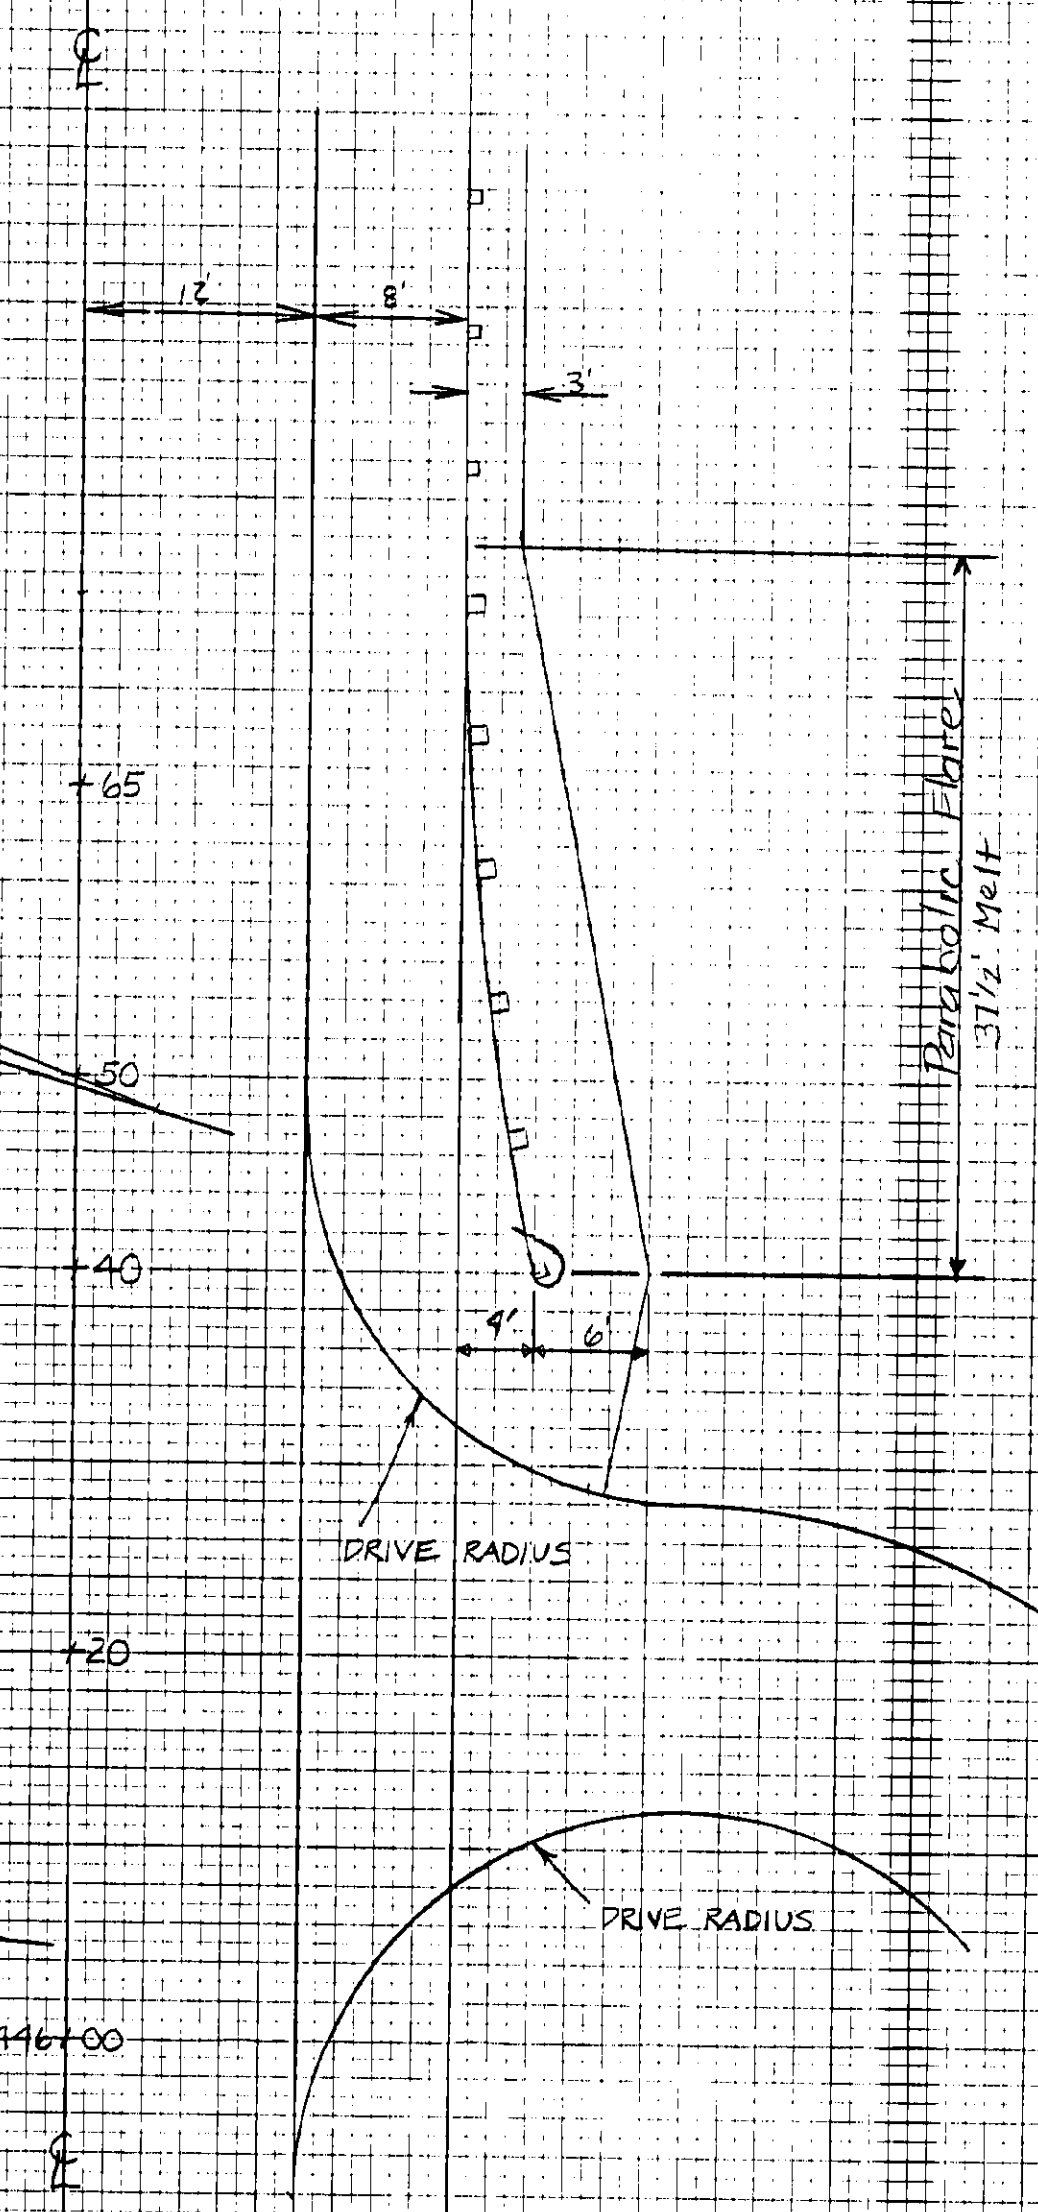


DATE	BY	SURVEYED	PLOTTED	INSTRUMENT	SCALE	AREAS CHECKED
FINAL SURVEY	NOTE BOOK	No.				

DATE	BY	SURVEYED	PLOTTED	INSTRUMENT	SCALE	AREAS CHECKED
DEC 86	EC	APR 87	APR 87			
JAN 90	CAF	SEP 90				
ORIGINAL SURVEY	NOTE BOOK	No.				

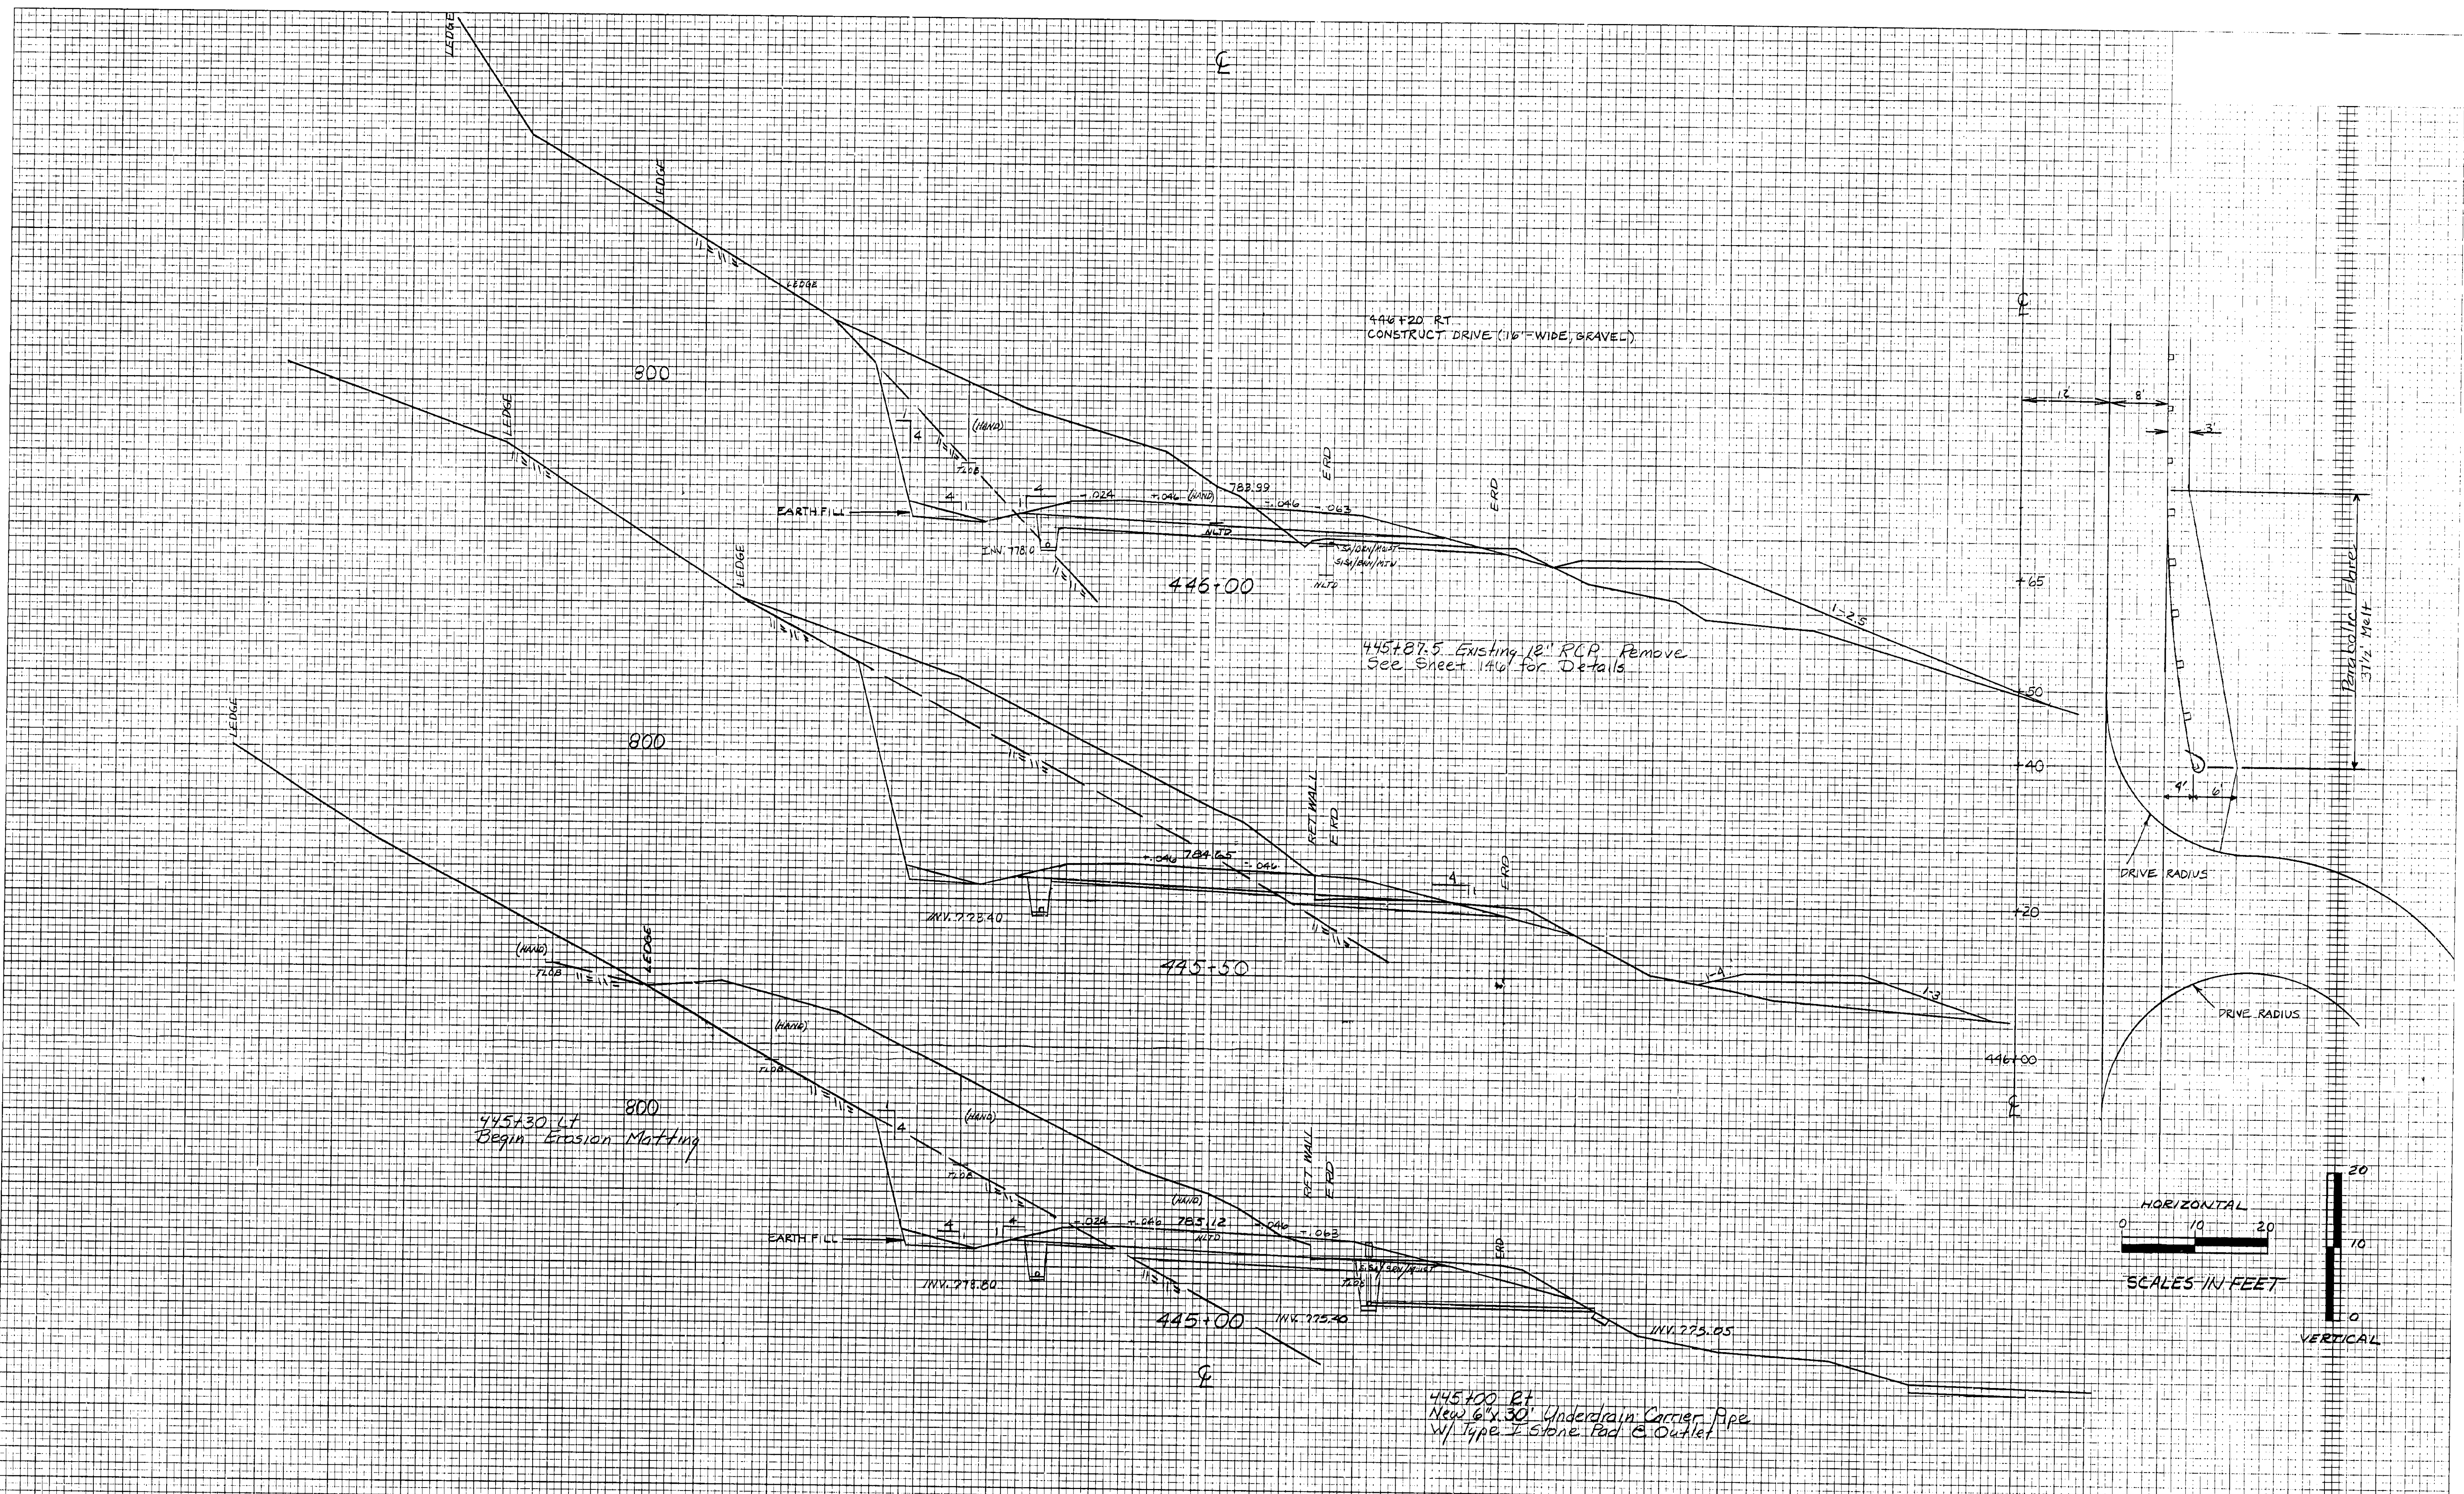

CROSS SECTIONS
 STA 445+00 TO STA 446+00
 GROTON - RYEKATE F.D. 26-1(30)
 SHEET 120 OF 152