
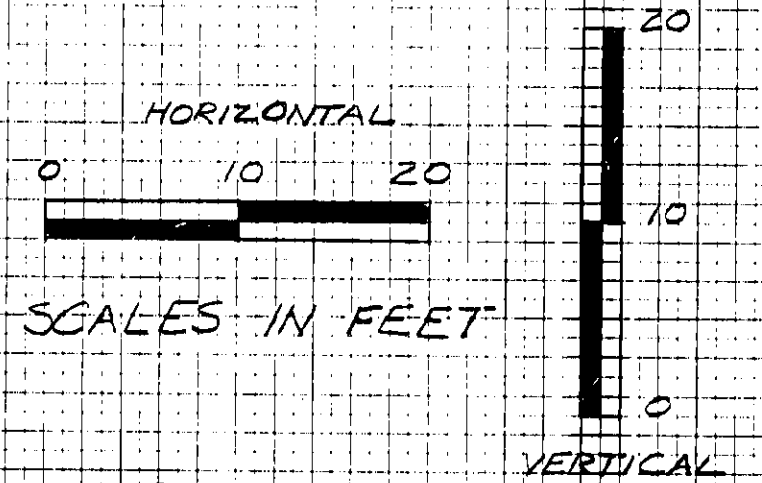


DATE _____
 BY _____
 CHECKED _____
 DATE _____
 BY _____
 CHECKED _____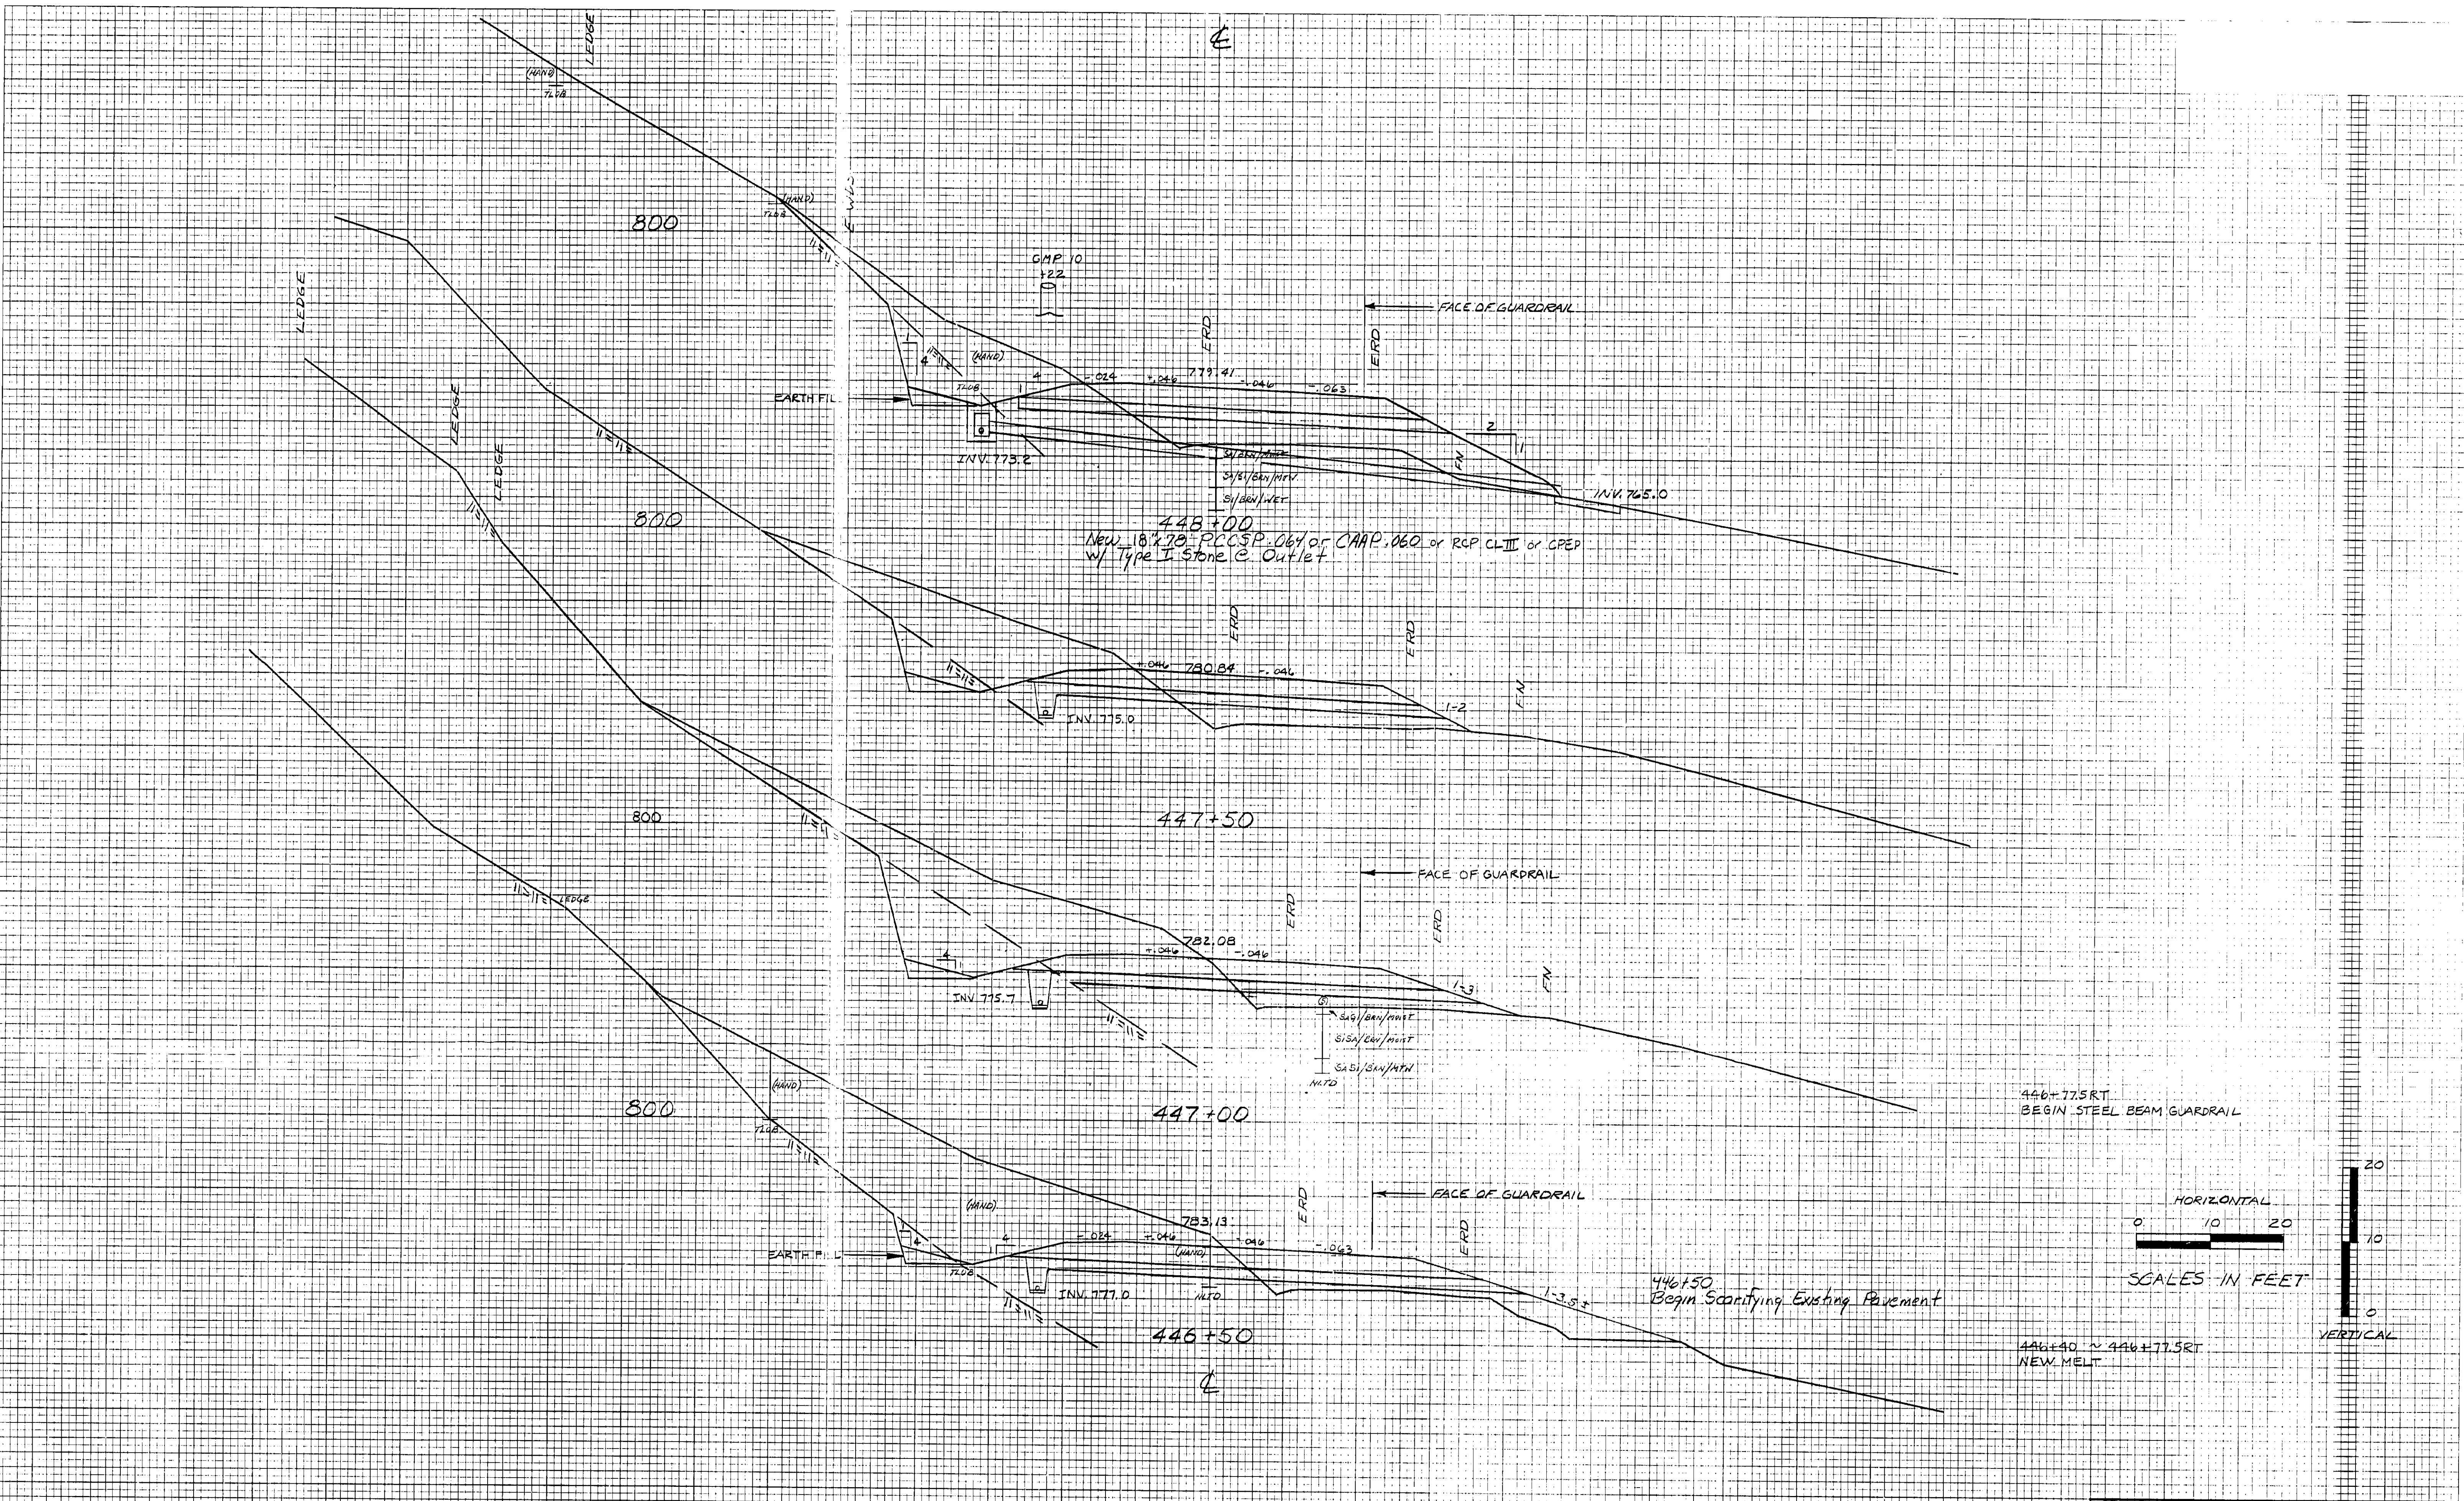
CROSS SECTIONS
 STA. 446+50 TO STA. 448+00
 GTON-RYEGATE A 026-1130
 SHEET 12.2A 152