
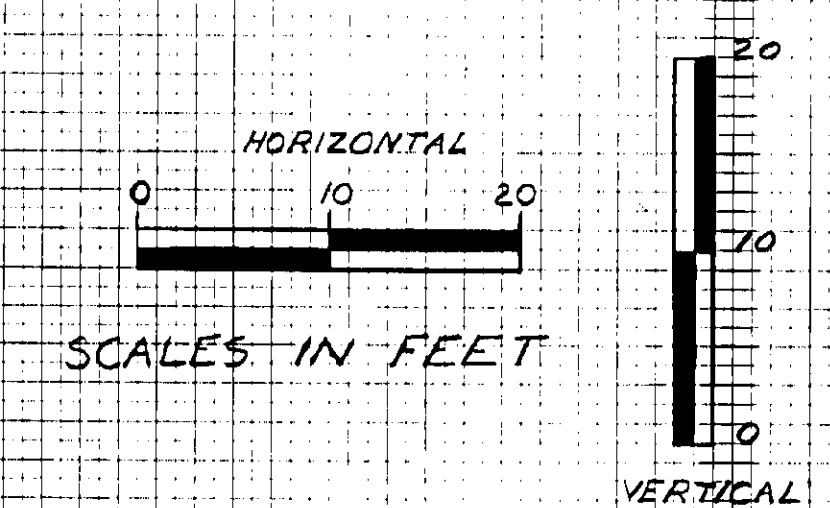


DATE	
BY	
SURVEYED	
TRIP/PLAT	
AREA	
AMOUNT CHECKED	
NO.	
FINAL SURVEY	
NOTE BOOK	

DATE	
BY	
SURVEYED	
TRIP/PLAT	
AREA	
AMOUNT CHECKED	
NO.	
ORIGINAL SURVEY	
NOTE BOOK	

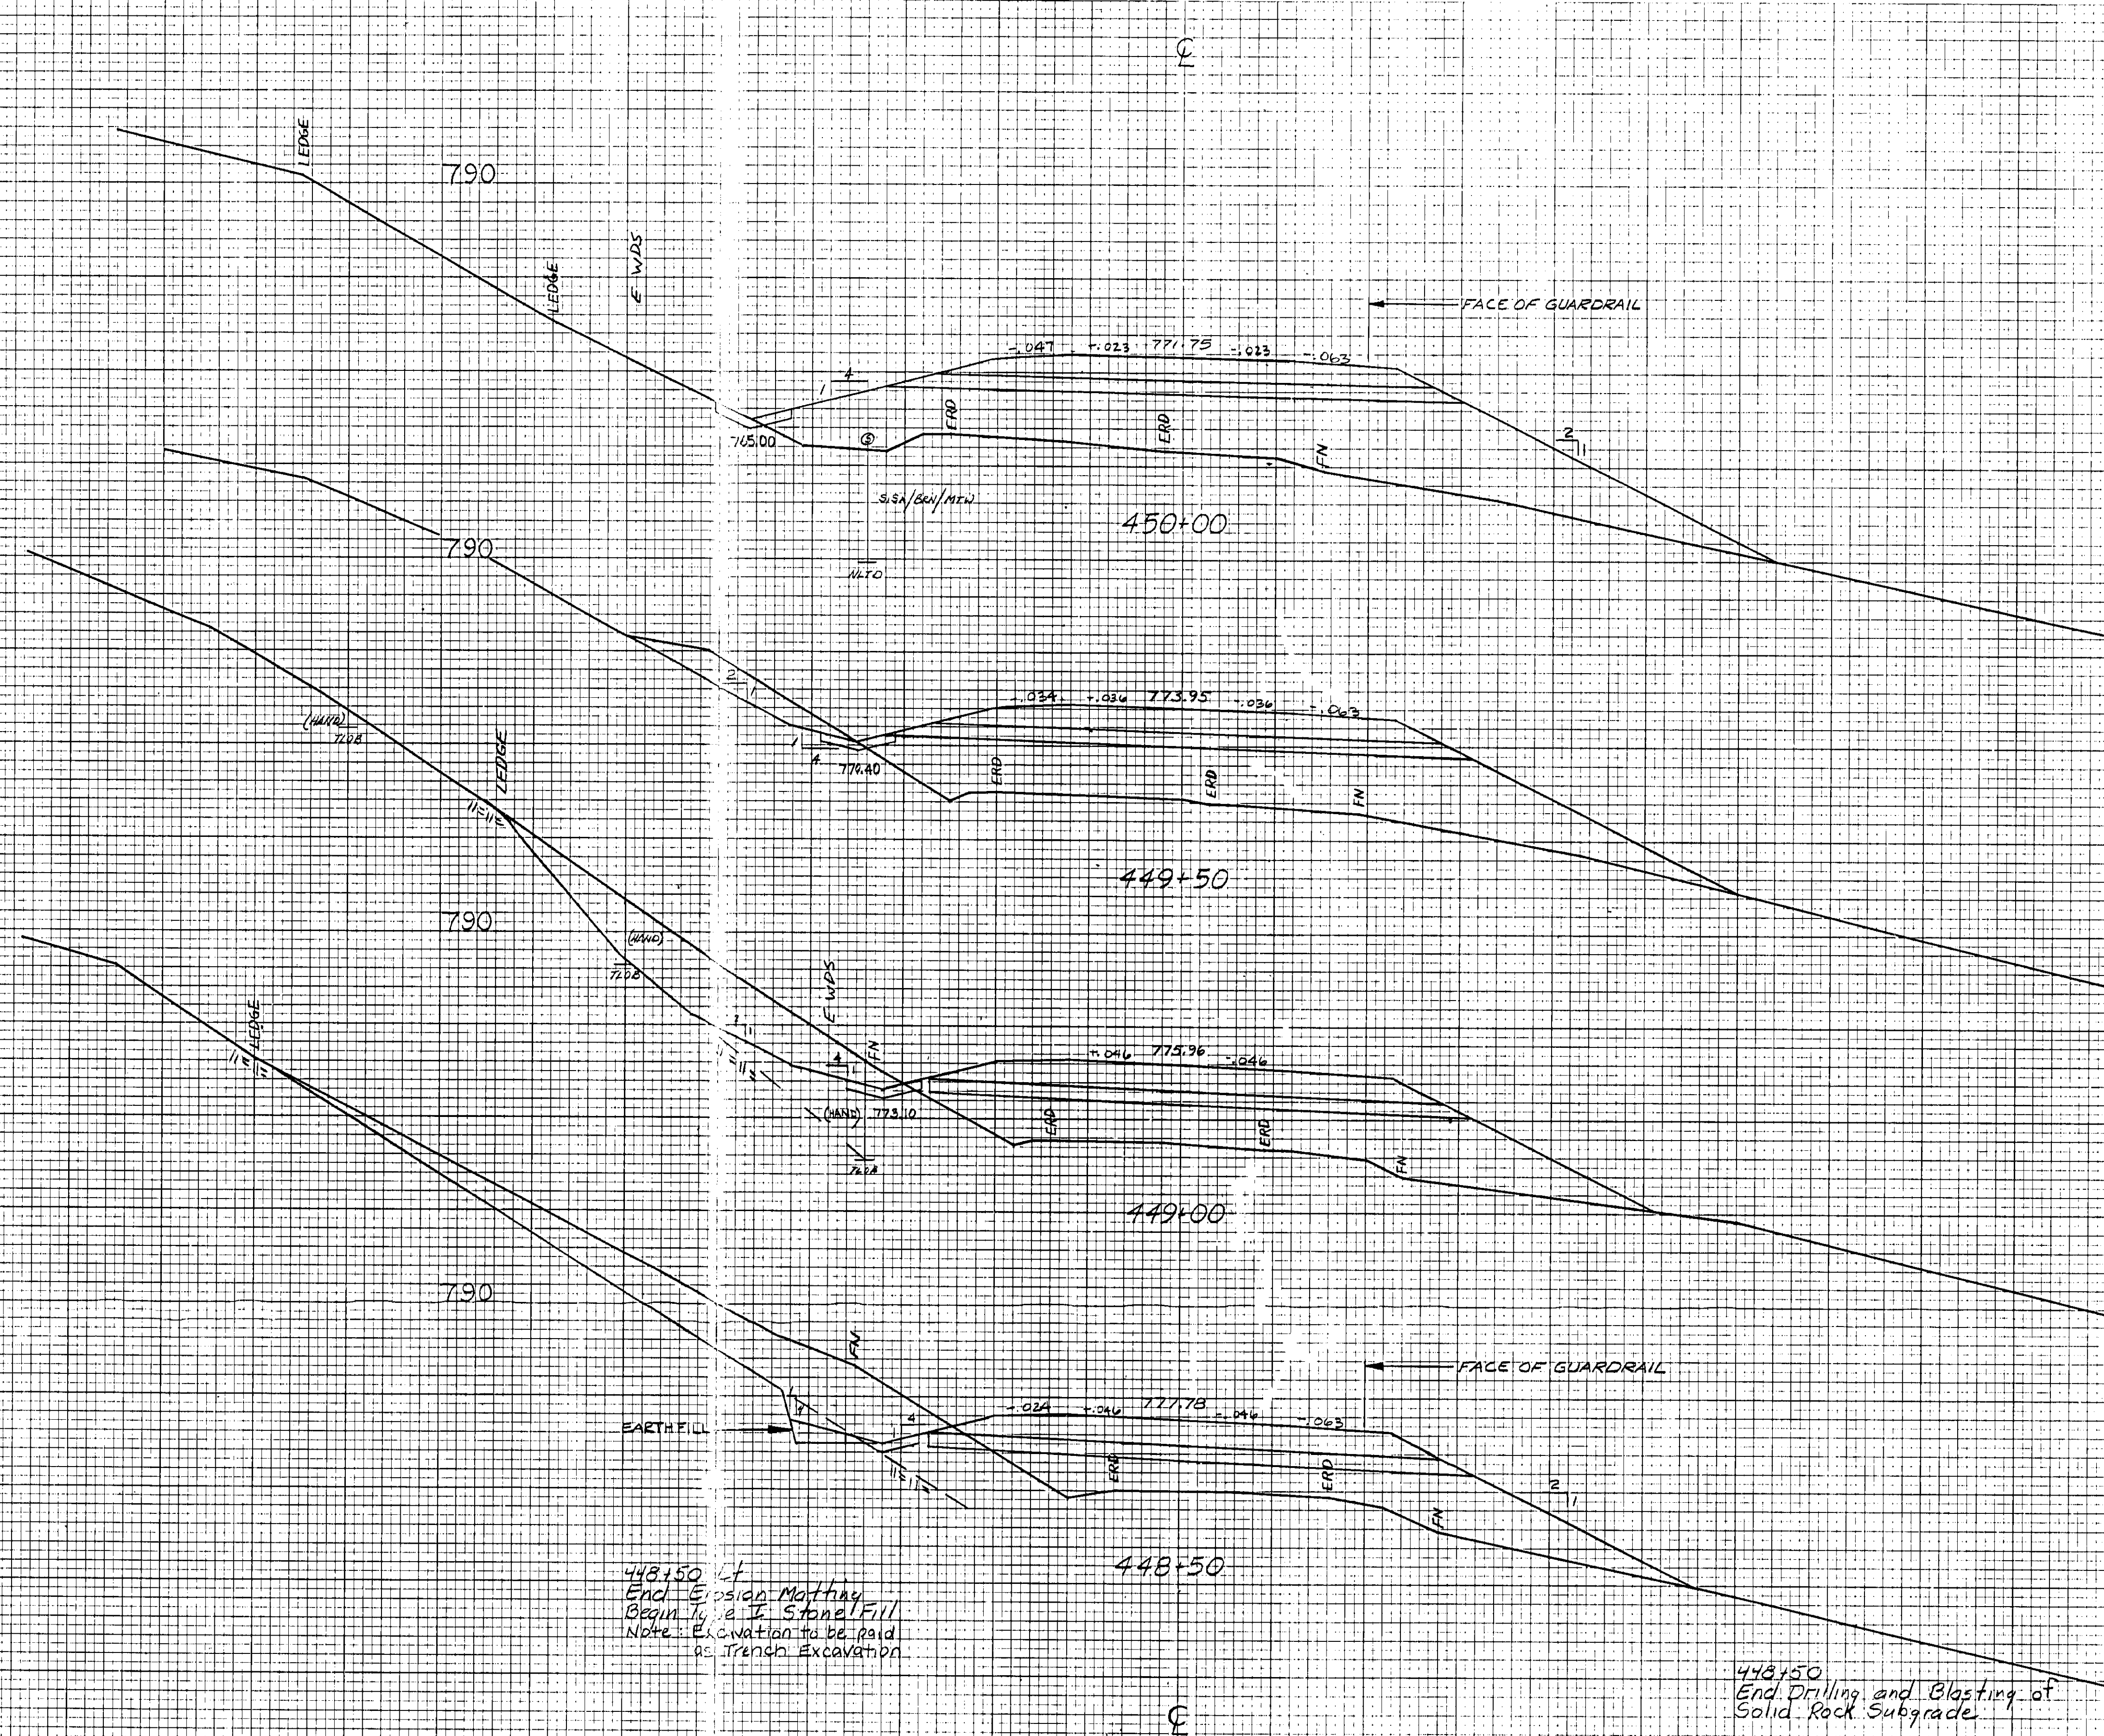

CROSS SECTIONS  
 STA 448+50 TO STA 450+00  
 GROTON-RYEGATE ROAD - (30)  
 SHEET 122 OF 152