
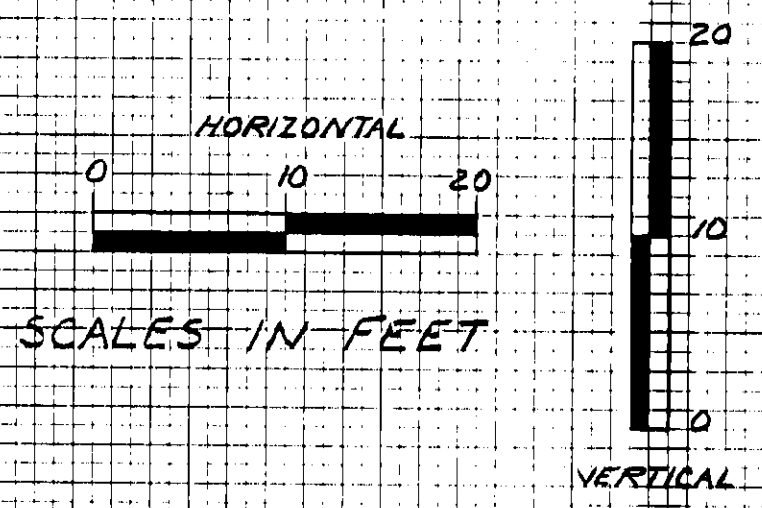


DATE	
BY	
PROJECTED	
REVISIONS	
NO.	
DATE	
BY	
PROJECTED	
REVISIONS	
NO.	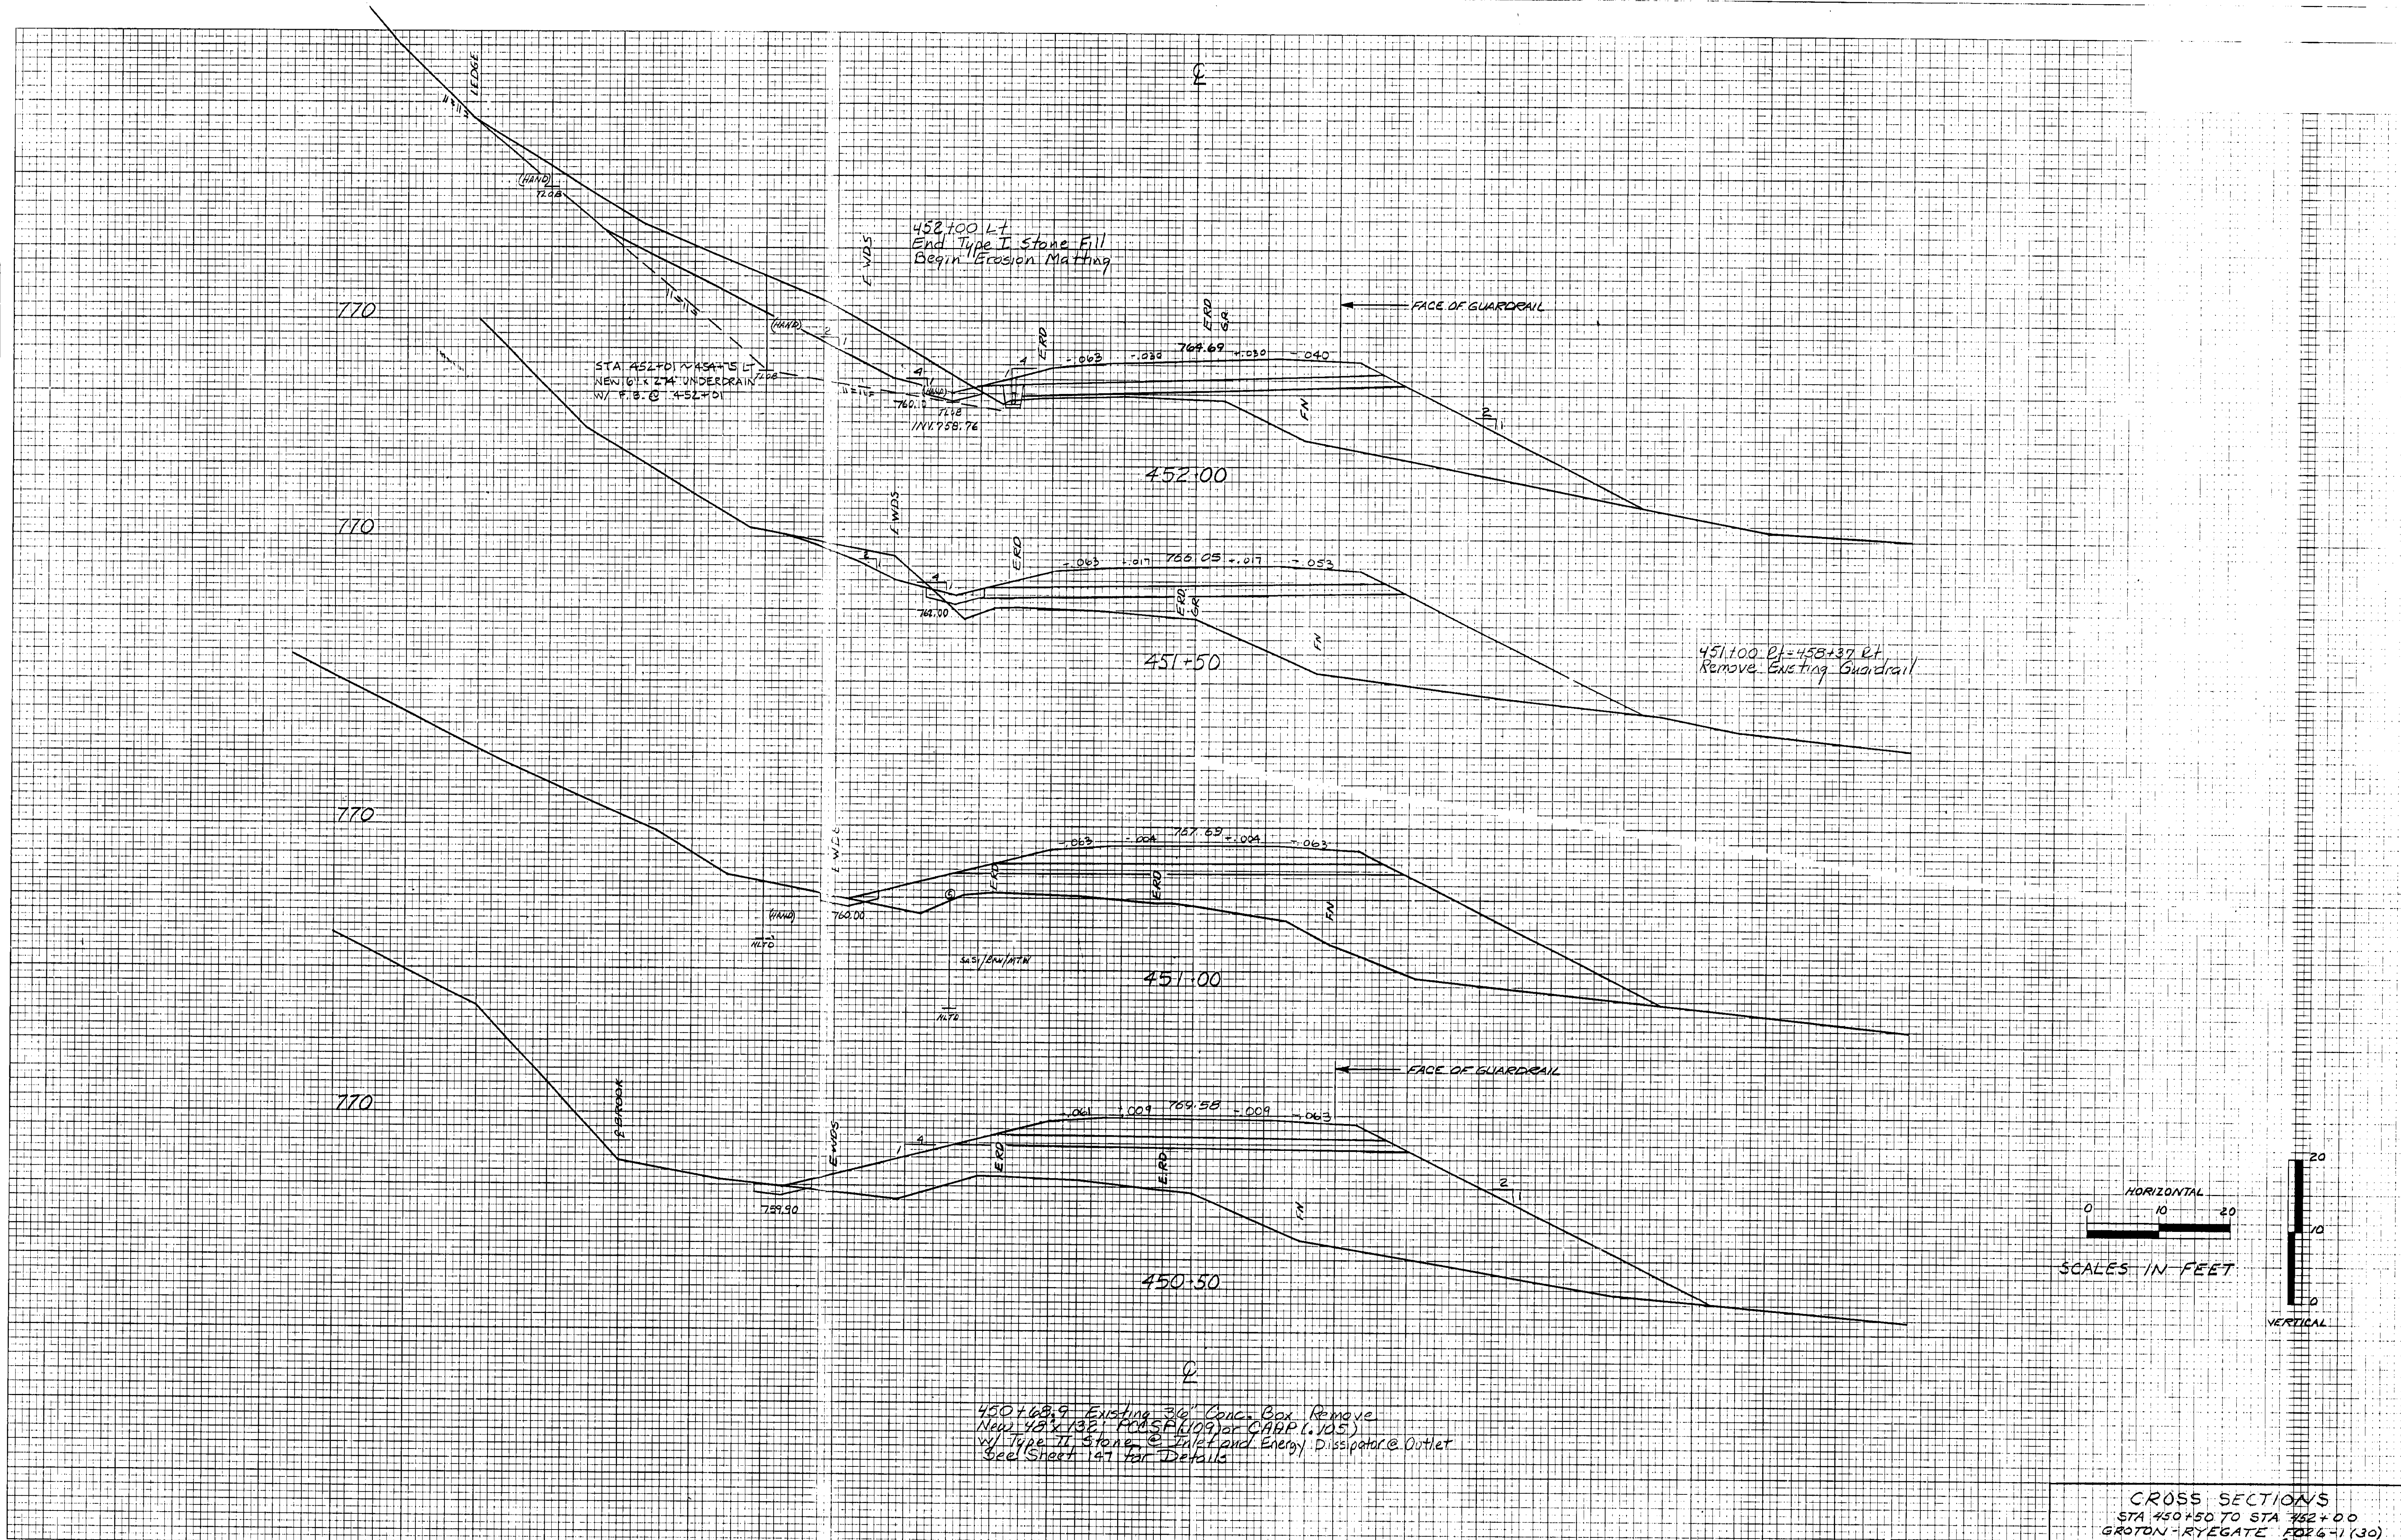
450+68.9 Existing 36" Conc. Box Remove
 New 48" x 132" CORRUGATED CORR (1.105)
 w/ Type II Stone @ Inlet and Energy Dissipator @ Outlet
 See Sheet 147 for Details

CROSS SECTIONS
 STA 450+50 TO STA 452+00
 GROTON - RYEGATE FOR 6-1(30)
 SHEET 128 OF 152