


DATE  
BY  
DESIGNED BY  
CHECKED BY  
DATE  
BY  
DATE  
BY

ECG, RCB, JPF  
G.P.F., R.M.B.  
G.P.F., J.S.S.  
DATE  
BY  
DATE  
BY

ORIGINAL SURVEY  
NOTE BOOK NO. 471, 472, 473  
AREAS CALCULATED

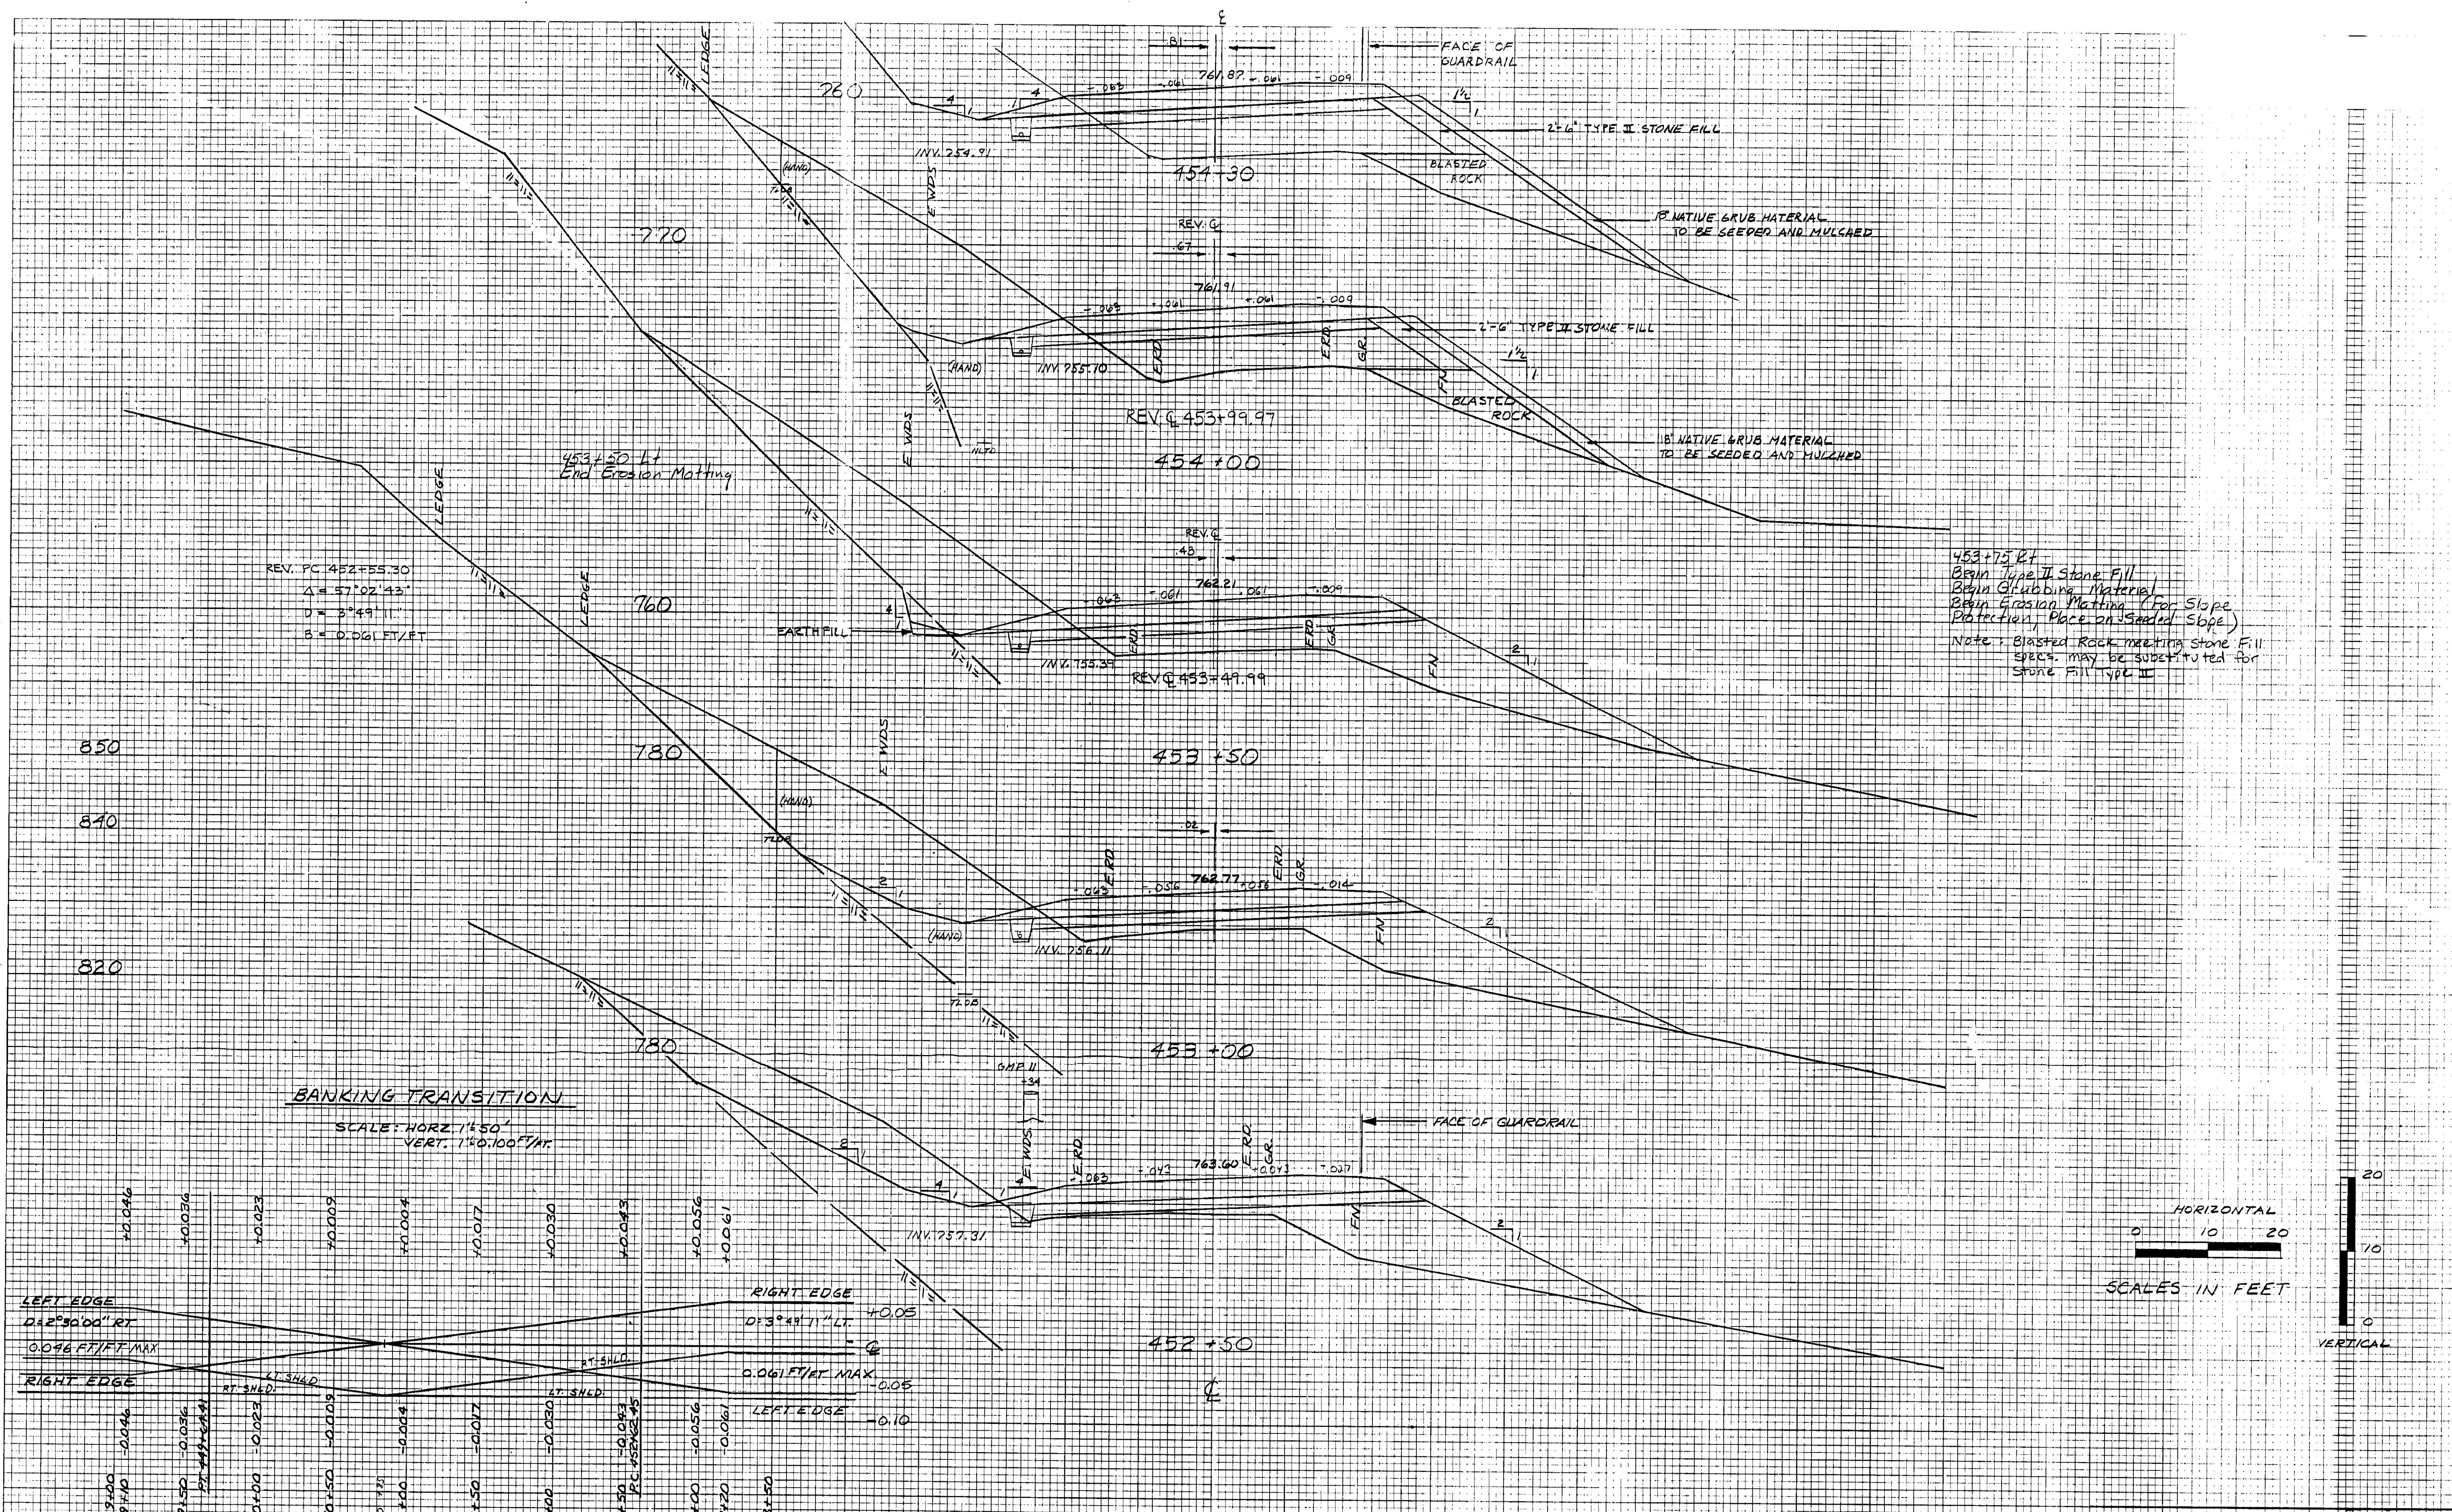


REV. PC 452+55.30  
Δ = 57°02'43"  
D = 3°49'11"  
B = 0.061 FT/FT

453+75 RT  
Begin Type II Stone Fill  
Begin Grubbing Material  
Begin Erosion Matting (For Slope Protection, Place on Seeded Slope)  
Note: Blasted Rock meeting Stone Fill specs. may be substituted for Stone Fill Type II

**BANKING TRANSITION**  
SCALE: HORIZ. 1"=50'  
VERT. 1"=100' (V.T.)

STATION	LEFT EDGE	RIGHT EDGE
449+00	-0.046	+0.005
449+50	-0.046	+0.005
450+00	-0.046	+0.005
450+50	-0.046	+0.005
451+00	-0.046	+0.005
451+50	-0.046	+0.005
452+00	-0.046	+0.005
452+50	-0.046	+0.005
453+00	-0.046	+0.005
453+50	-0.046	+0.005

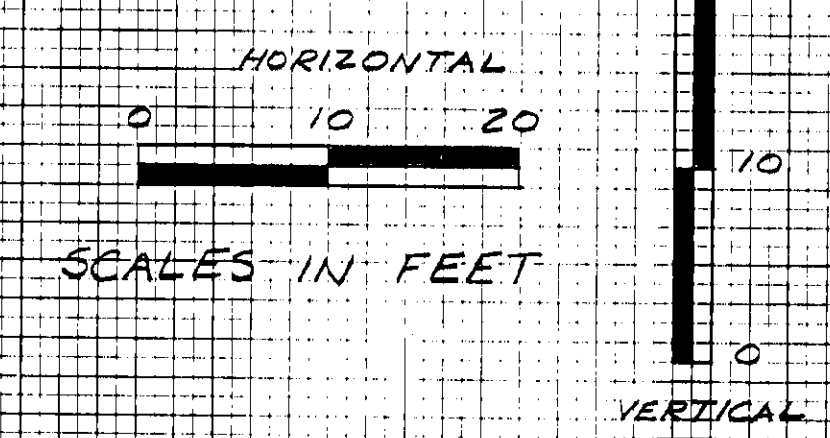

**CROSS SECTION 15**  
STA. 452+50 TO STA. 454+00  
GROTON - RYEGATE FOREGATE (30)  
SHEET 124 OF 152