
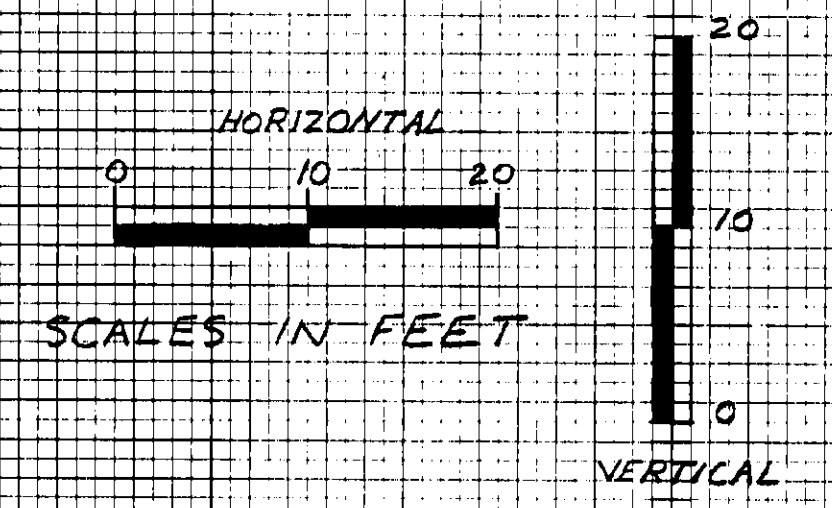


DATE	
BY	
DESIGNED	
PLOTTED	
NOTED	
AREA CHECKED	
NO.	
FINAL SURVEY	
NOTE BOOK	
NO.	

DATE	DEC 84
BY	ECS, RGS, LPT, GPF, RWB, RAN, SJS
DESIGNED	
PLOTTED	
NOTED	
AREA CHECKED	
NO.	5777 30
ORIGINAL SURVEY	
NOTE BOOK	
NO.	

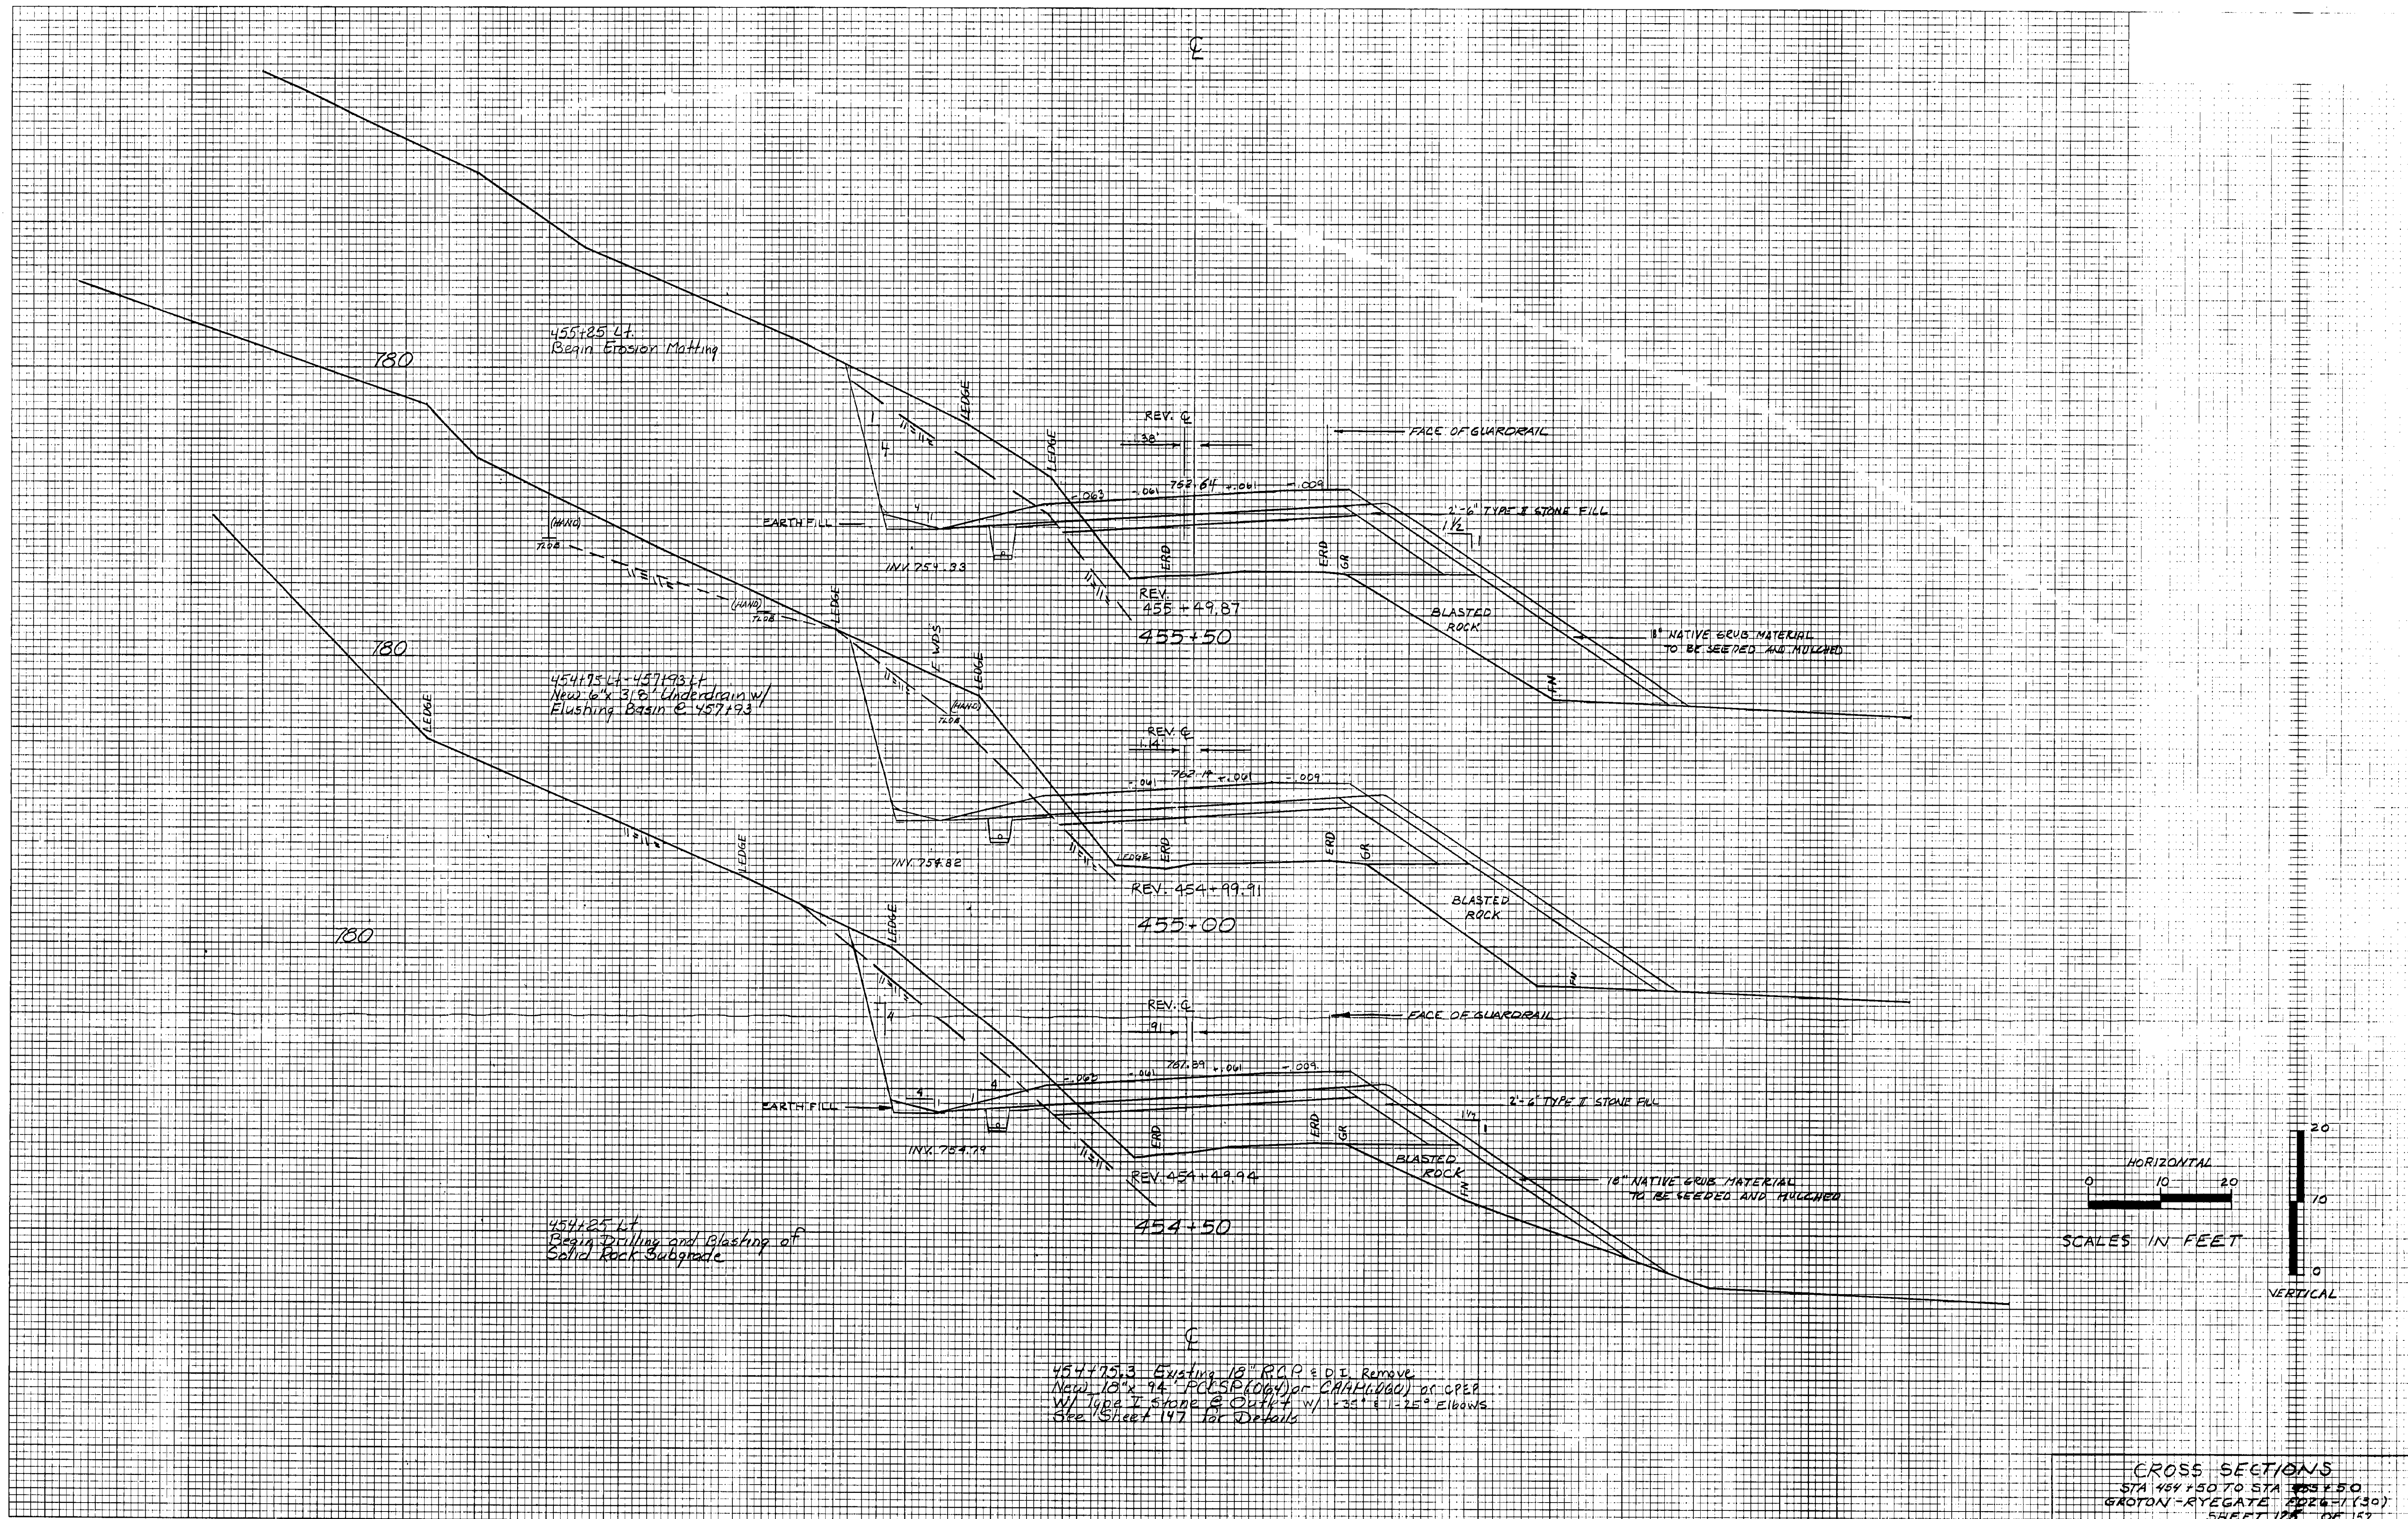

454+75.3 Existing 18" RCP @ D.I. Remove
 New 18" x 94" PCLSP (1064) or CRAMP (1064) or CPEP
 w/ type I Stone @ Outlet w/ 1-25° & 1-25° Elbows
 See Sheet 147 for Details

CROSS SECTIONS
 STA 454+50 TO STA 455+50
 GROTON-RYEGATE RD 26-1(30)
 SHEET 108 OF 152