
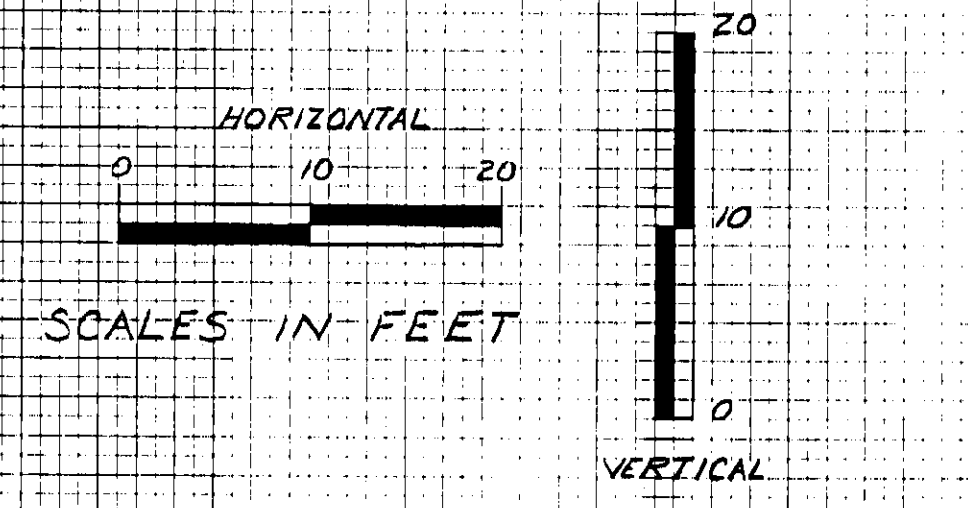


DATE	
BY	
SURVEYED	
PLOTTED	
NOTE BOOK	
NO.	
AREA CHECKED	

DATE	
BY	
SURVEYED	
PLOTTED	
NOTE BOOK	
NO.	
AREA CHECKED	

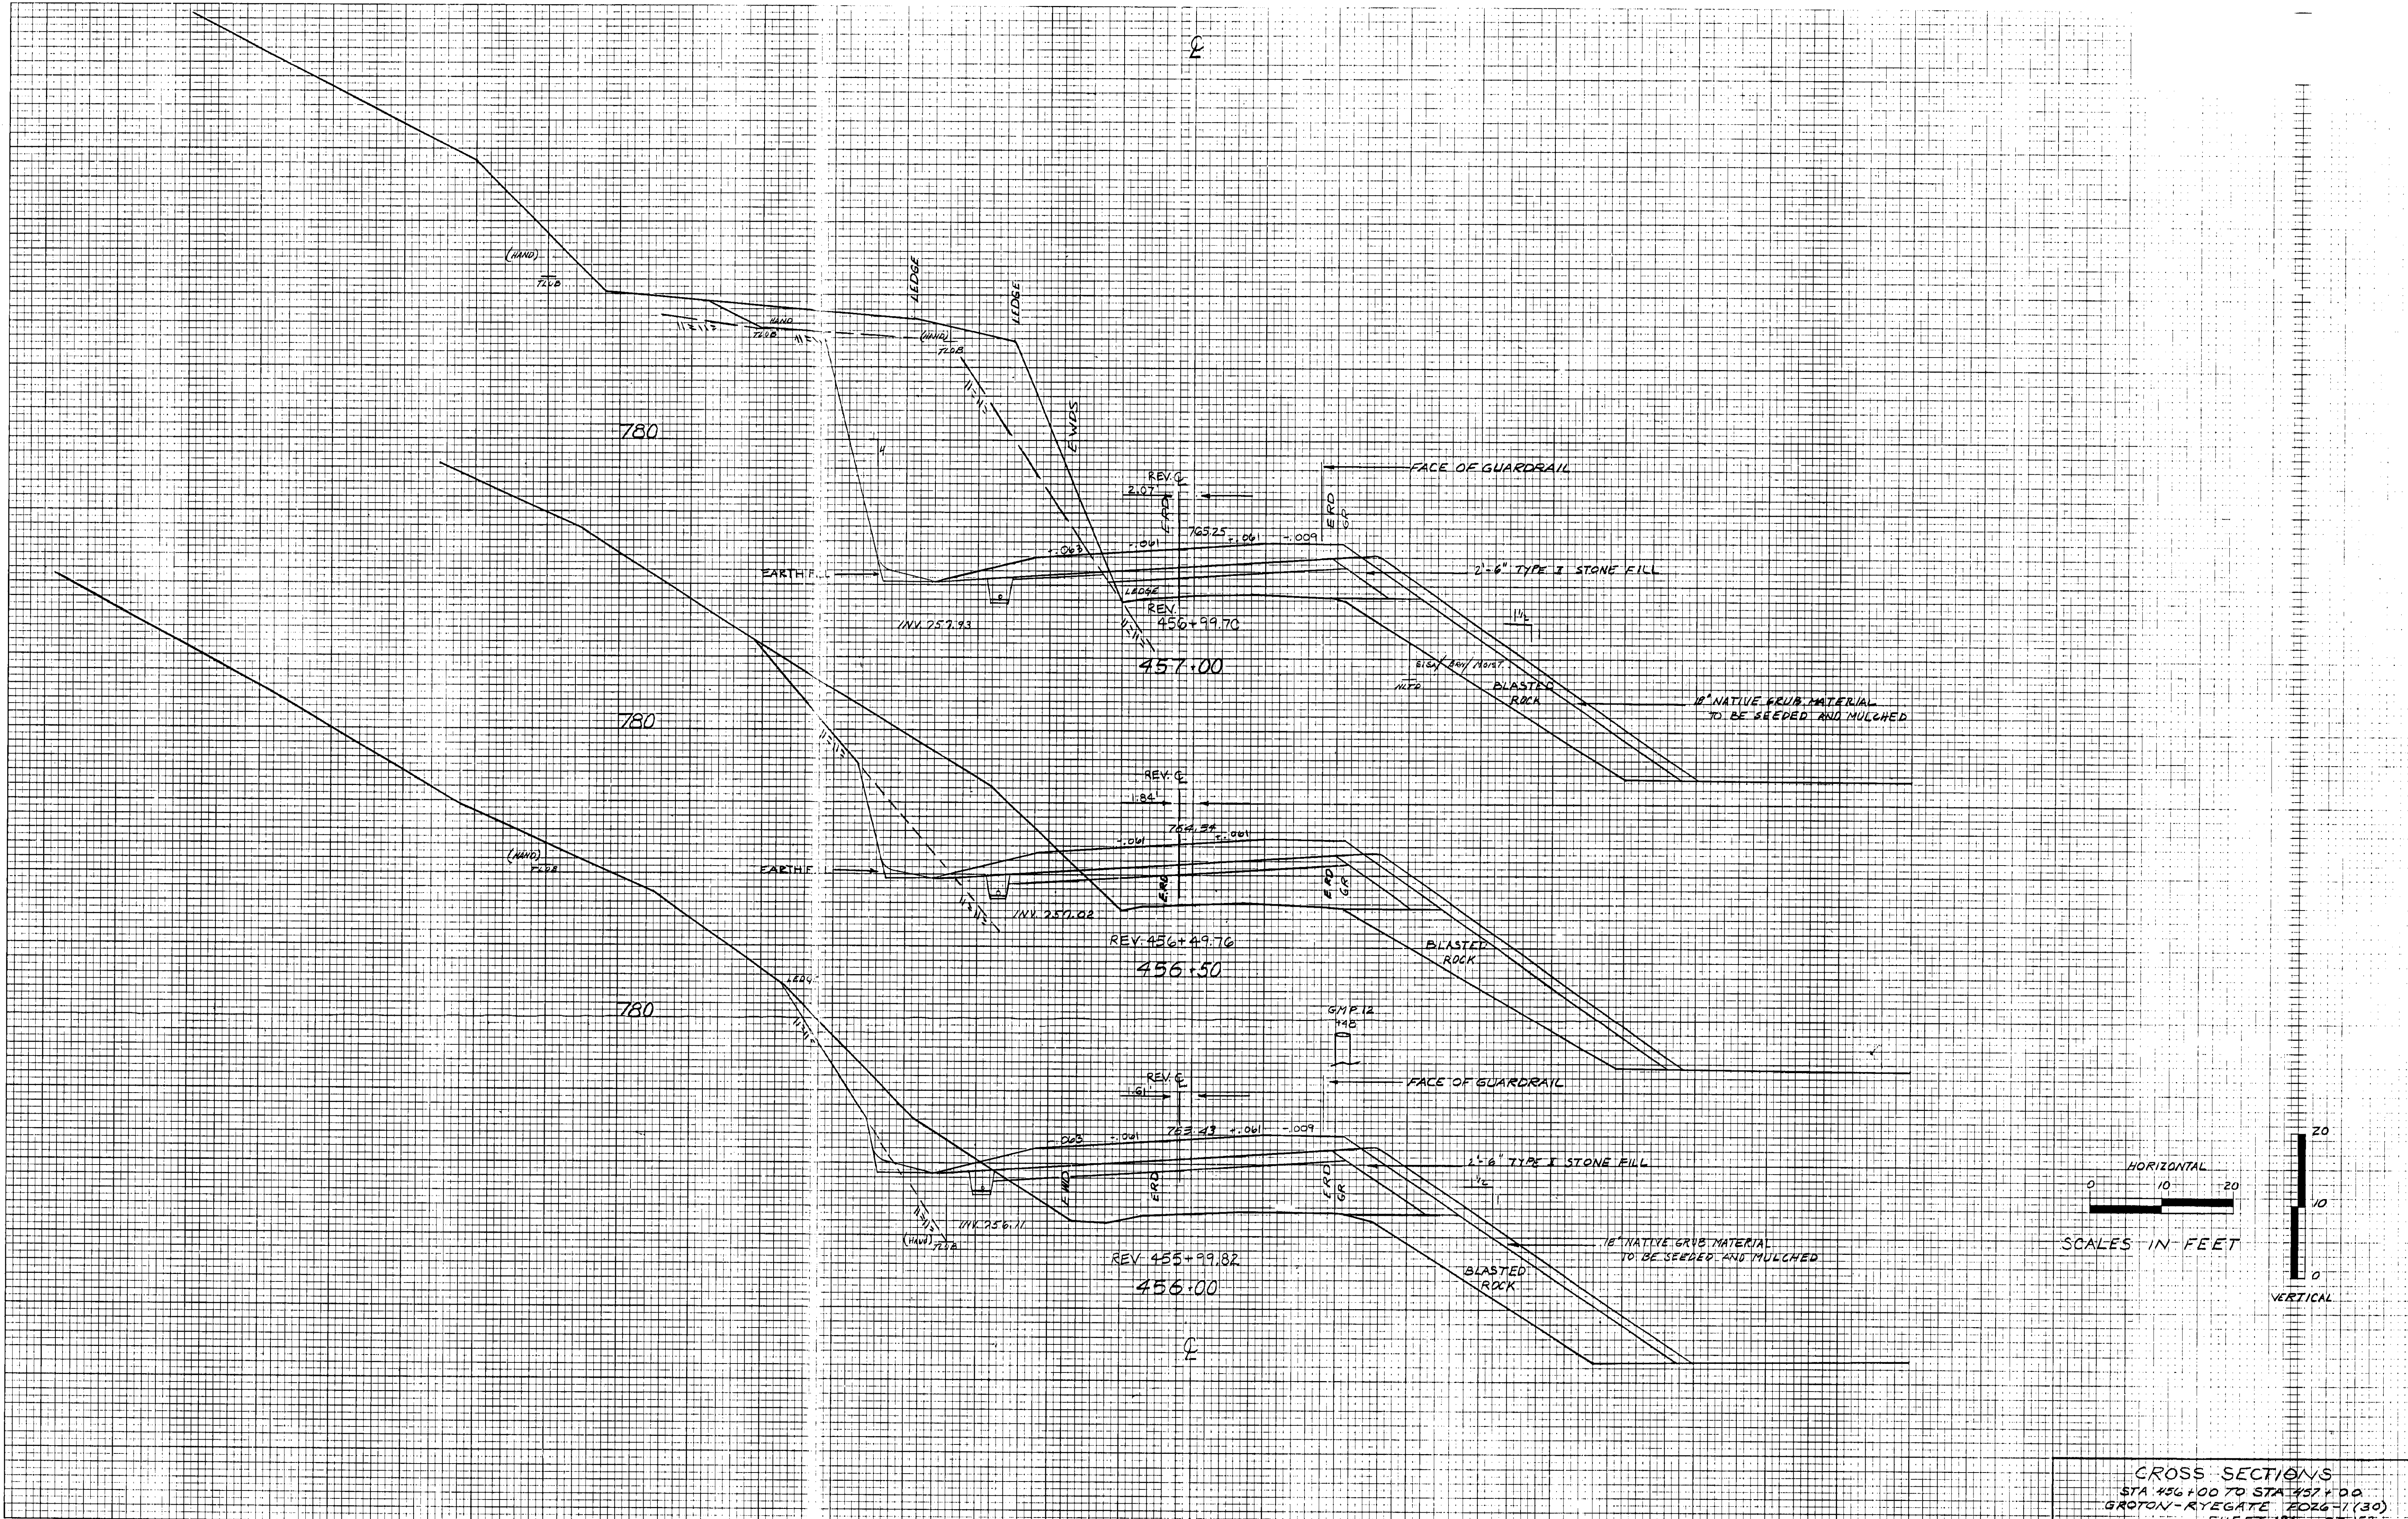

CROSS SECTIONS
 STA 456+00 TO STA 457+00
 GROTON-RYEGATE ROAD-1(30)
 SHEET 120 OF 152