


DATE	
BY	
SURVEYED	
TEMPERATURE	
AREA	
AS CHECKED	
FINAL SURVEY NOTE BOOK NO.	


DATE	
BY	
DESIGNED	
CHECKED	
APPROVED	
SCALE	
REVISIONS	
ORIGINAL SURVEY NOTE BOOK NO.	

458+00L-461+50L
New 6" x 360 Underdrain w/
Flushing Basin @ 461+50

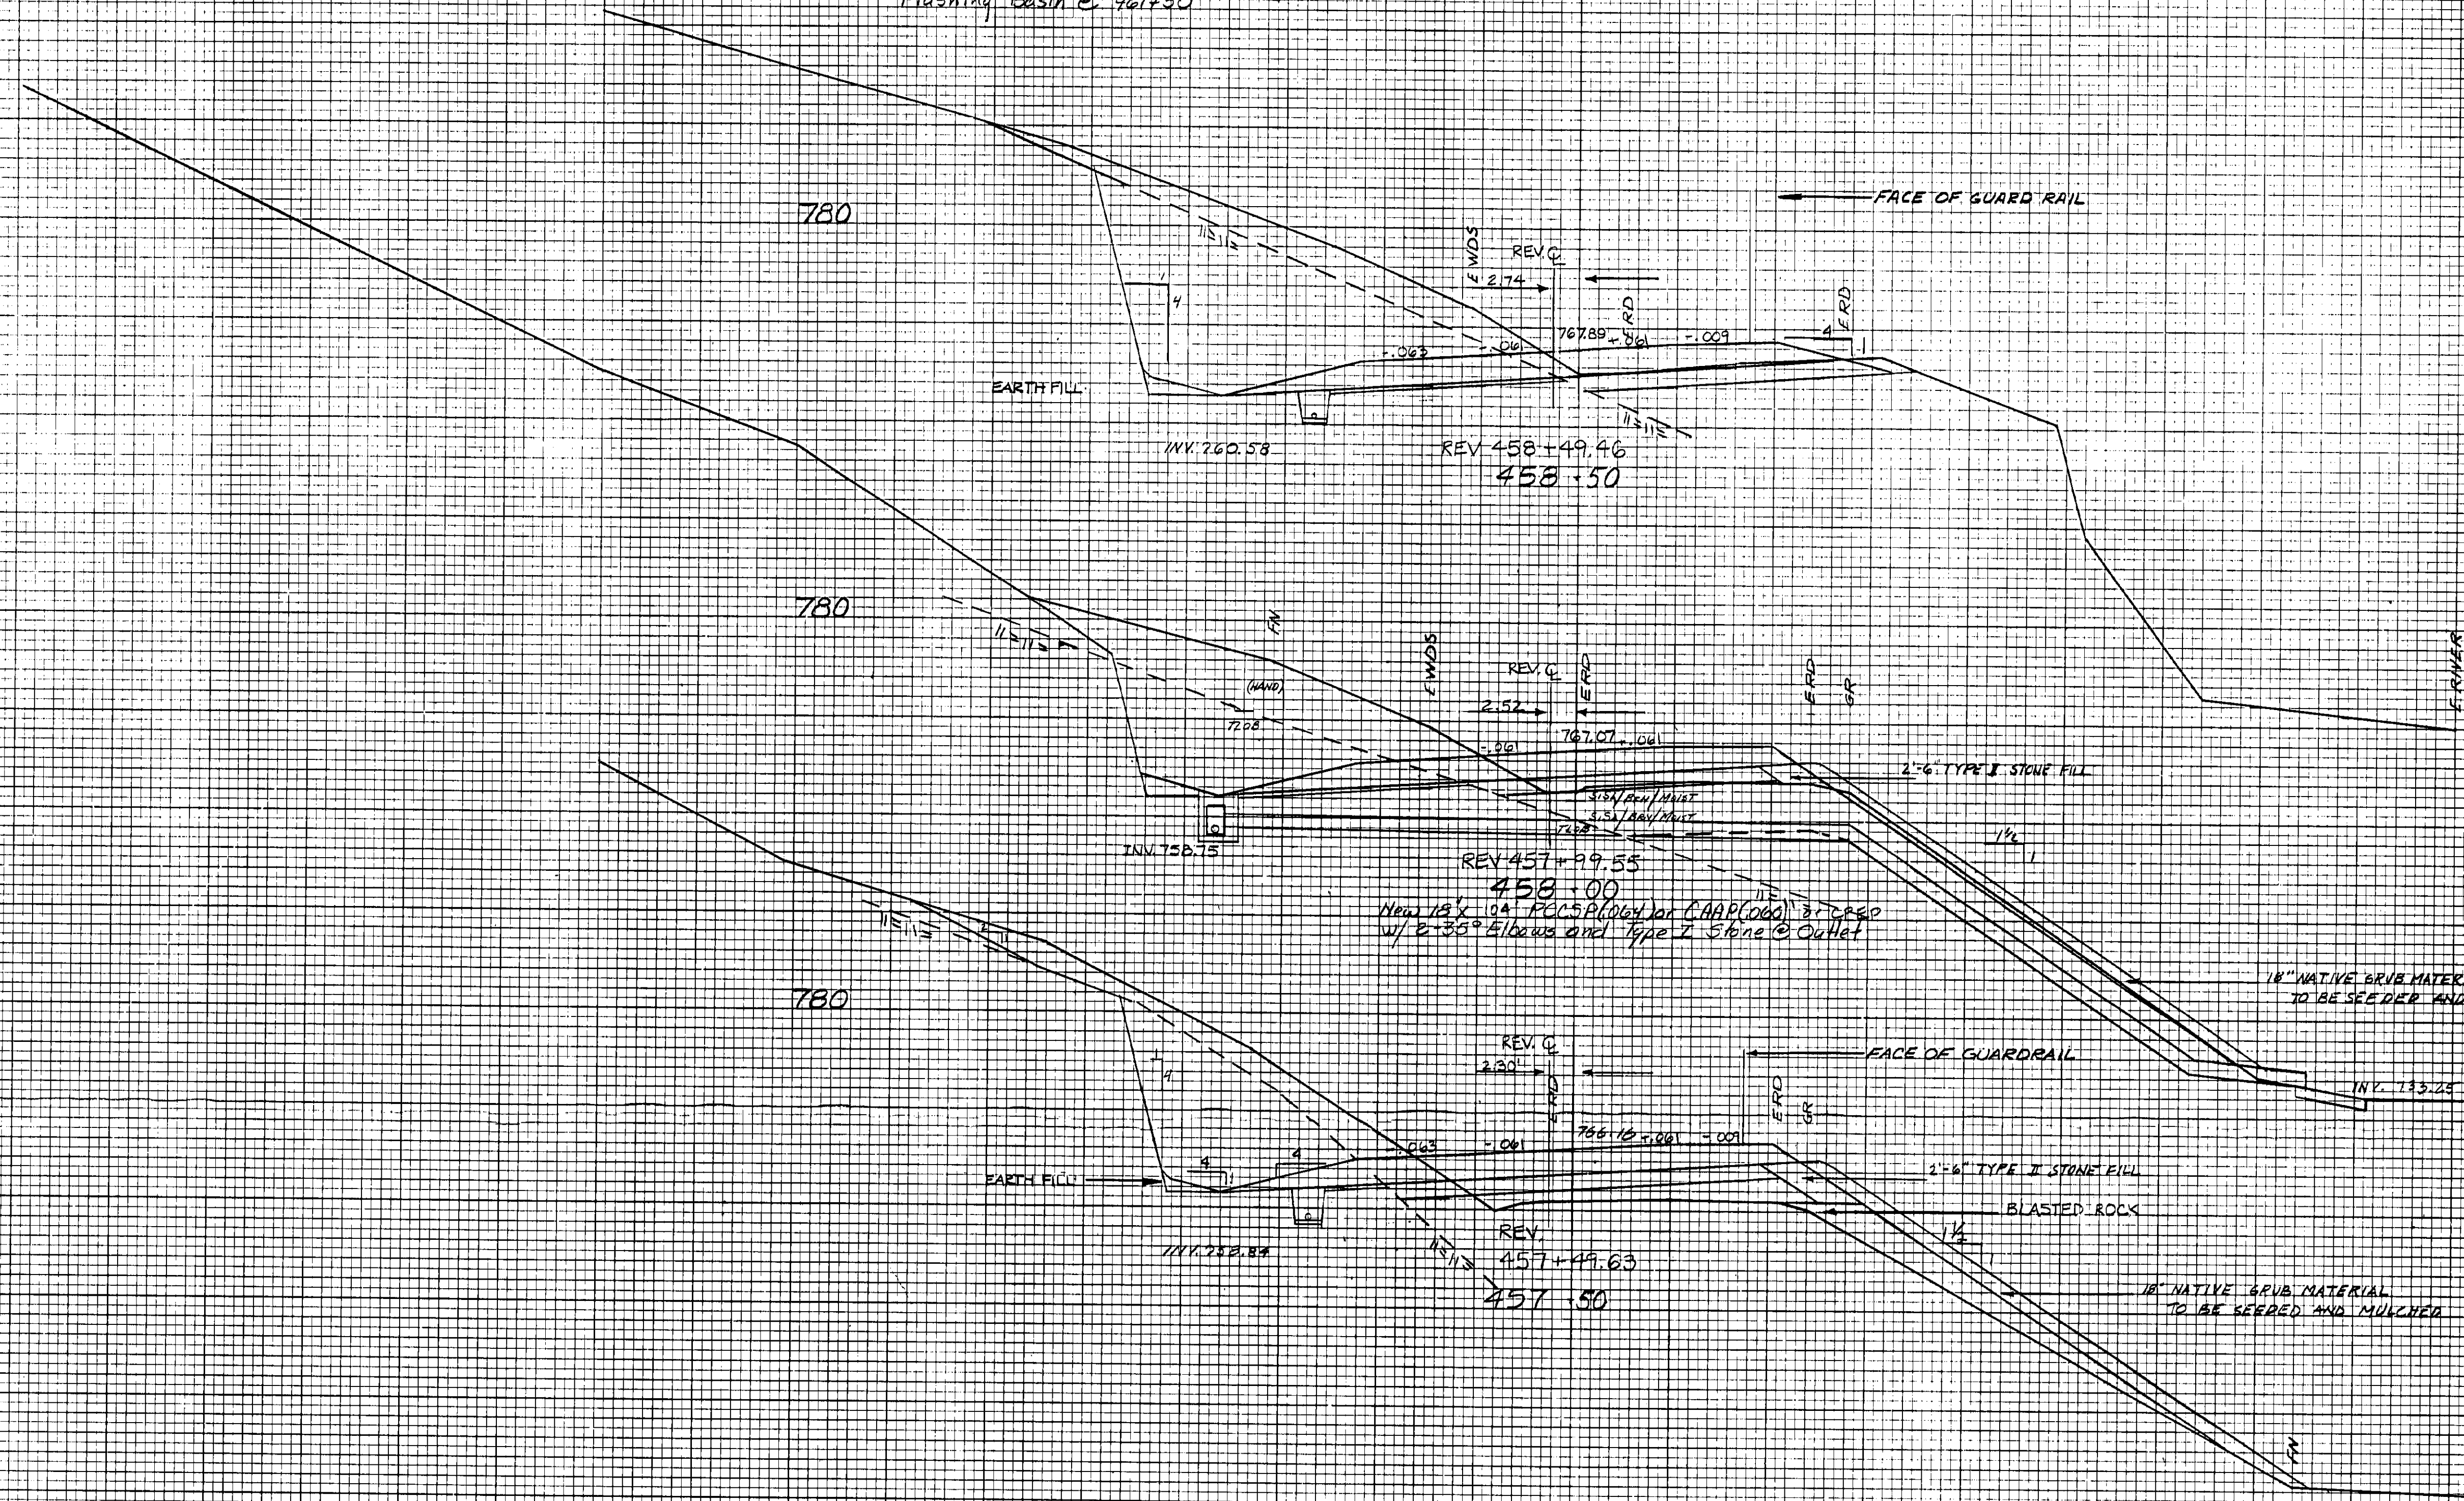

458+05 R+
End Type I Stone Fill
End Grubbing Material
End Erosion Matting

457+50 P
End Scarifying Existing Pavement

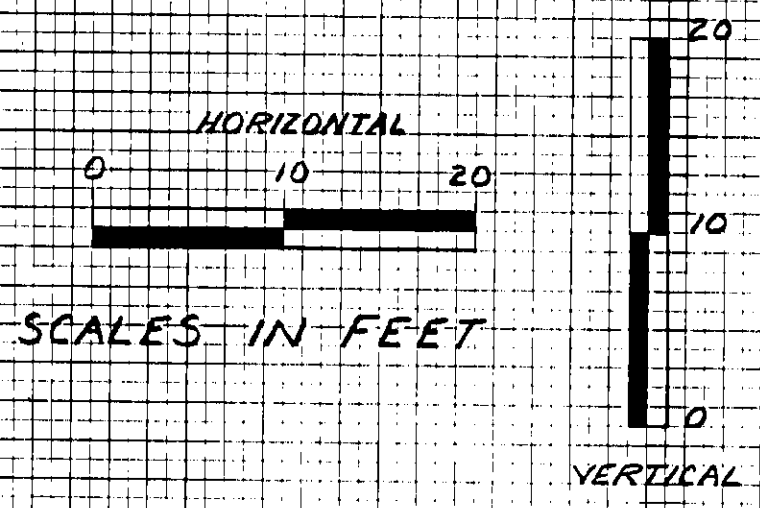

CROSS SECTIONS
STA 457+50 TO STA 458+50
GROTON - RYEGATE AD26-1 (130)
SHEET 127 OF 152