
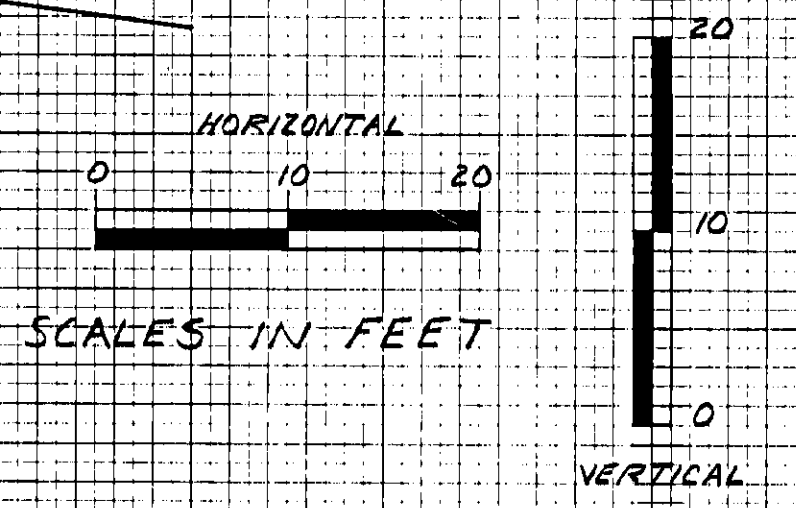


DATE	
BY	
REVISION	
NO. DATE	
FINAL SURVEY	
NOTE BOOK	
NO.	

DATE	
BY	
REVISION	
NO. DATE	
ORIGINAL SURVEY	
NOTE BOOK	
NO.	

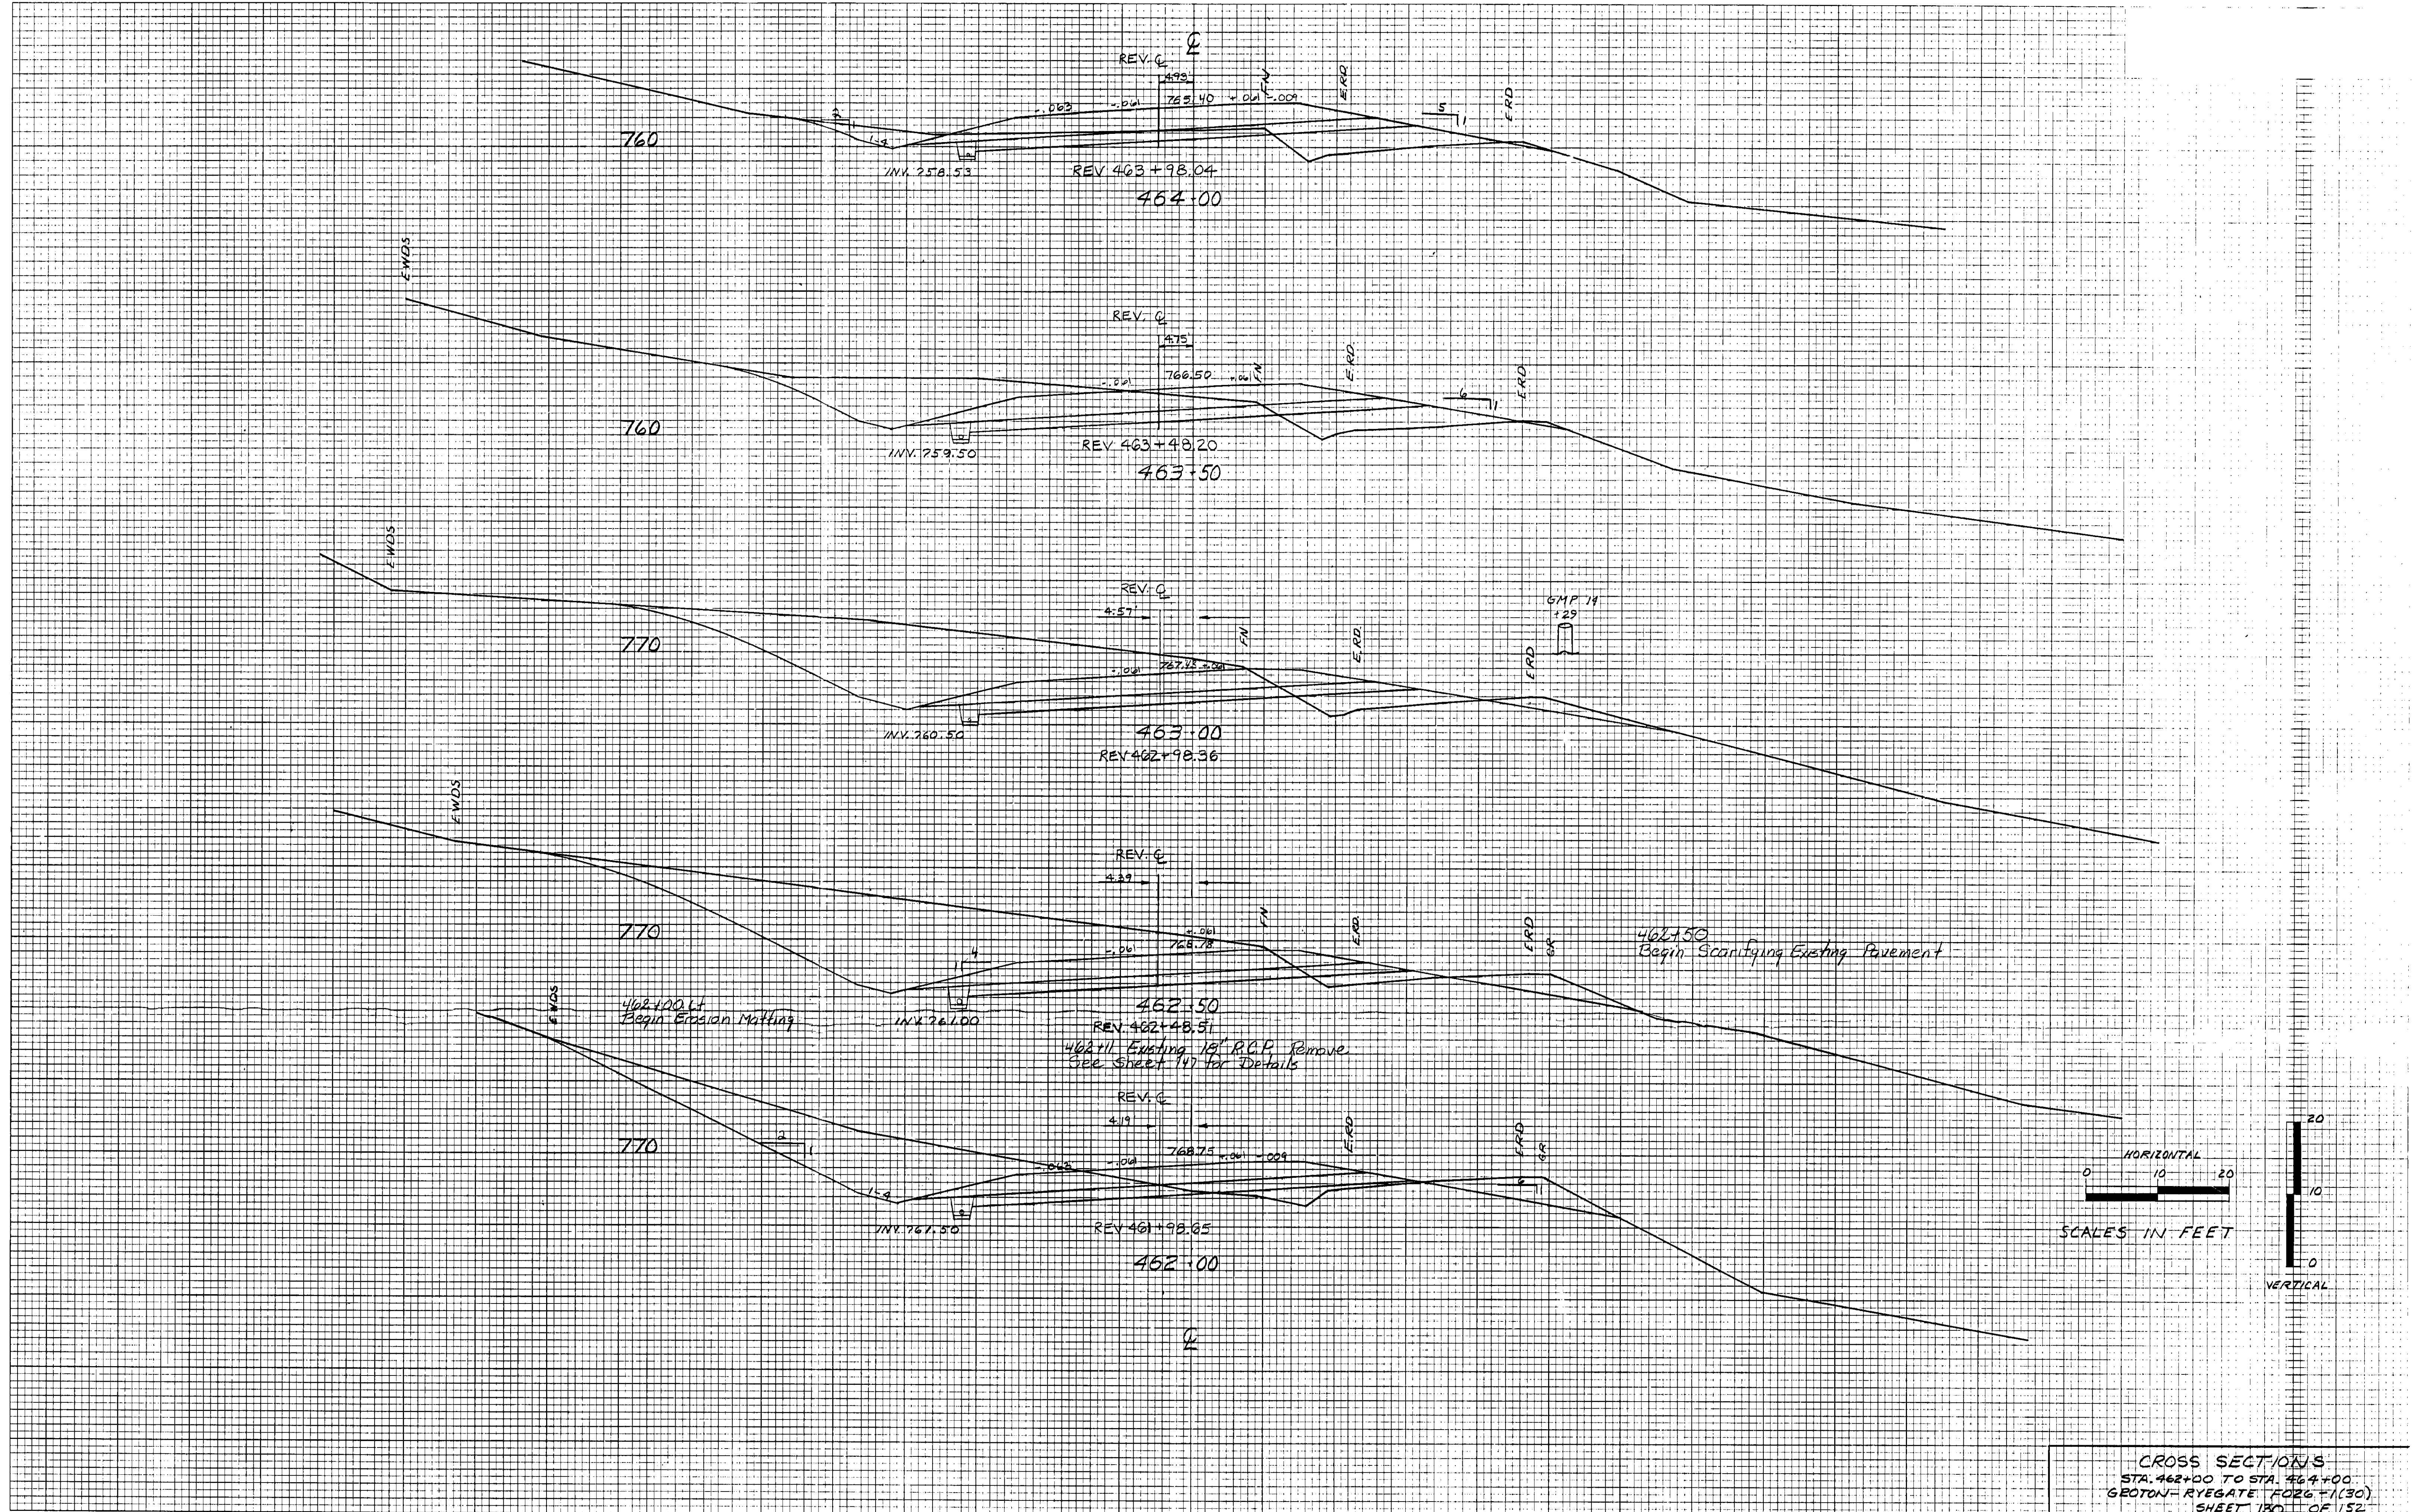

CROSS SECTIONS
 STA. 462+00 TO STA. 464+00
 GROTON- RYEGATE (FO26-1(30))
 SHEET 130 OF 152