



DATE: \_\_\_\_\_ BY: \_\_\_\_\_  
 SUBMITTED: \_\_\_\_\_  
 FINAL SURVEY NOTE BOOK TEMPLATE AREA CHECKED  
 No. \_\_\_\_\_

DATE: \_\_\_\_\_ BY: \_\_\_\_\_  
 SUBMITTED: \_\_\_\_\_  
 ORIGINAL SURVEY NOTE BOOK TEMPLATE AREA CHECKED  
 No. \_\_\_\_\_

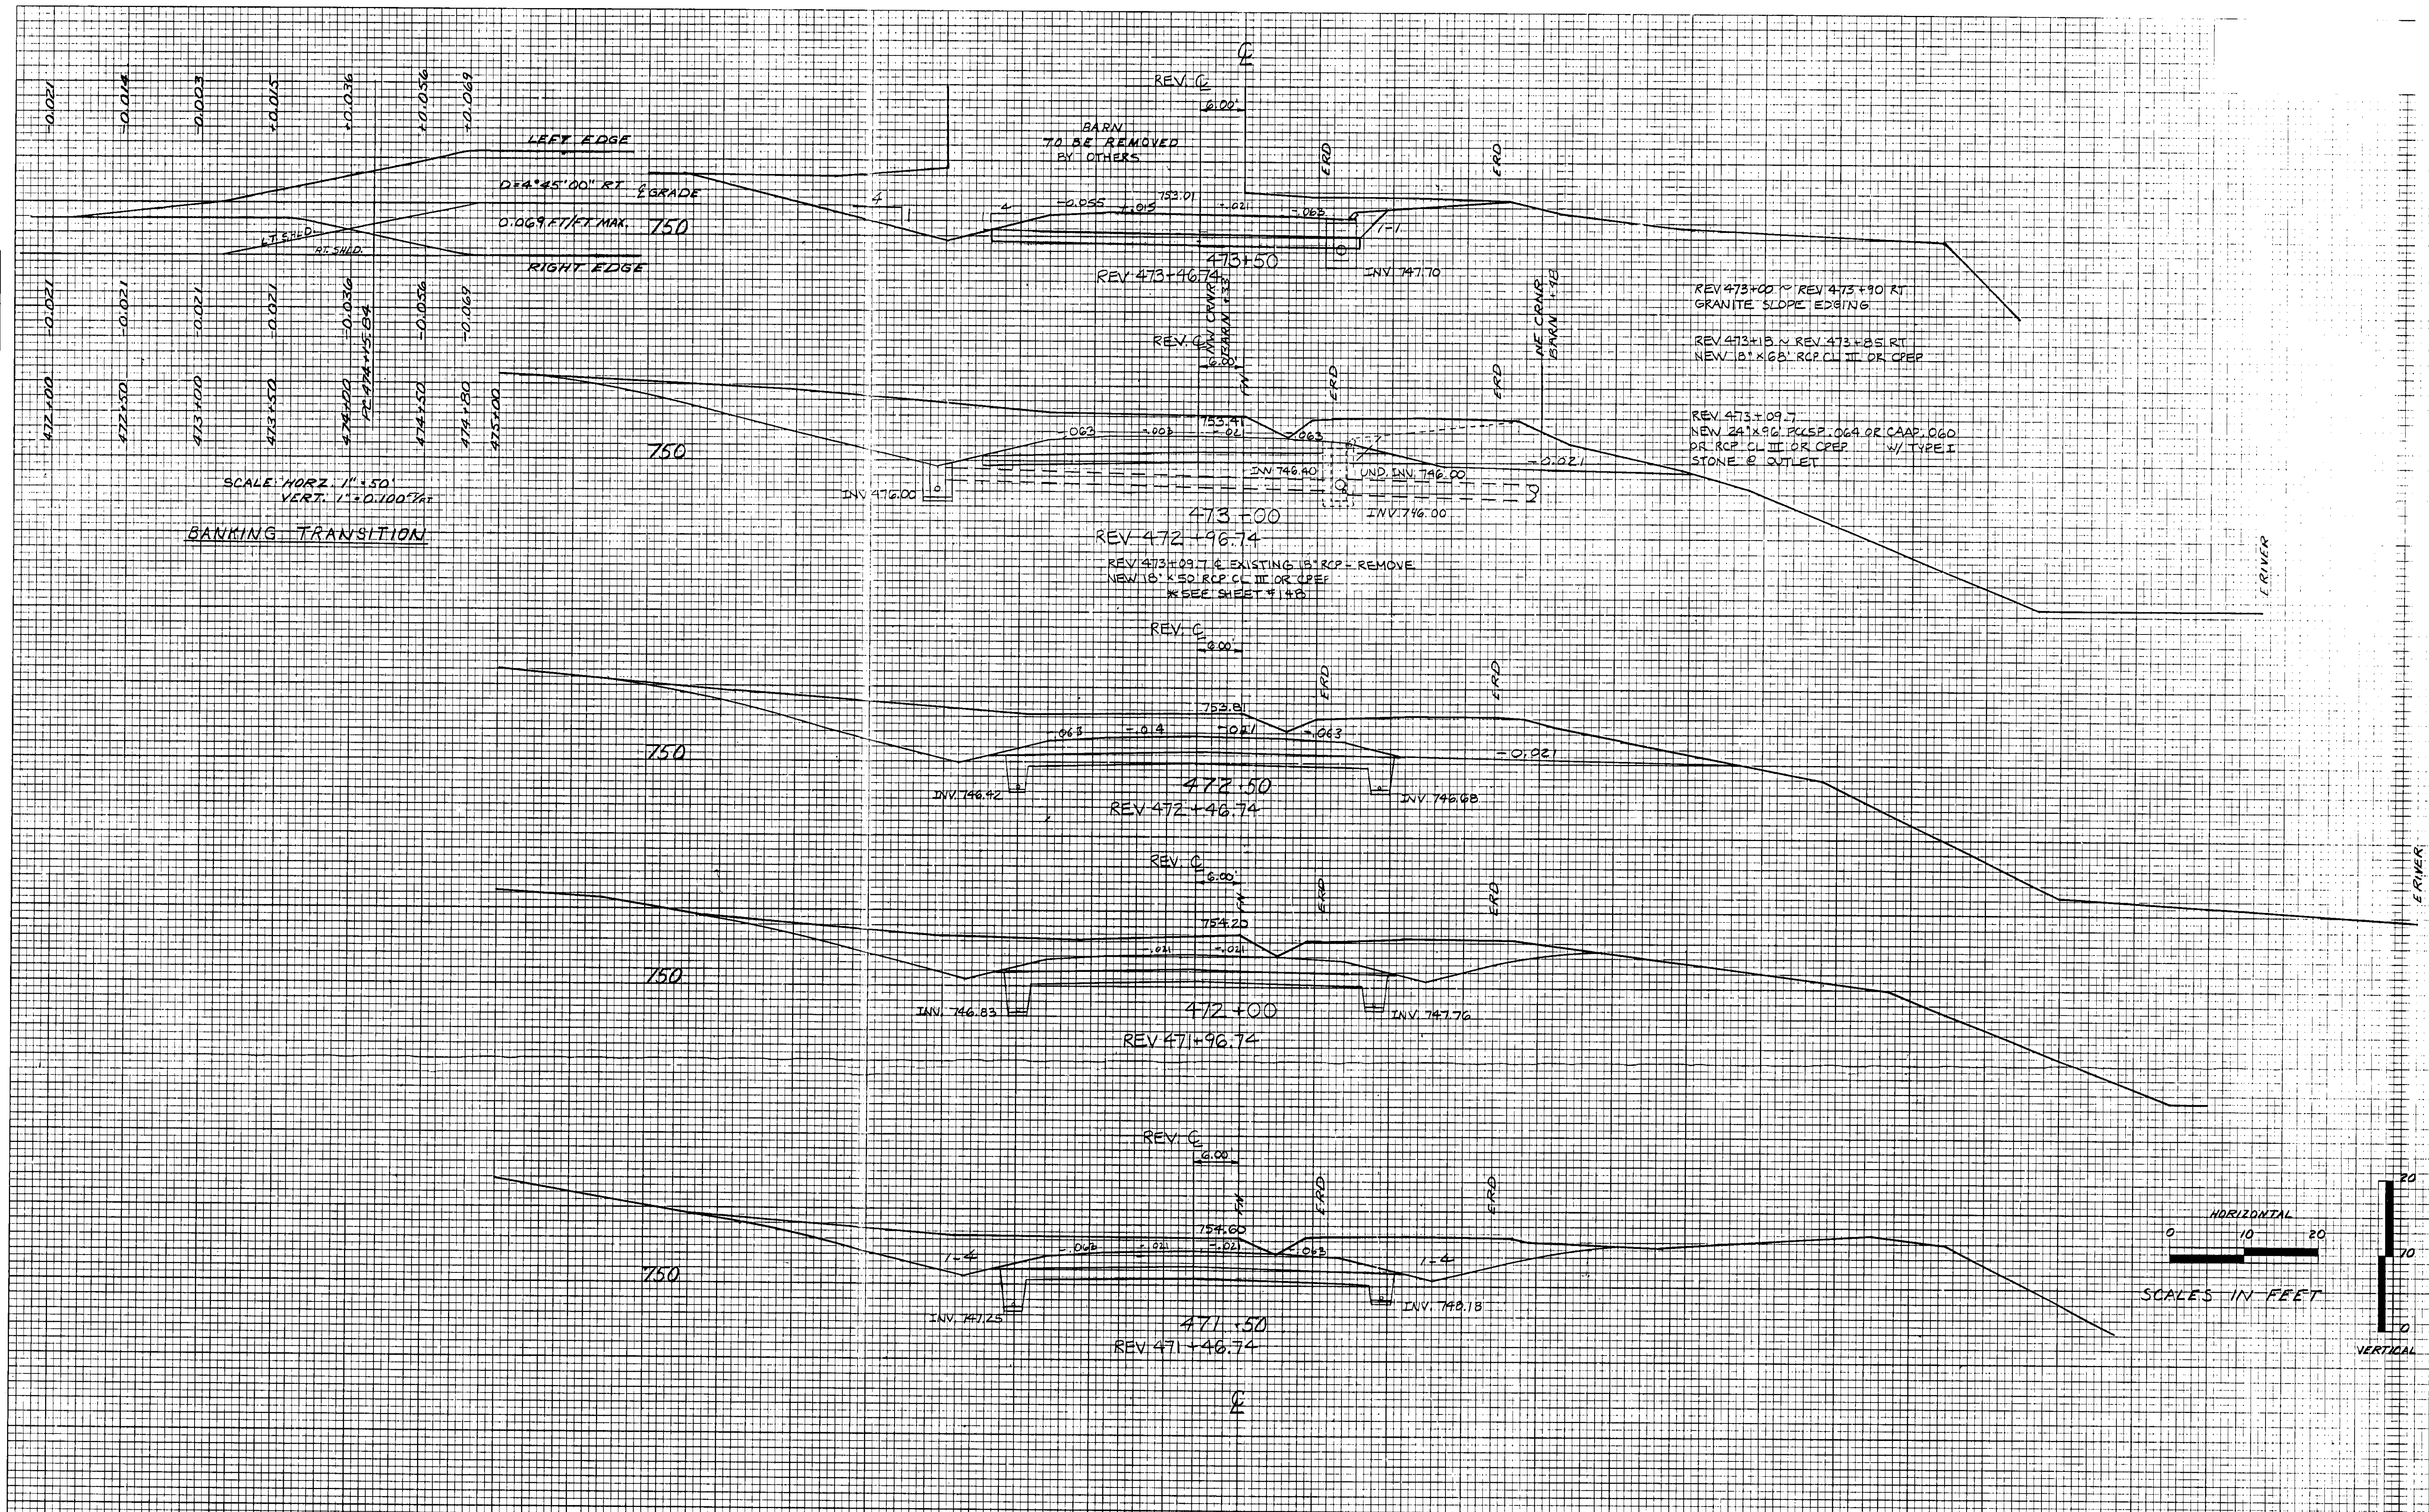

SCALE: HORIZ. 1" = 50'  
 VERT. 1" = 10.00'  
 BANKING TRANSITION

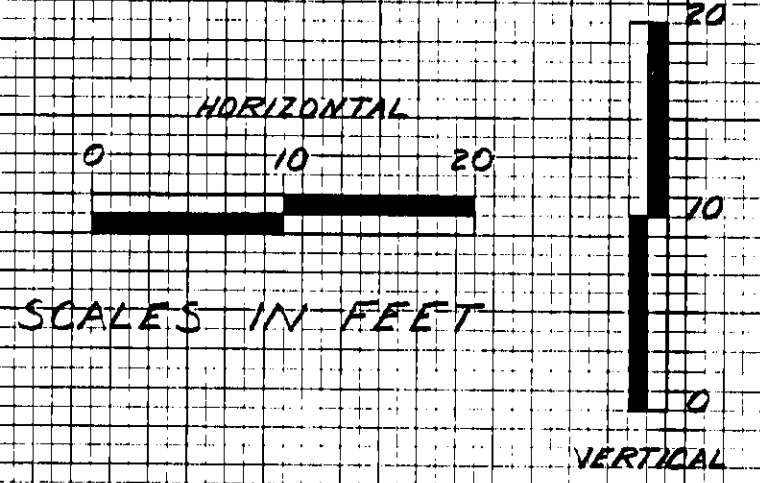

CROSS SECTIONS  
 STA. 471+50 TO STA. 473+50  
 BROTON - RYKIGATE FORD # 108  
 SHEET 124 OF 152