
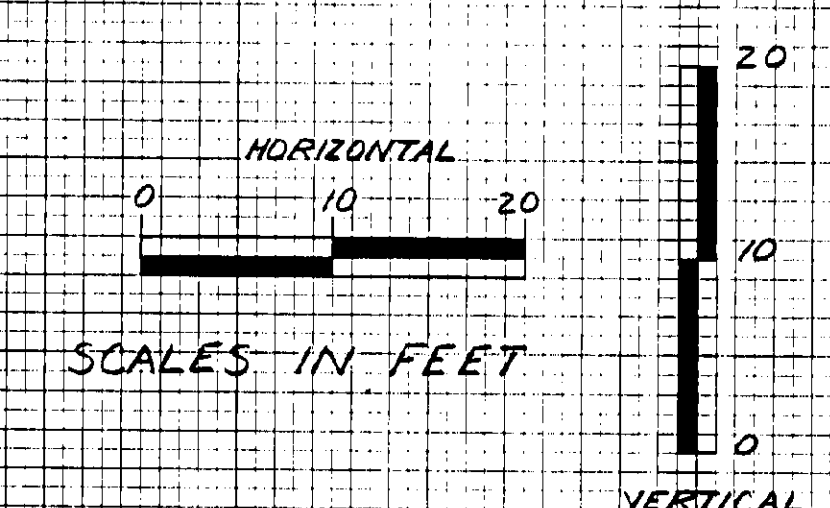


DATE	
BY	
APPROVED	
PLANNED	
CONTRACT	
AREA	
SCALE CHECKED	
NO.	

DATE	
DEC 86	
APR 87	
JAN 90	
SEP 93	
BY	
SEC 1	
SEC 2	
SEC 3	
SEC 4	
SEC 5	
NO.	

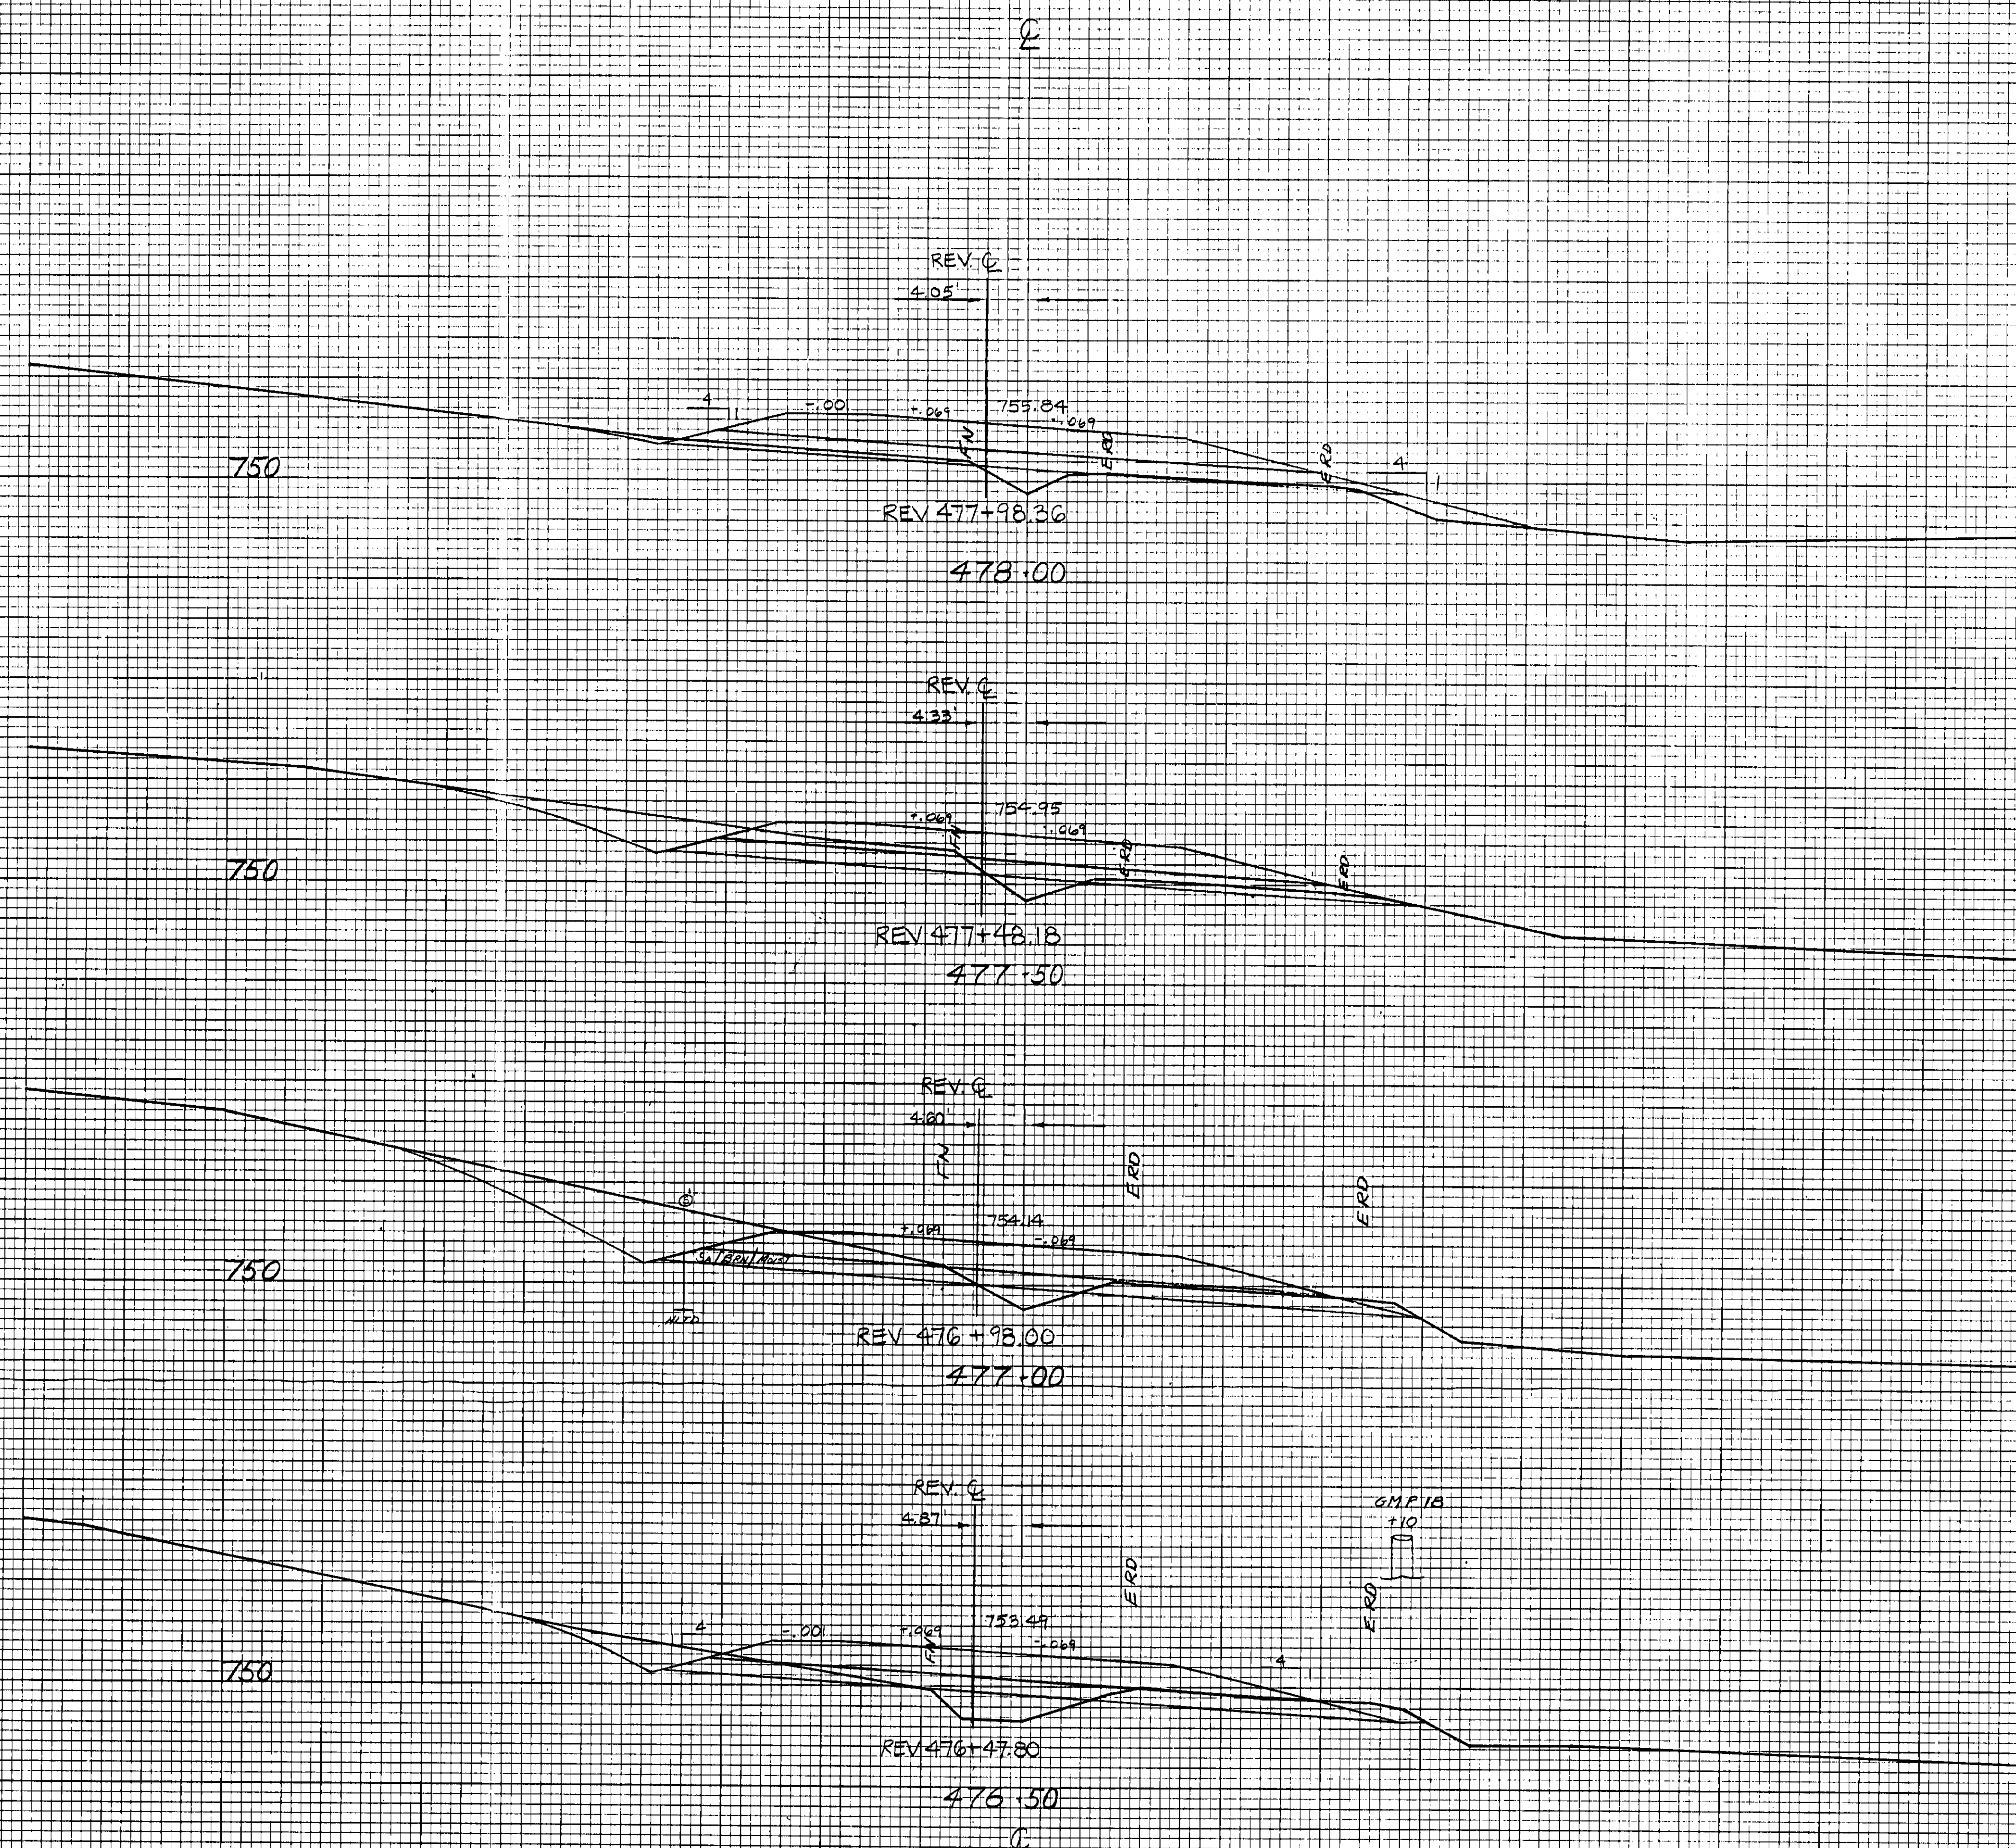

Rev. Sta. 476+39.8 Existing 12"x24" Box Remove
New 48"x 92" PCCSP (10.9) or CAPP (10.5)
#1 Type III Stone Inlet and Outlet
See Sheet 148 for Details

STA 476+48 RT
NEW 6" x 22" UNDERDRAIN
CARRIER PIPE
SEE SHEET 148 FOR DETAILS

CROSS SECTIONS
STA. 476+50 TO STA. 478+00
GRONLAVE GATE FOR 11.00
SHEET 136 OF 152