
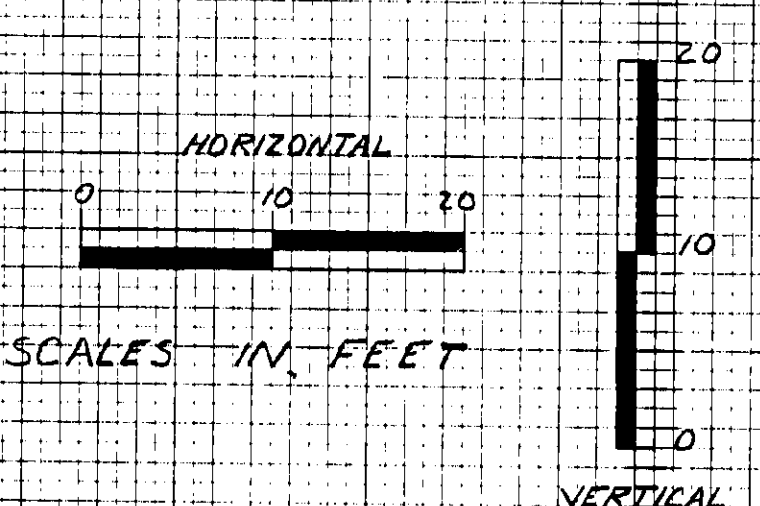


DATE	
BY	
REVISIONS	
NOTED	
TEMPLATE	
AMAS	
NO.	
FINAL SURVEY	
NOTE BOOK	
NO.	

DATE	DEC 86
BY	ECB
REVISIONS	1
NOTED	
TEMPLATE	
AMAS	
NO.	2/2/87
FINAL SURVEY	
NOTE BOOK	
NO.	

DATE	DEC 86
BY	ECB
REVISIONS	1
NOTED	
TEMPLATE	
AMAS	
NO.	2/2/87
FINAL SURVEY	
NOTE BOOK	
NO.	

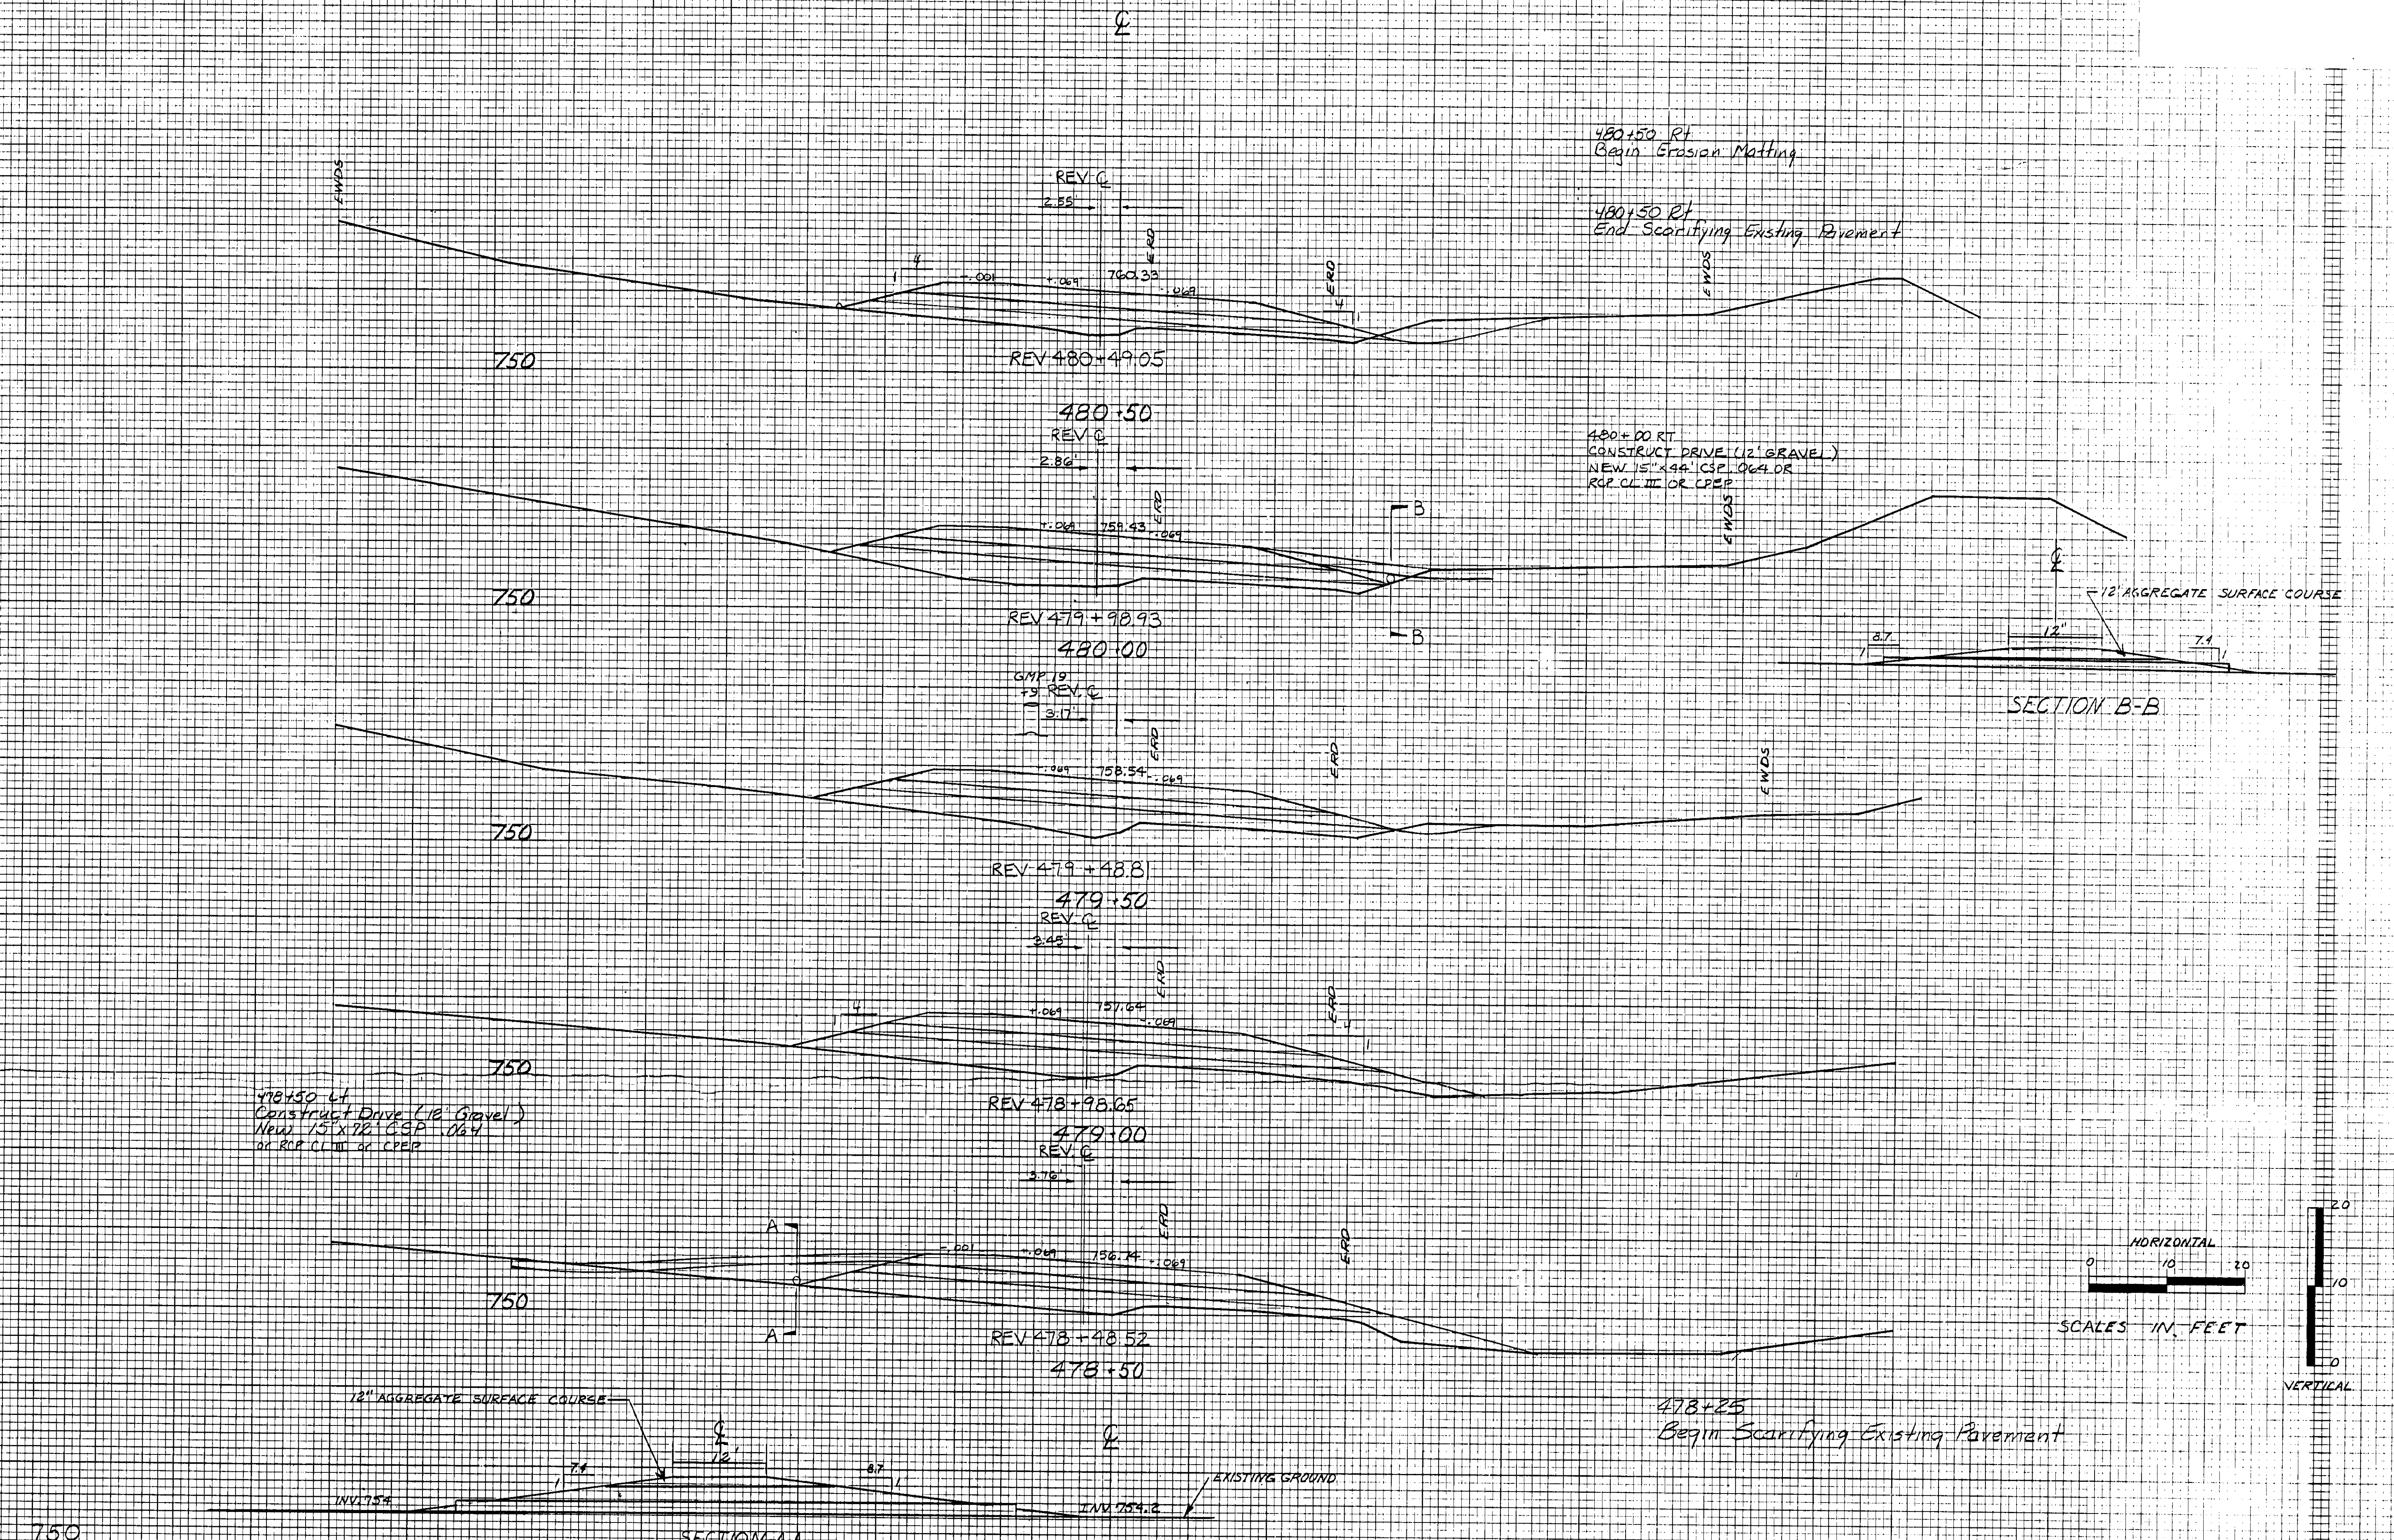

CROSS SECTIONS
 STA. 478+50 TO STA. 480+50
 GRAYSON - RYE GATE RD 16-1(3)
 SHEET 137 OF 152