
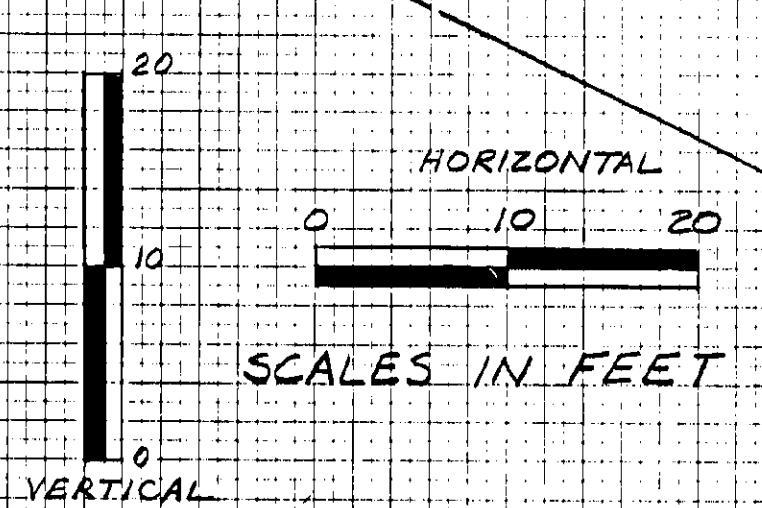
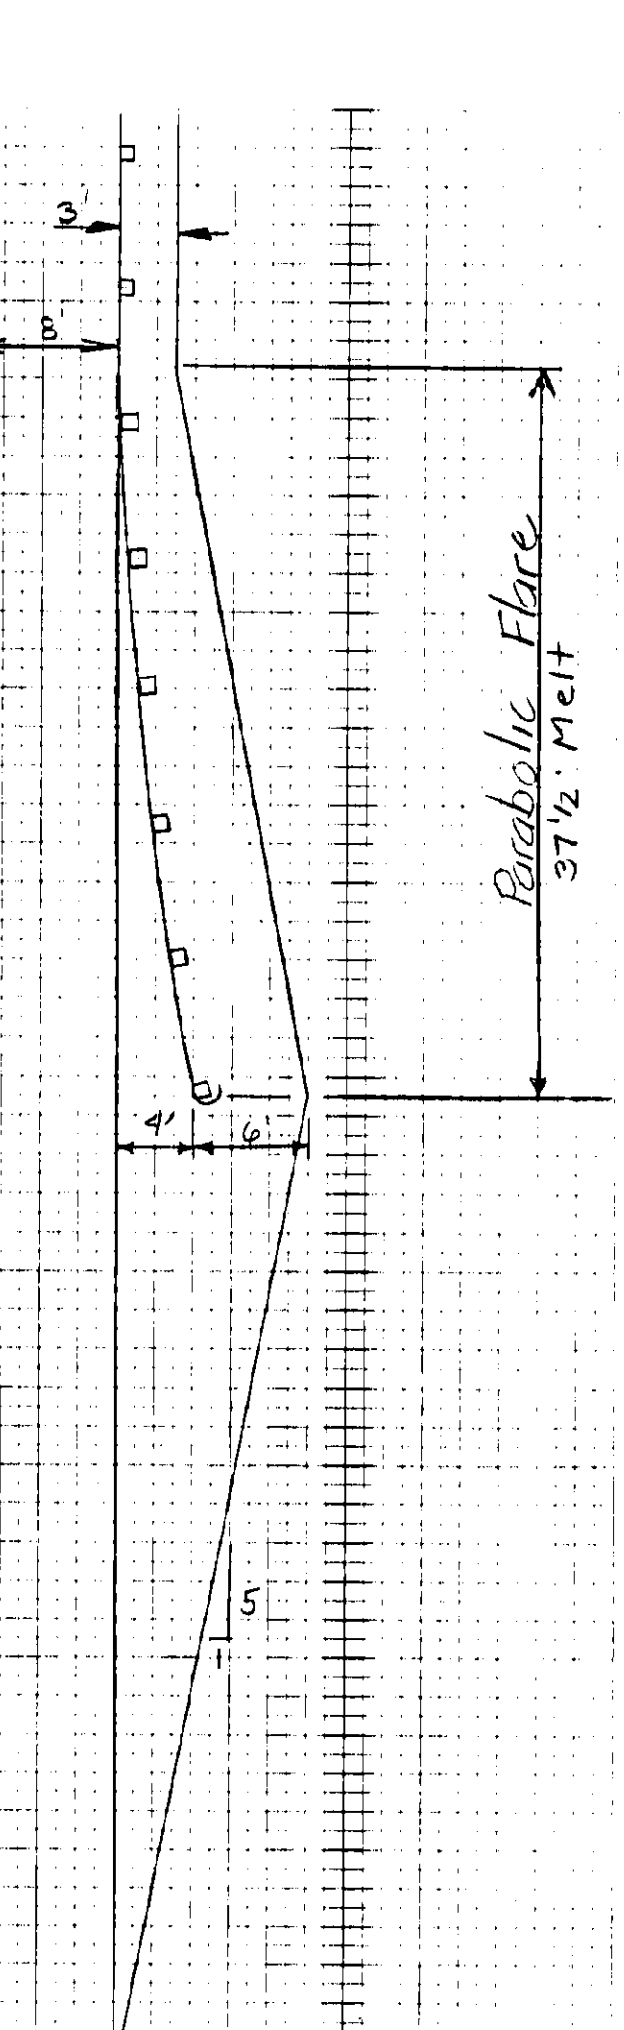


DATE	
BY	
CHECKED	
DESIGNED	
PLOTTED	
REVISIONS	
NO. 1	
NO. 2	
NO. 3	
NO. 100	

DATE	
BY	
CHECKED	
DESIGNED	
PLOTTED	
REVISIONS	
NO. 1	
NO. 2	
NO. 3	
NO. 100	

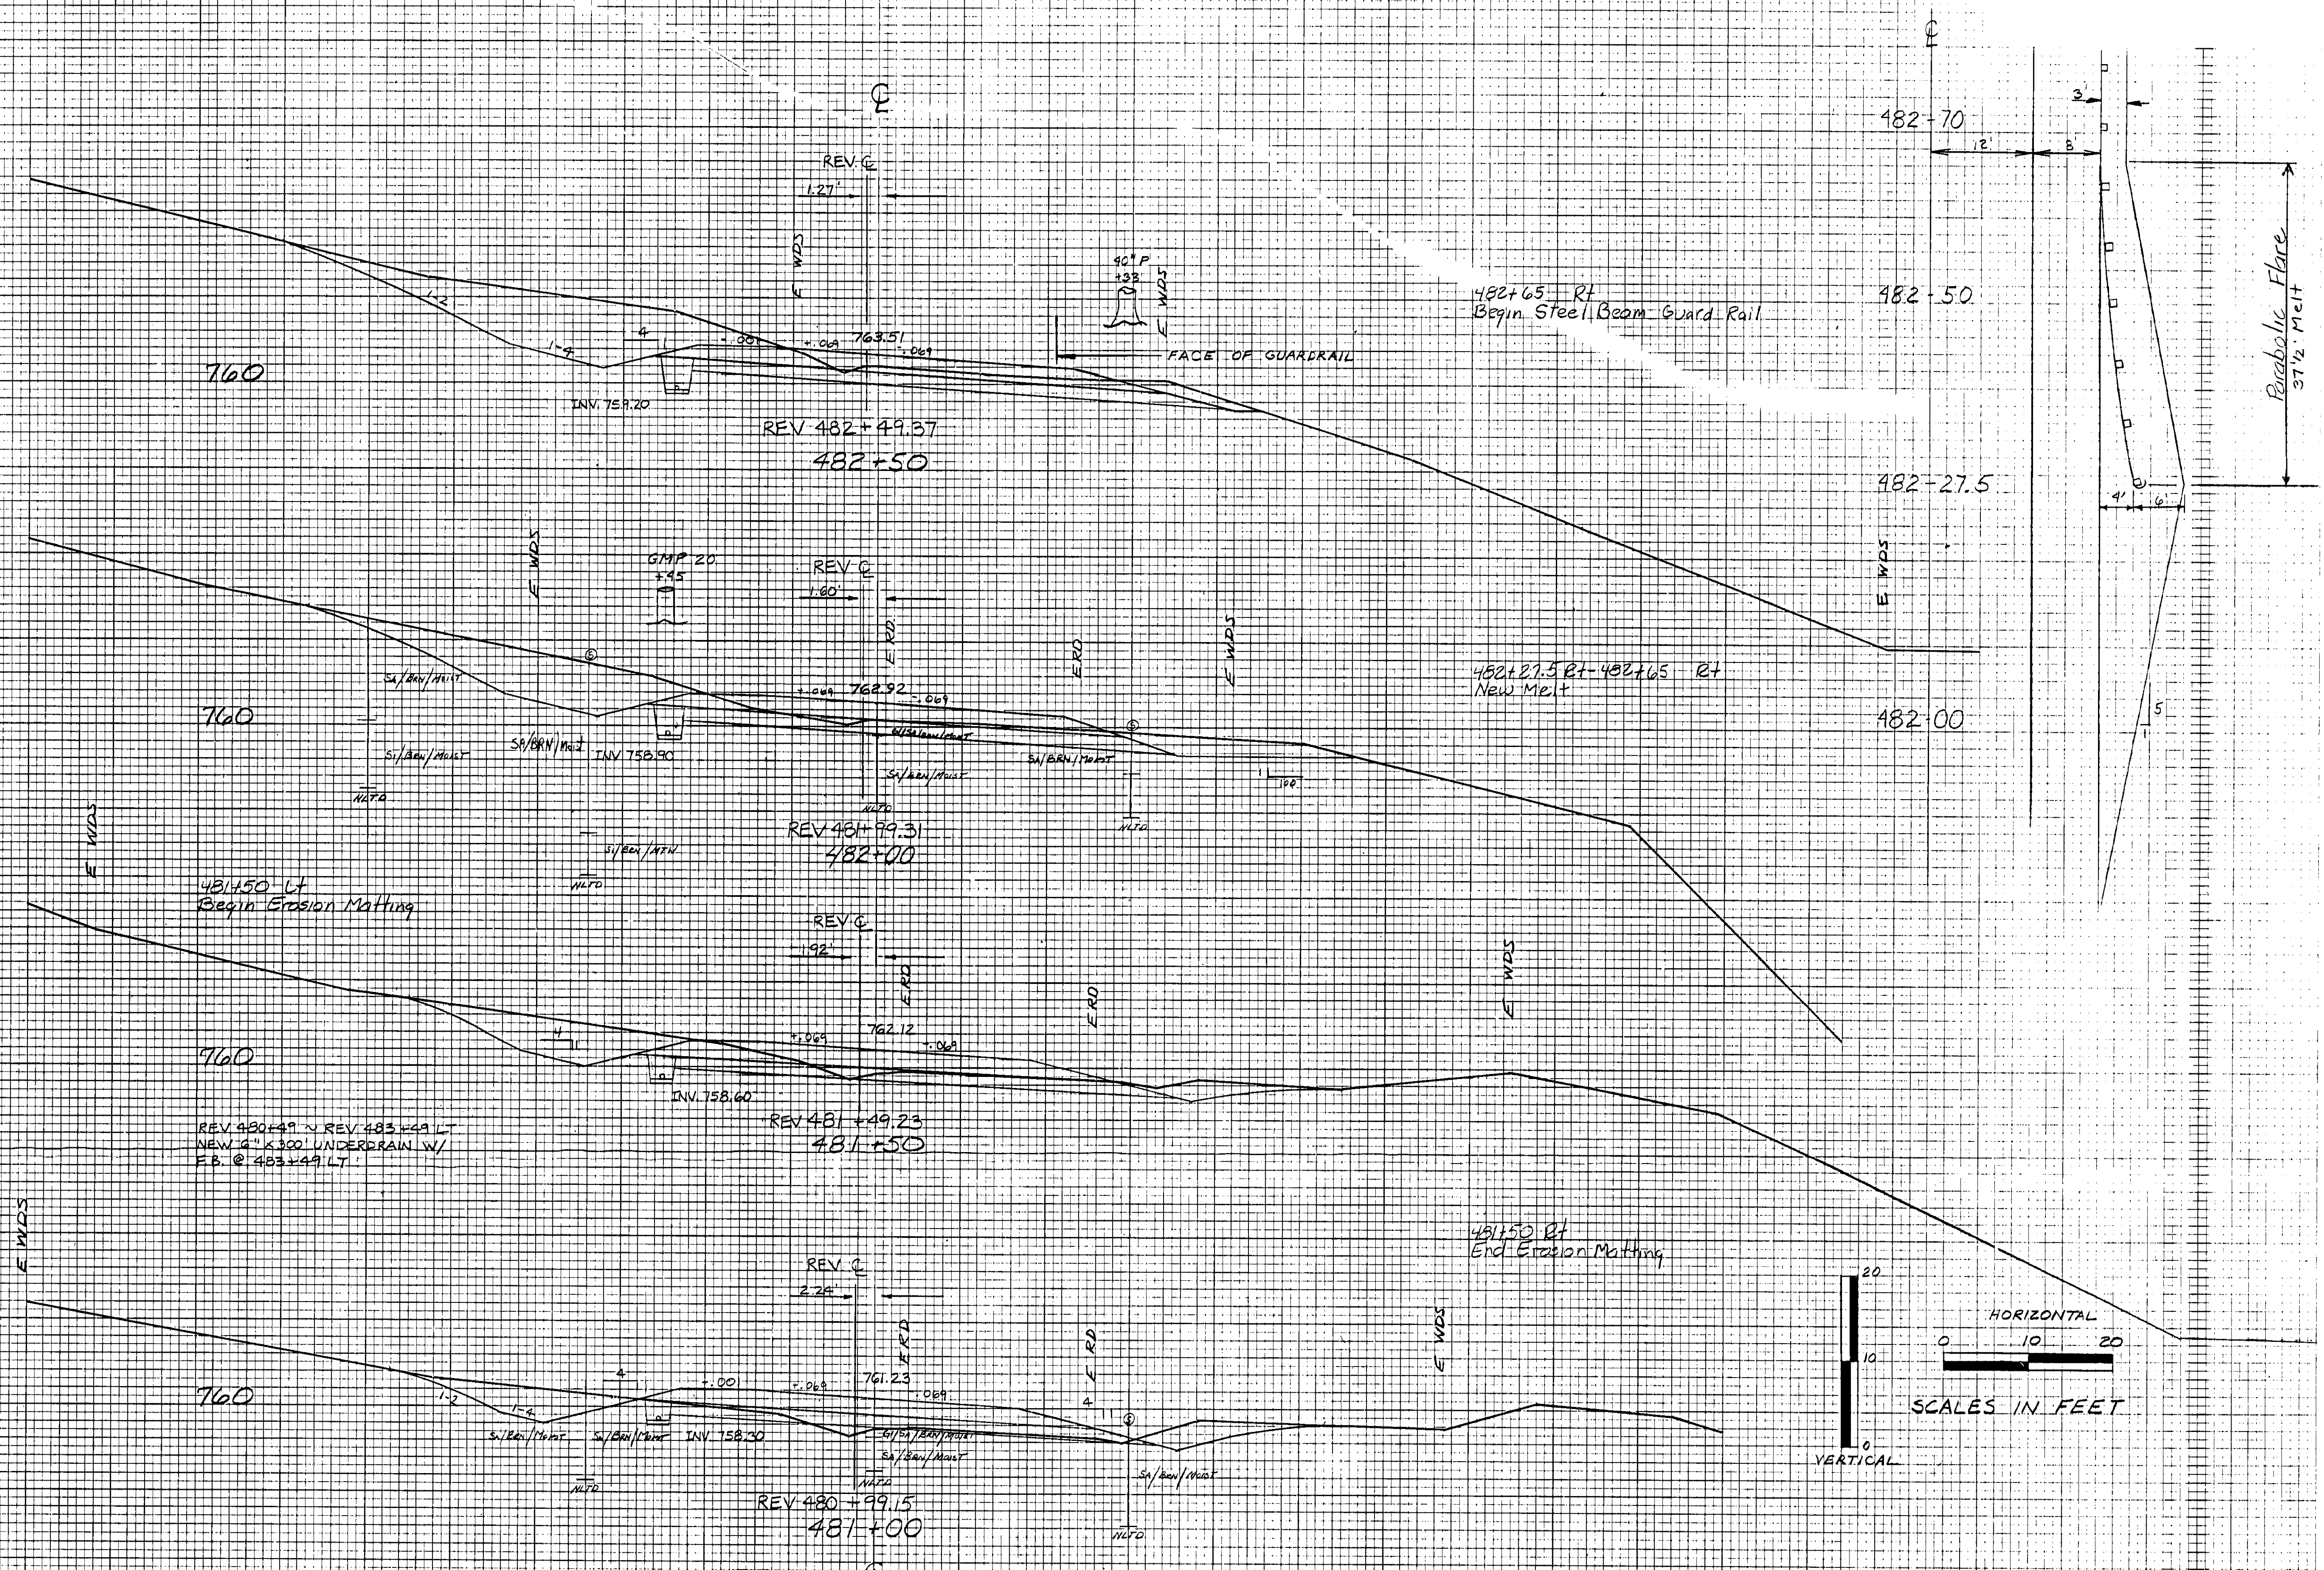

CROSS SECTIONS
 STA. 481+00 TO STA. 482+70
 BEYOND - EYELET F02671 (30)
 SHEET 130 OF 152