
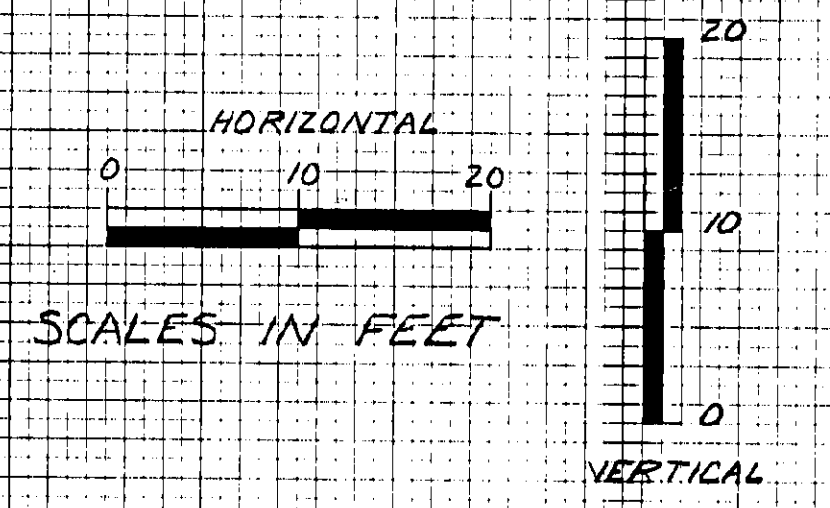


DATE	
BY	
SURVEYED	
PLOTTED	
NOTED	
NO. OF SHEETS	
NO. OF SHEETS CHECKED	
FINAL SURVEY	
NOTE BOOK	
NO.	

DATE	DEC 86
BY	CS, KGL, CFP
SURVEYED	CS, KGL, CFP
PLOTTED	CS, KGL, CFP
NOTED	CS, KGL, CFP
NO. OF SHEETS	32
NO. OF SHEETS CHECKED	32
ORIGINAL SURVEY	
NOTE BOOK	
NO.	

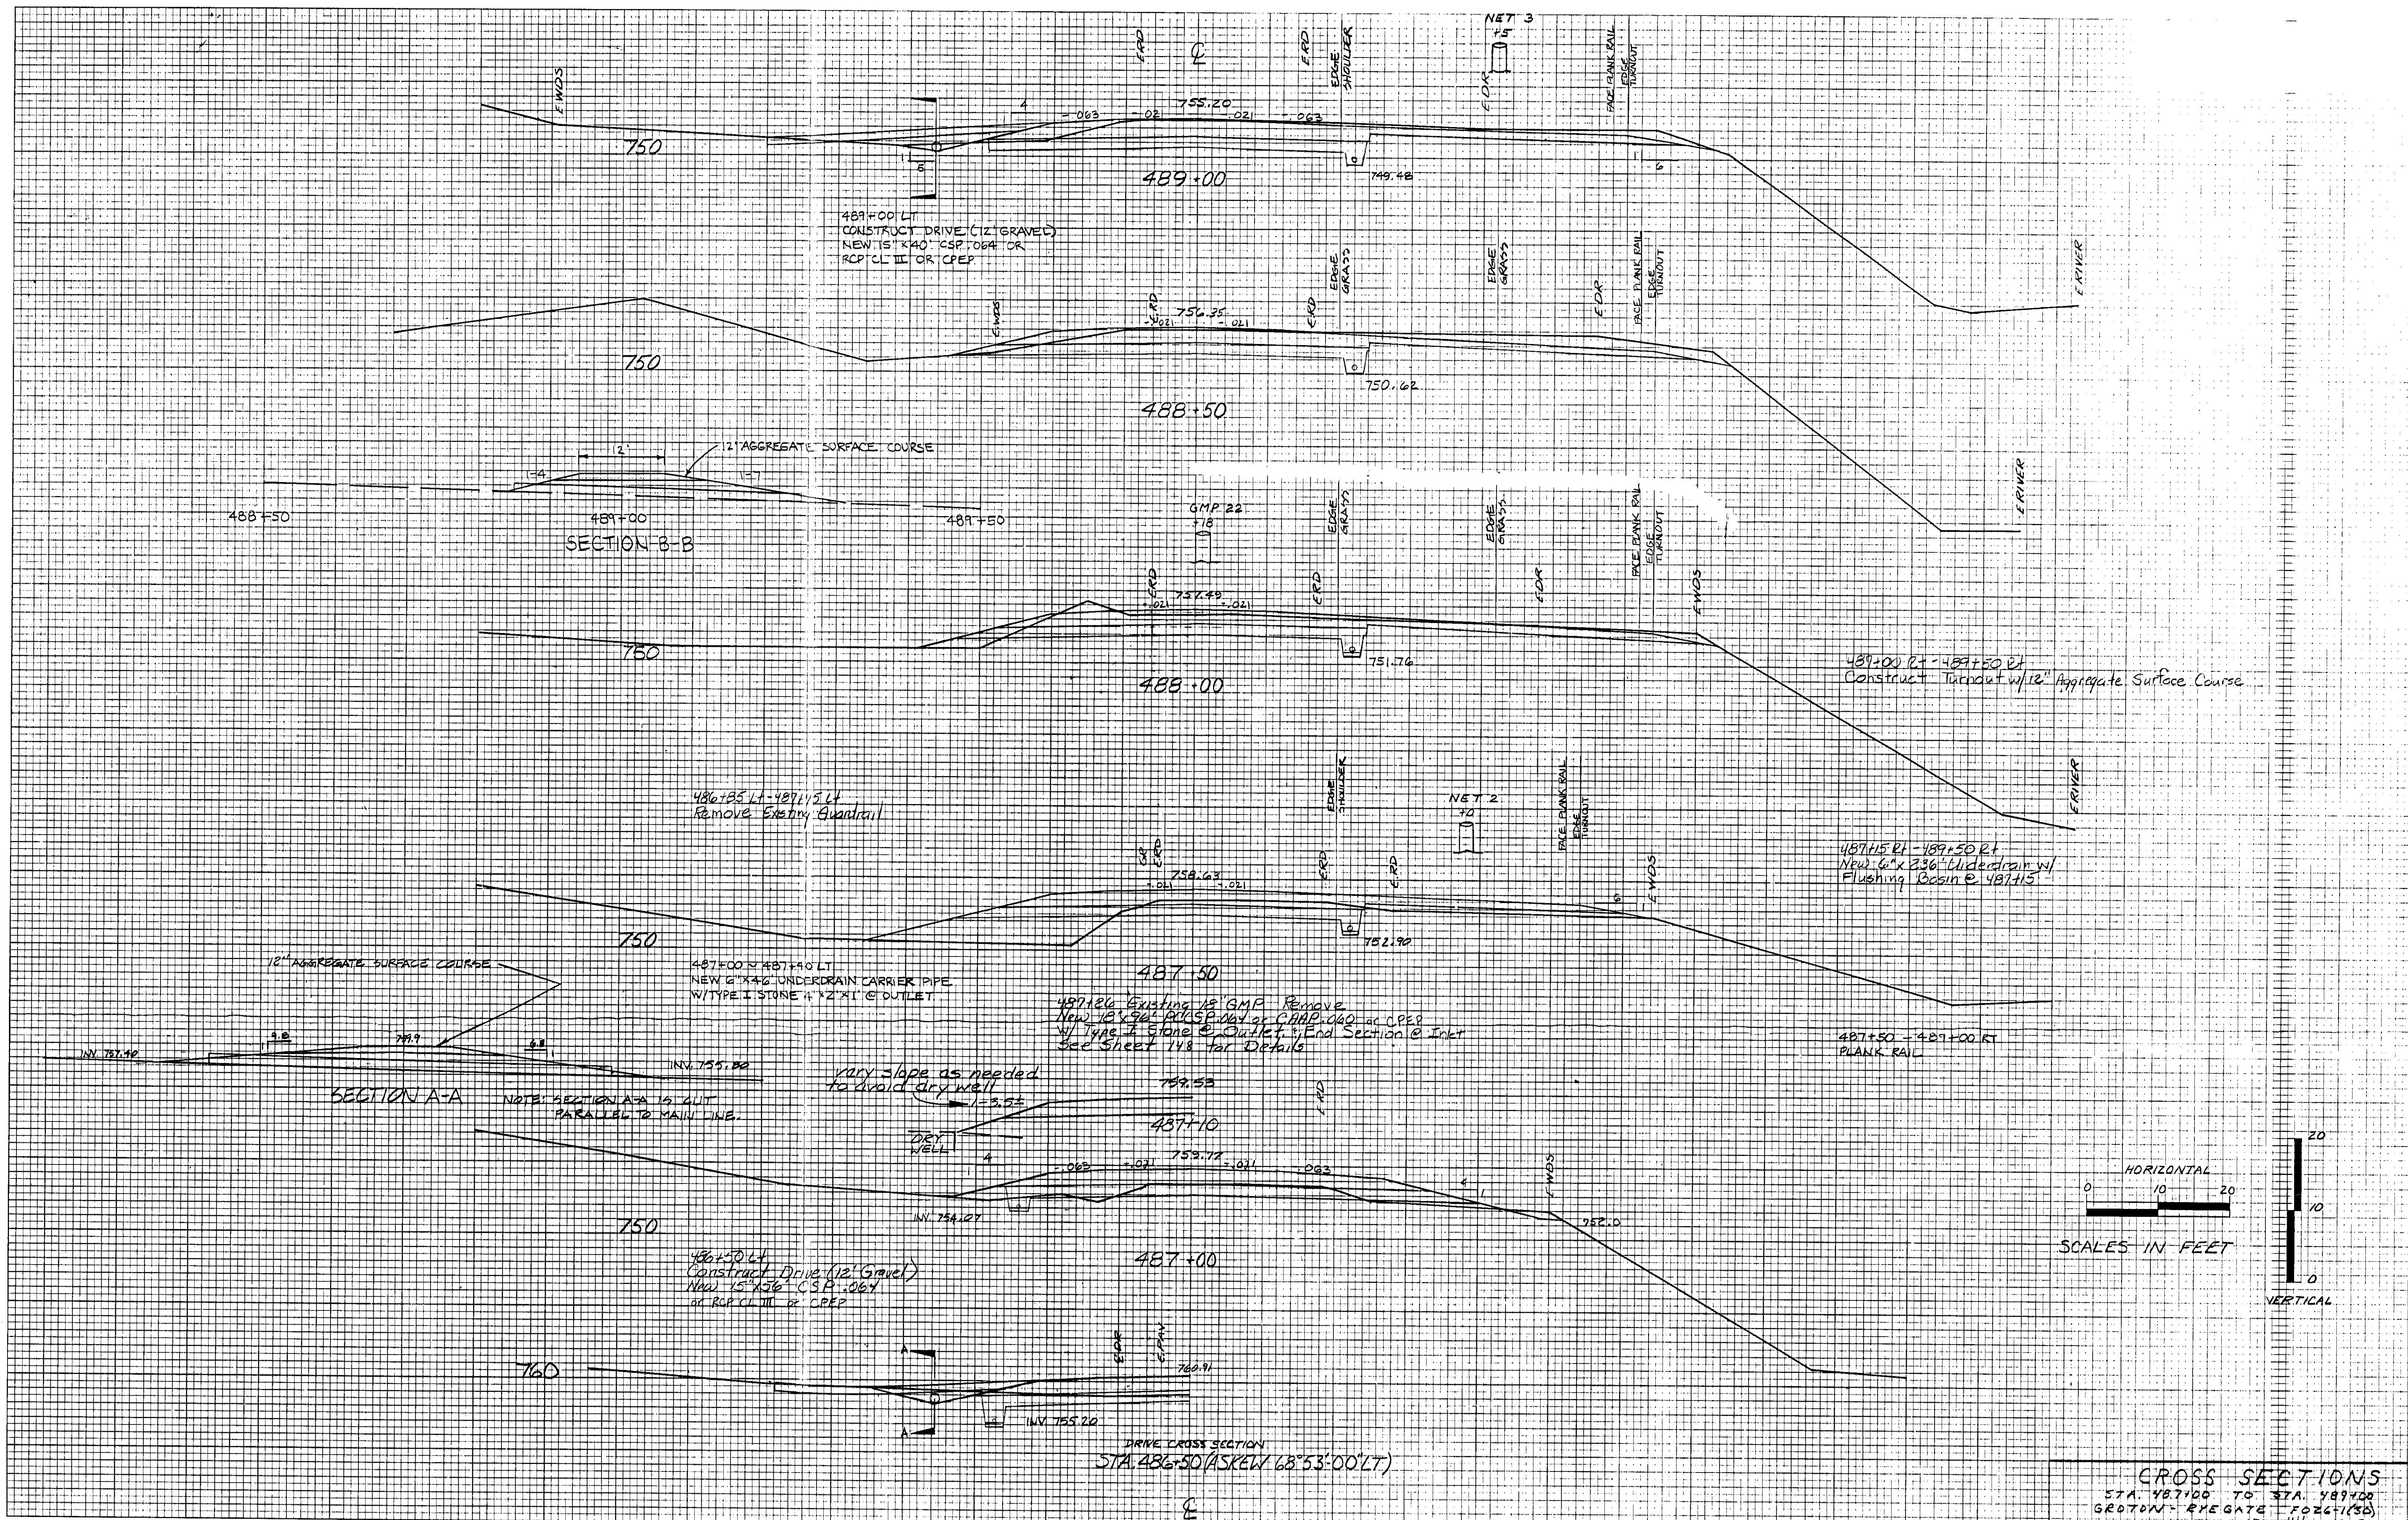

CROSS SECTIONS  
 STA. 487+00 TO STA. 489+00  
 GROTON EYE GATE F026-1(SB)  
 SHEET 141 OF 152