
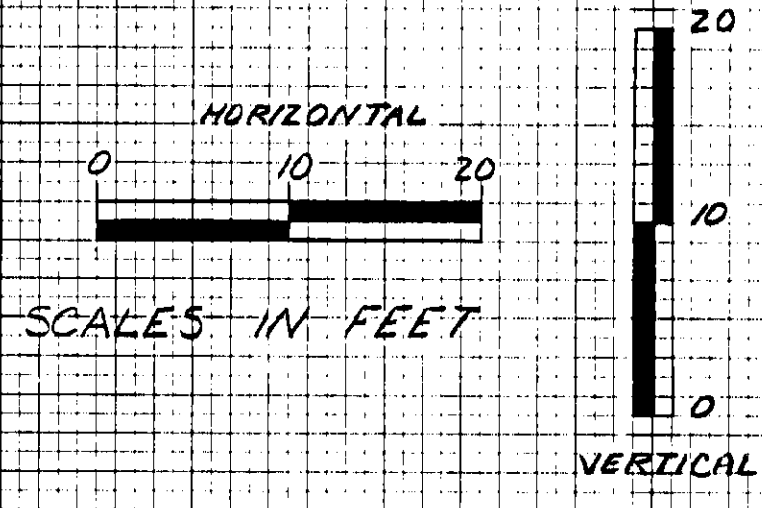


FINAL SURVEY NOTE BOOK No. \_\_\_\_\_  
 DATE \_\_\_\_\_  
 BY \_\_\_\_\_  
 CHECKED \_\_\_\_\_  
 DATE CHECKED \_\_\_\_\_

ORIGINAL SURVEY NOTE BOOK No. 62-1432  
 DATE \_\_\_\_\_  
 BY \_\_\_\_\_  
 CHECKED \_\_\_\_\_  
 DATE CHECKED \_\_\_\_\_

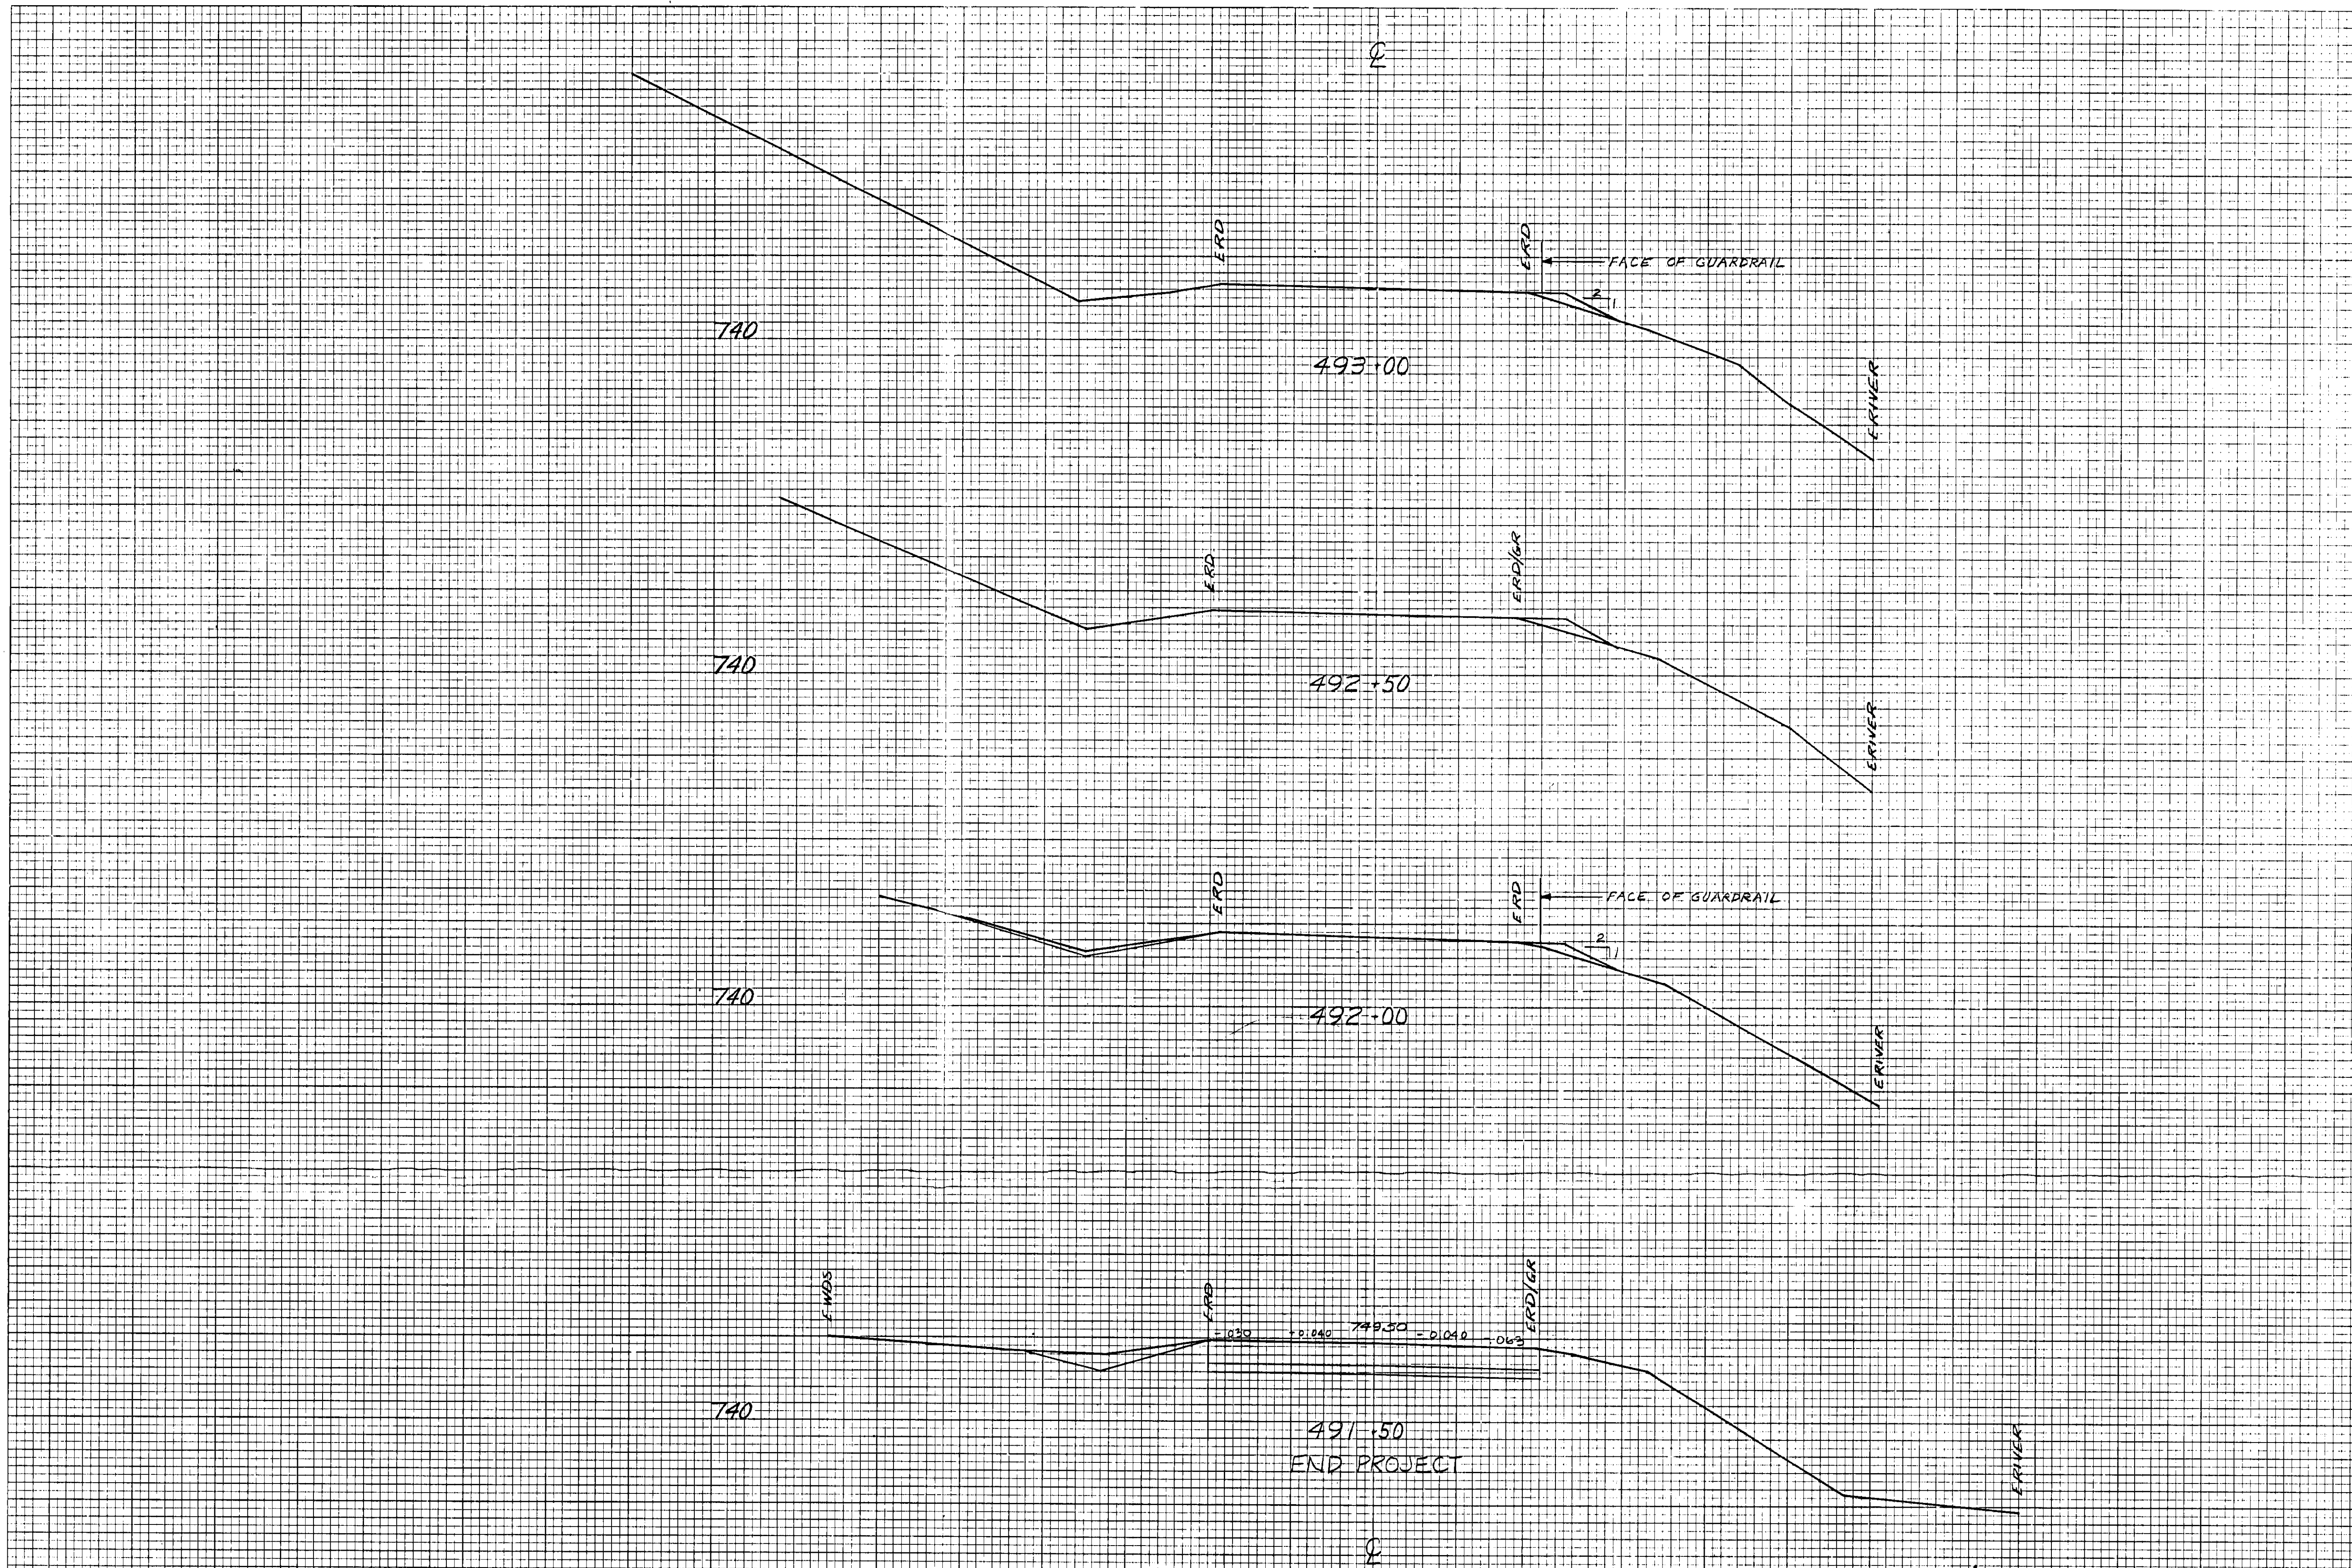

CROSS SECTIONS  
 STA. 491.50 TO STA. 493.00  
 GROTON - RYEGATE, F026-1130  
 SHEET 143 OF 152