
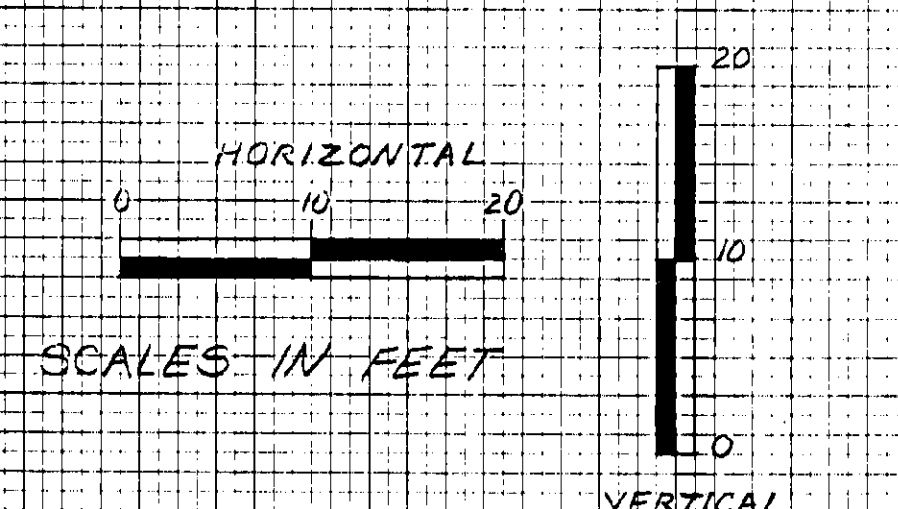
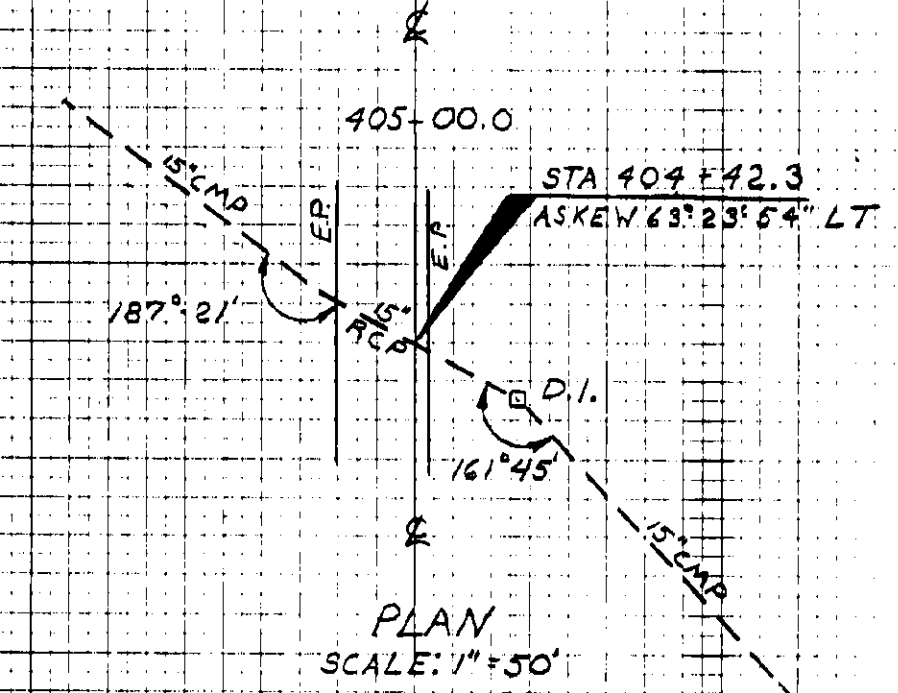


DATE	
BY	
SURVEYED	
PLOTTED	
NOTE BOOK	
NO.	

DATE	APR 06
BY	REP. LEES
SURVEYED	PAU
PLOTTED	PAU
NOTE BOOK	PAU
NO.	637

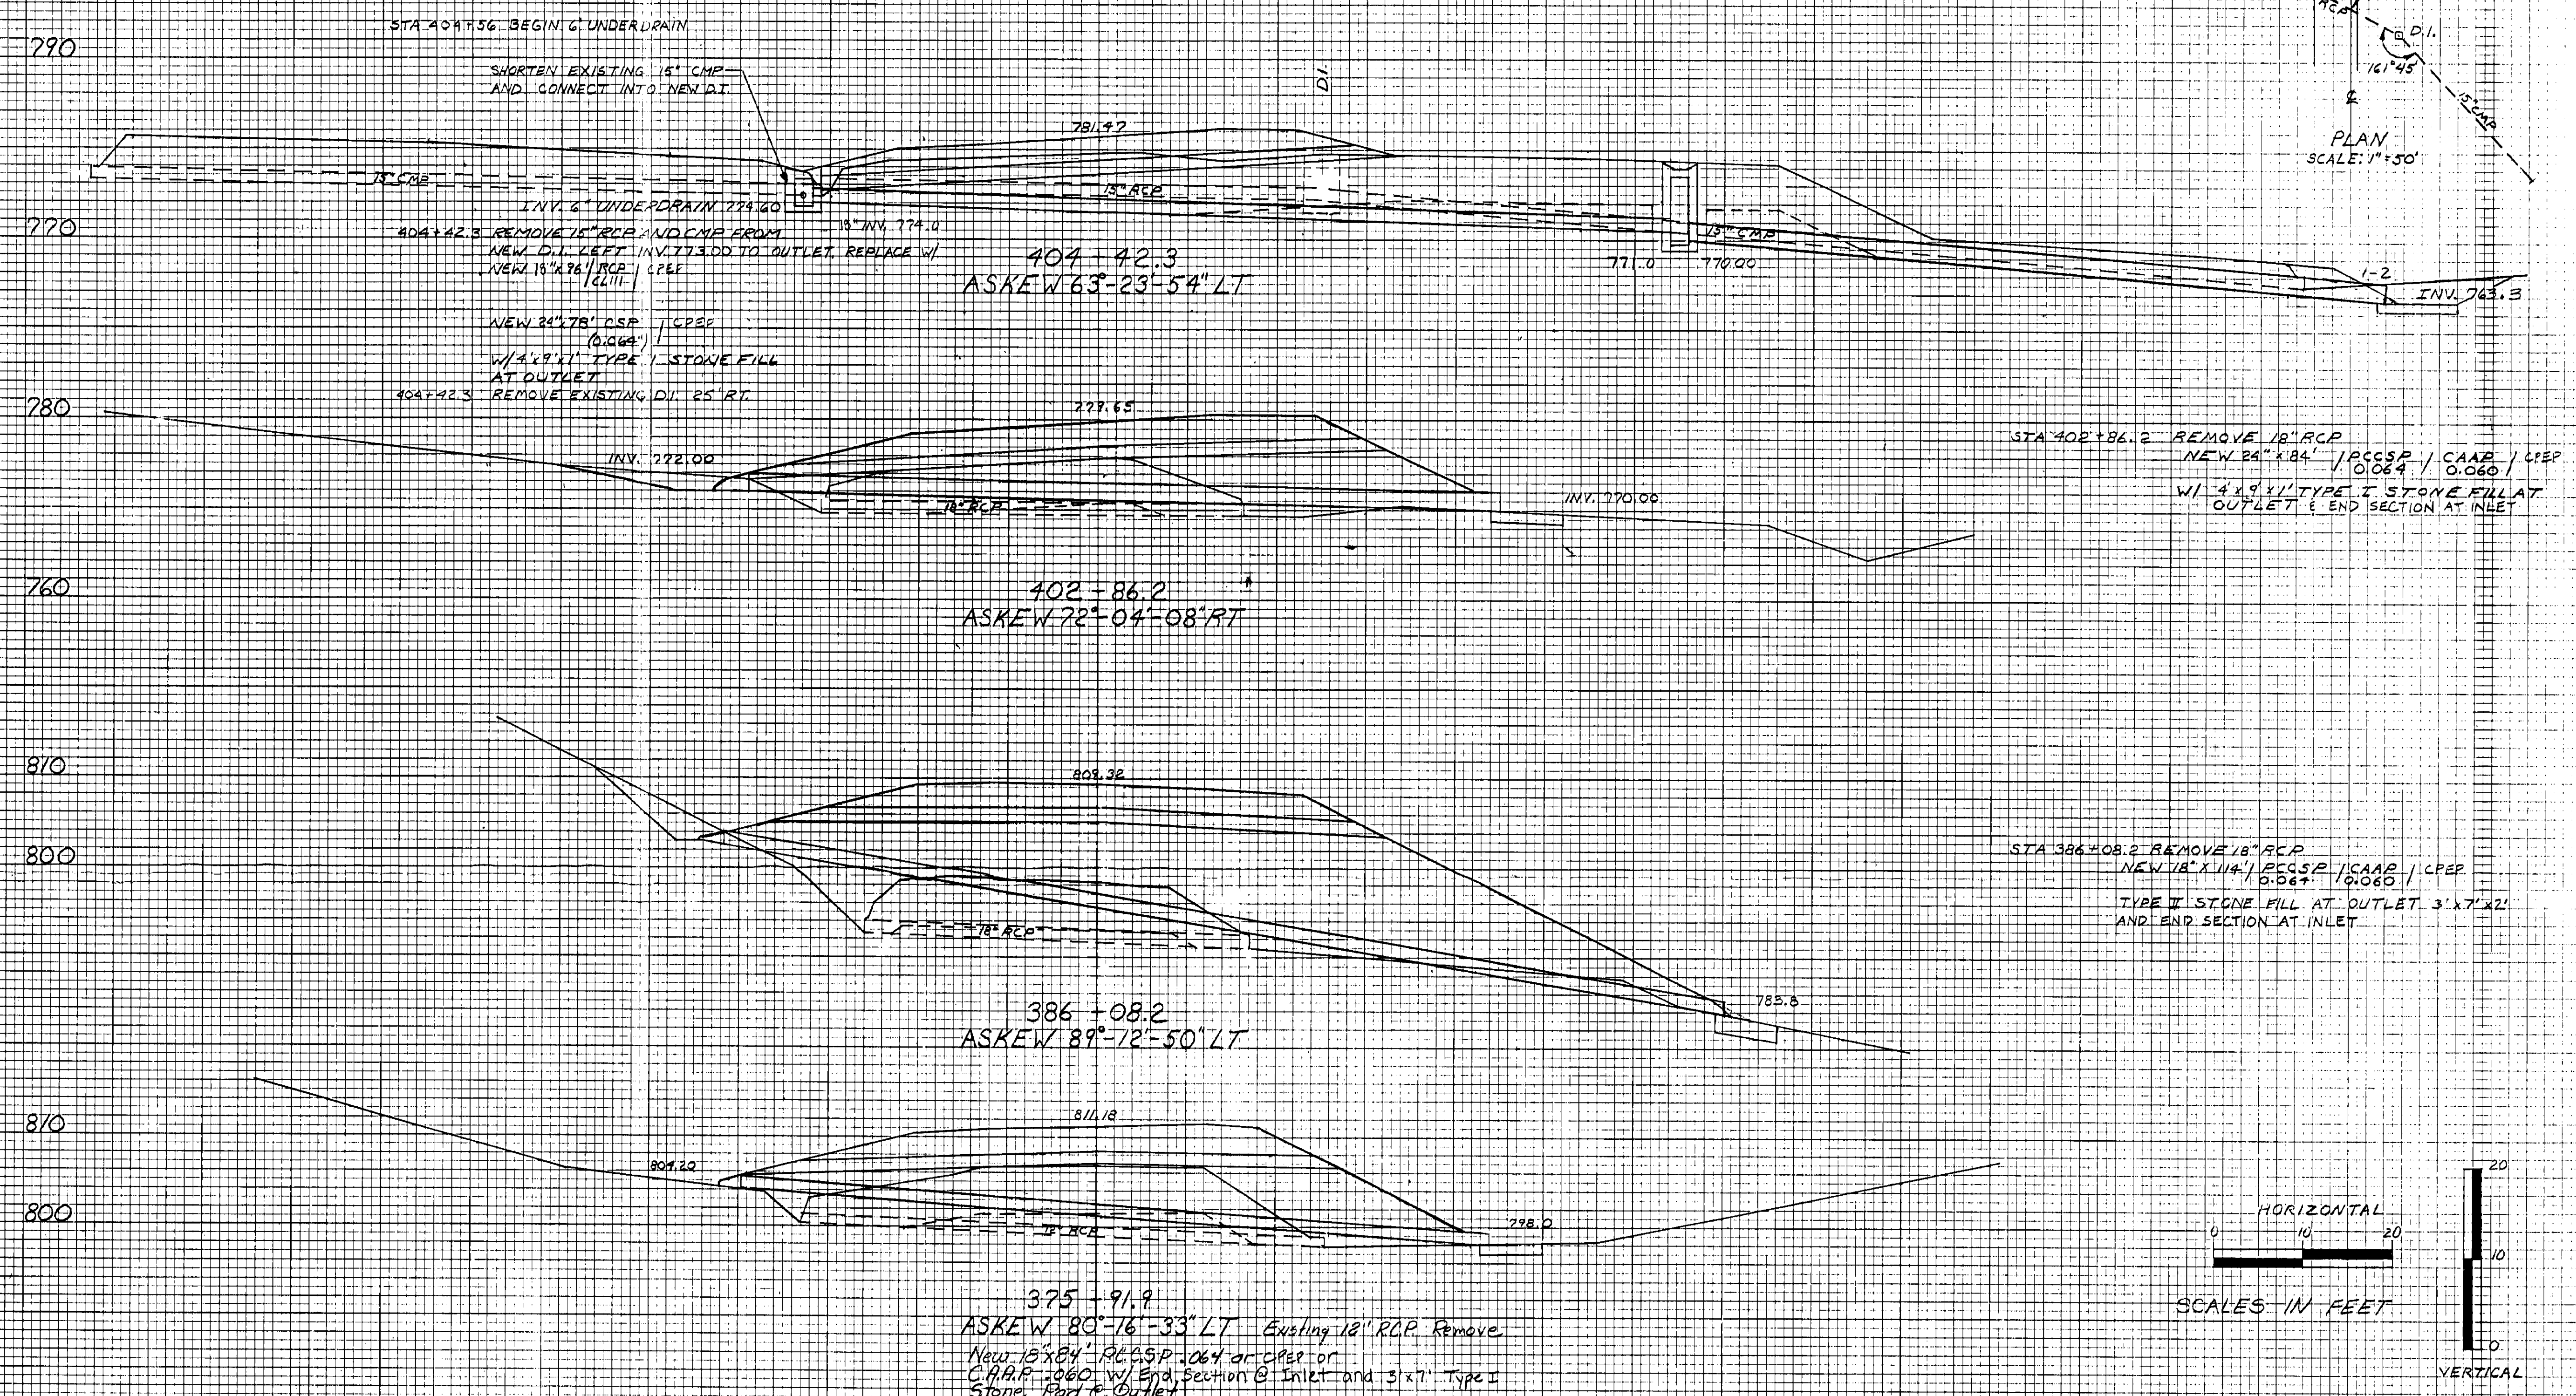

CROSS SECTIONS
 STA 375+92 TO STA 404+42
 GROTON RYE GATE FOREBAY (30)
 SHEET 141 OF 152