
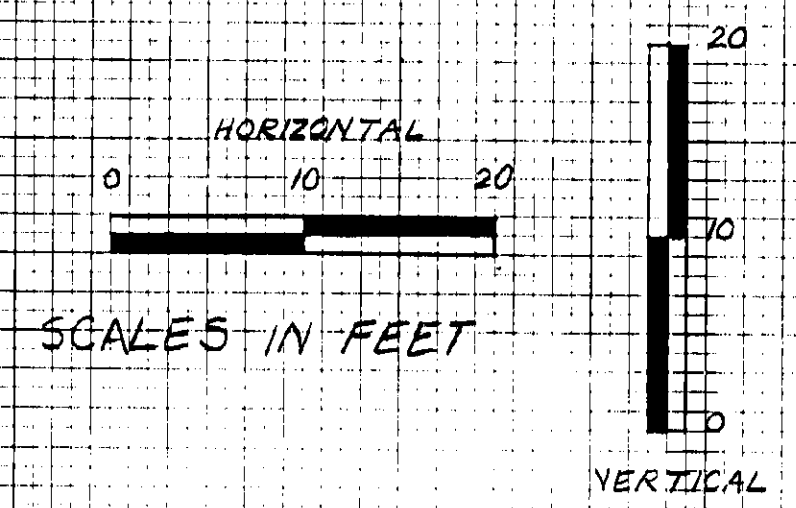


DATE  
BY  
SURVEYED  
PLOTTED  
CHECKED  
FINAL SURVEY NOTE BOOK No. 557

DATE  
BY  
SURVEYED  
PLOTTED  
CHECKED  
ORIGINAL SURVEY NOTE BOOK No. 557

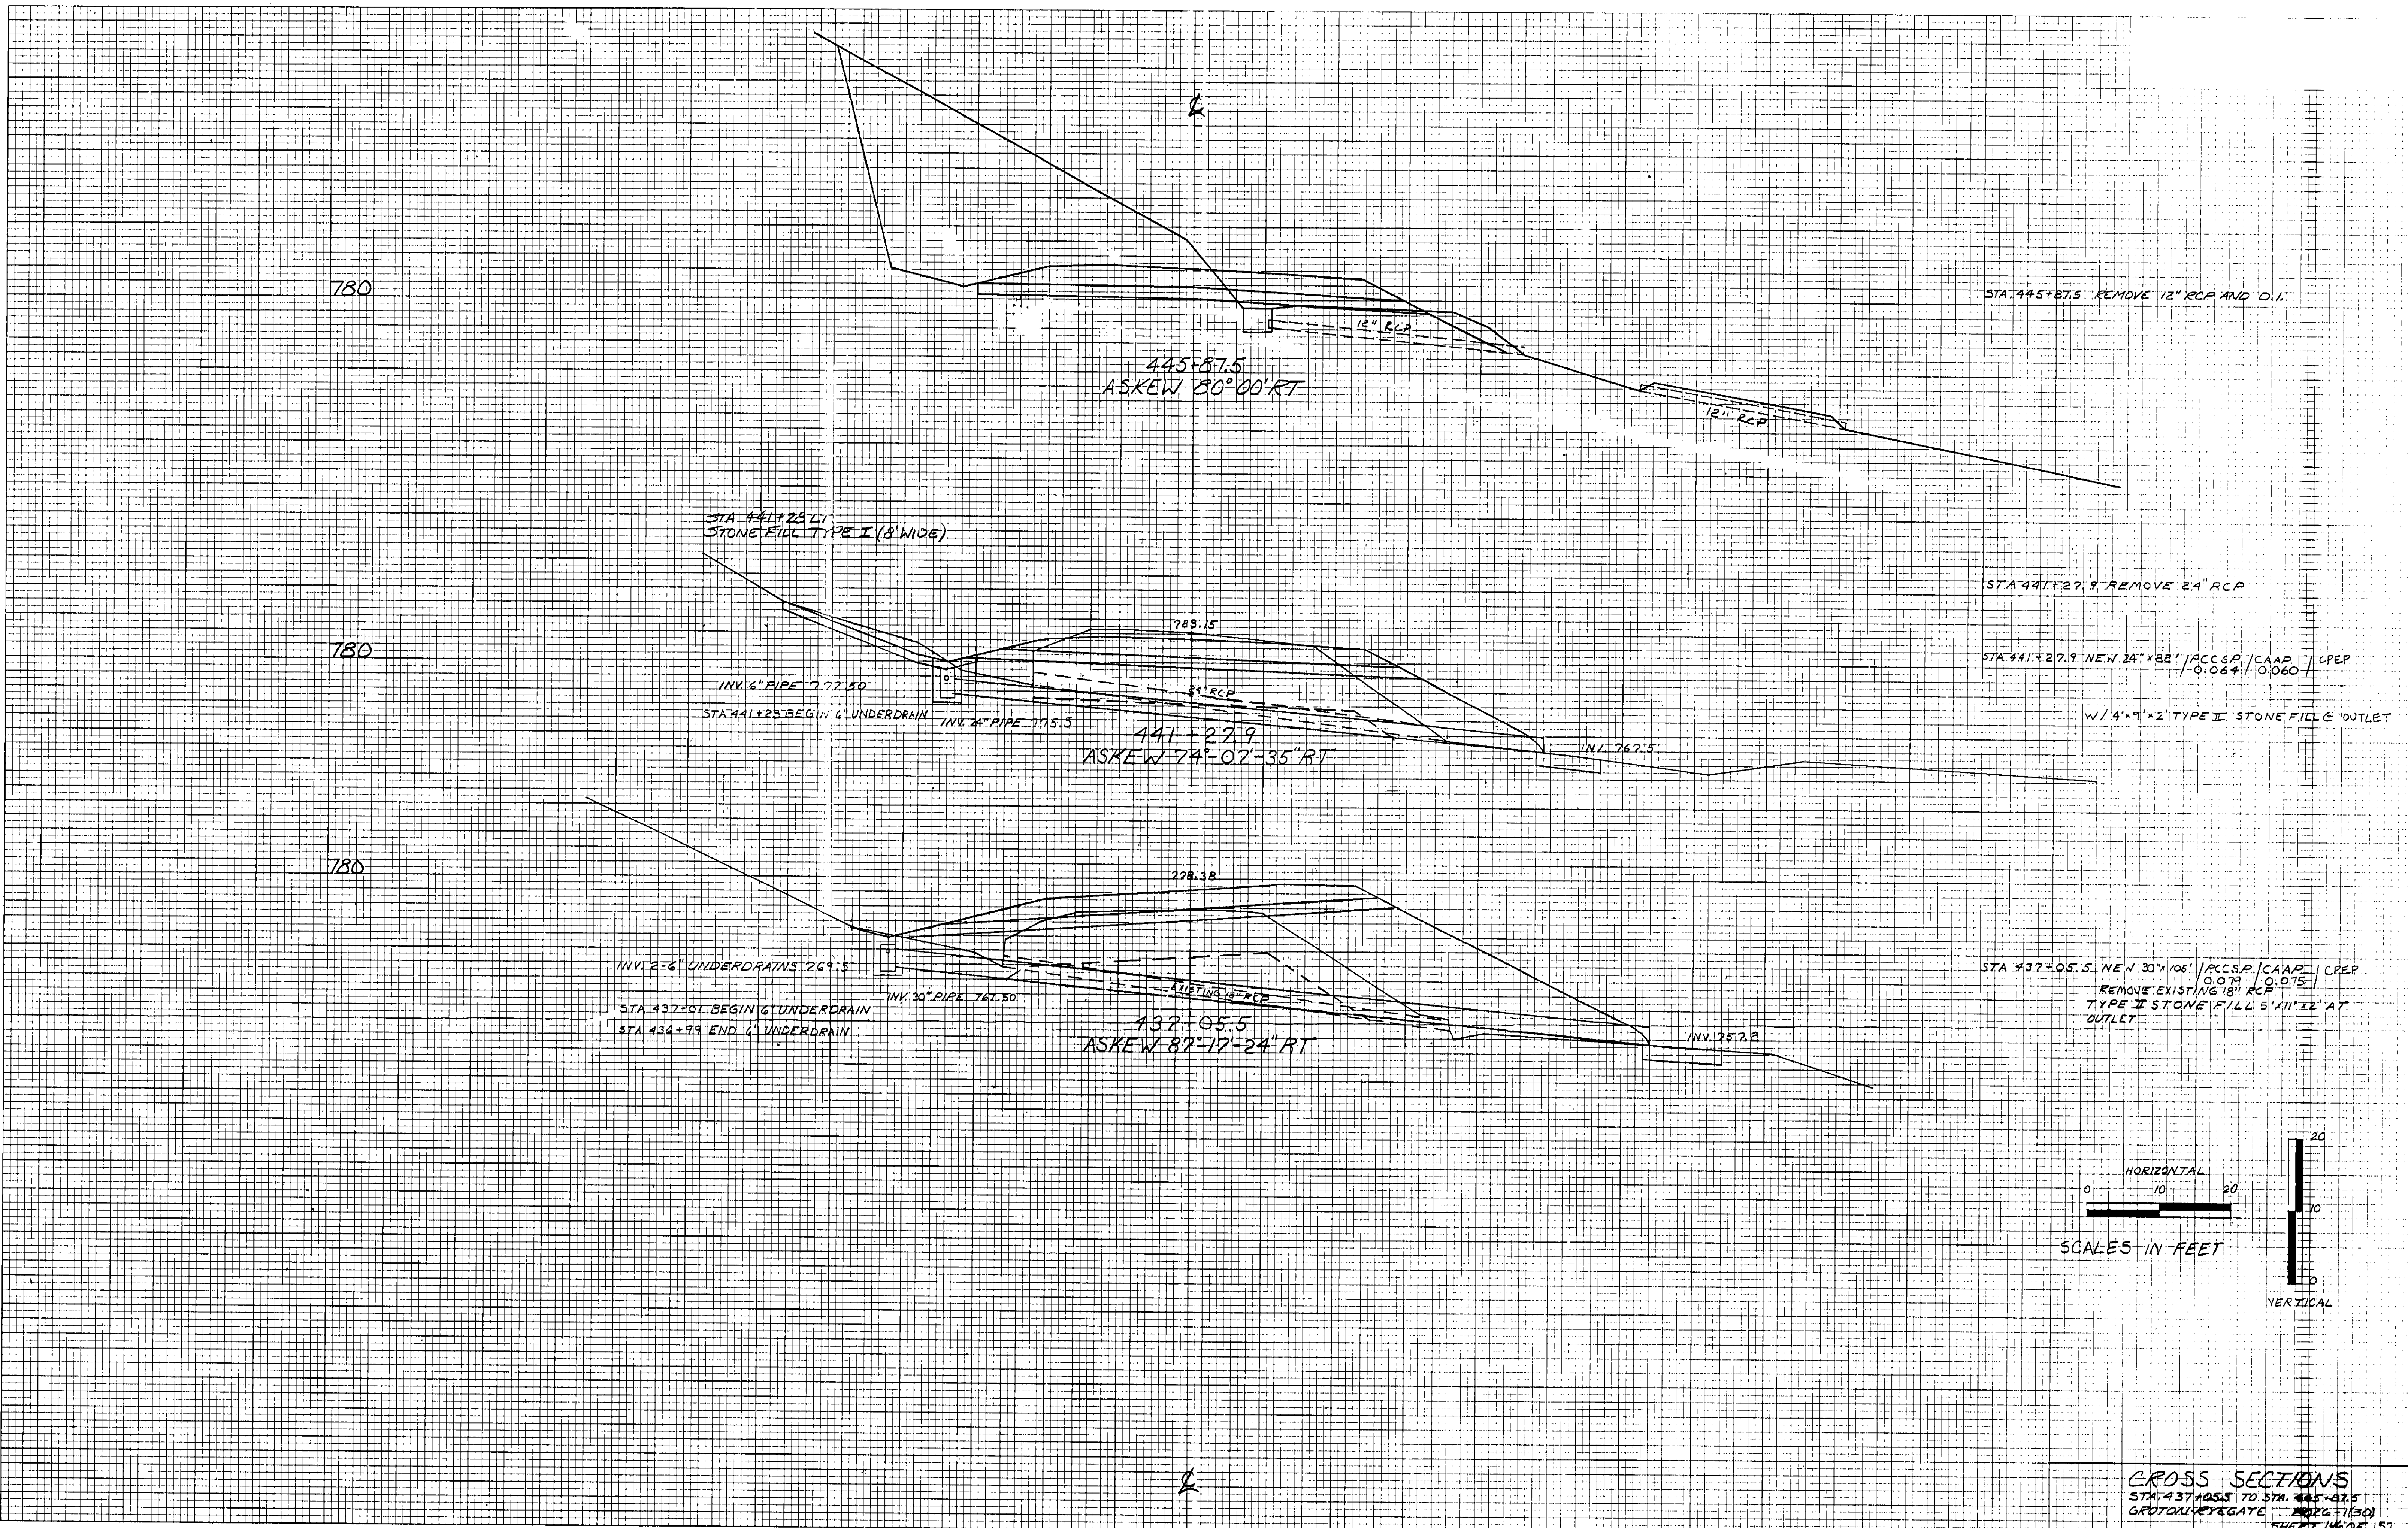

CROSS SECTIONS  
 STA. 437+05.5 TO STA. 445+87.5  
 GROUT/VEGETATE  
 SHEET 146 OF 152