



DATE  
BY  
APPROVED  
PLOTTED  
TEMP. AT  
NO. 647  
AREAS CHECKED

DATE  
BY  
APPROVED  
PLOTTED  
TEMP. AT  
NO. 647  
AREAS CHECKED

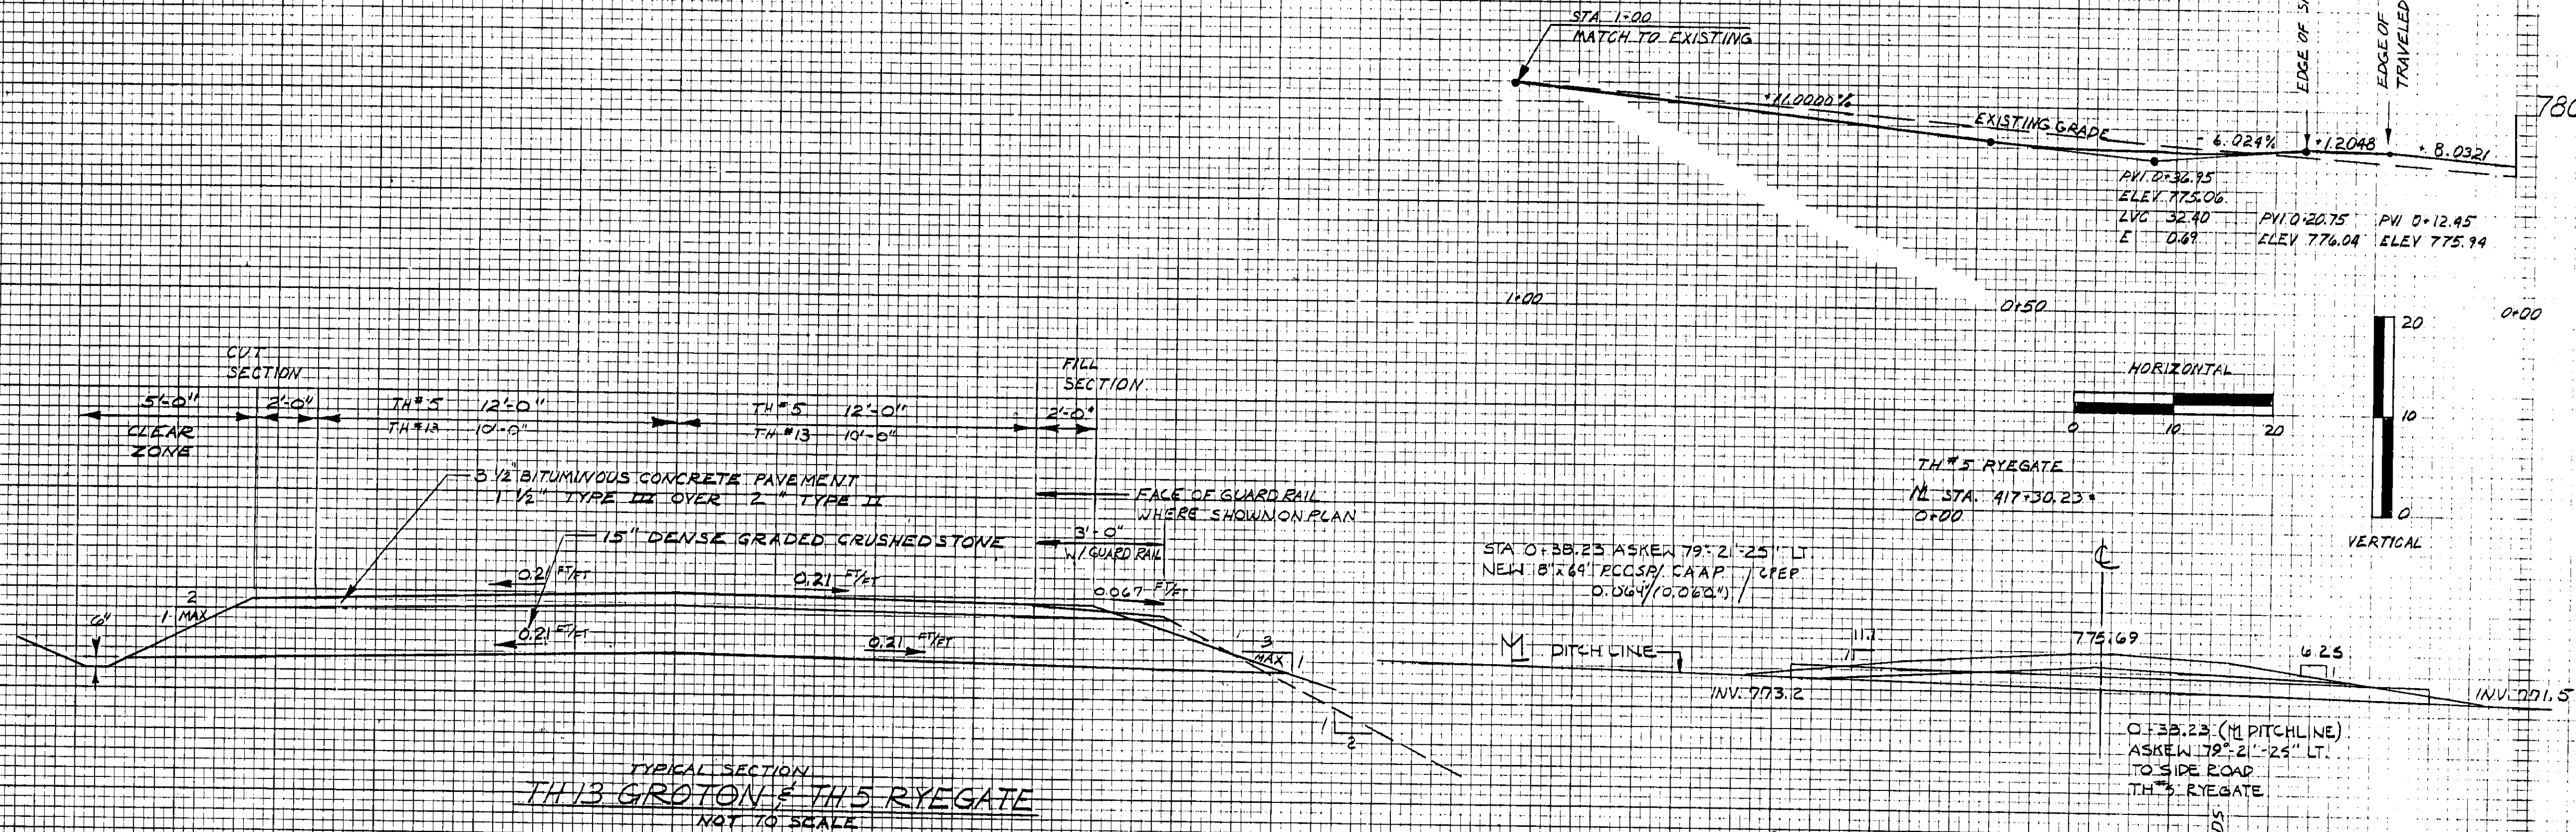

TYPICAL SECTION TH#3 GROTON & TH#5 RYEGATE NOT TO SCALE

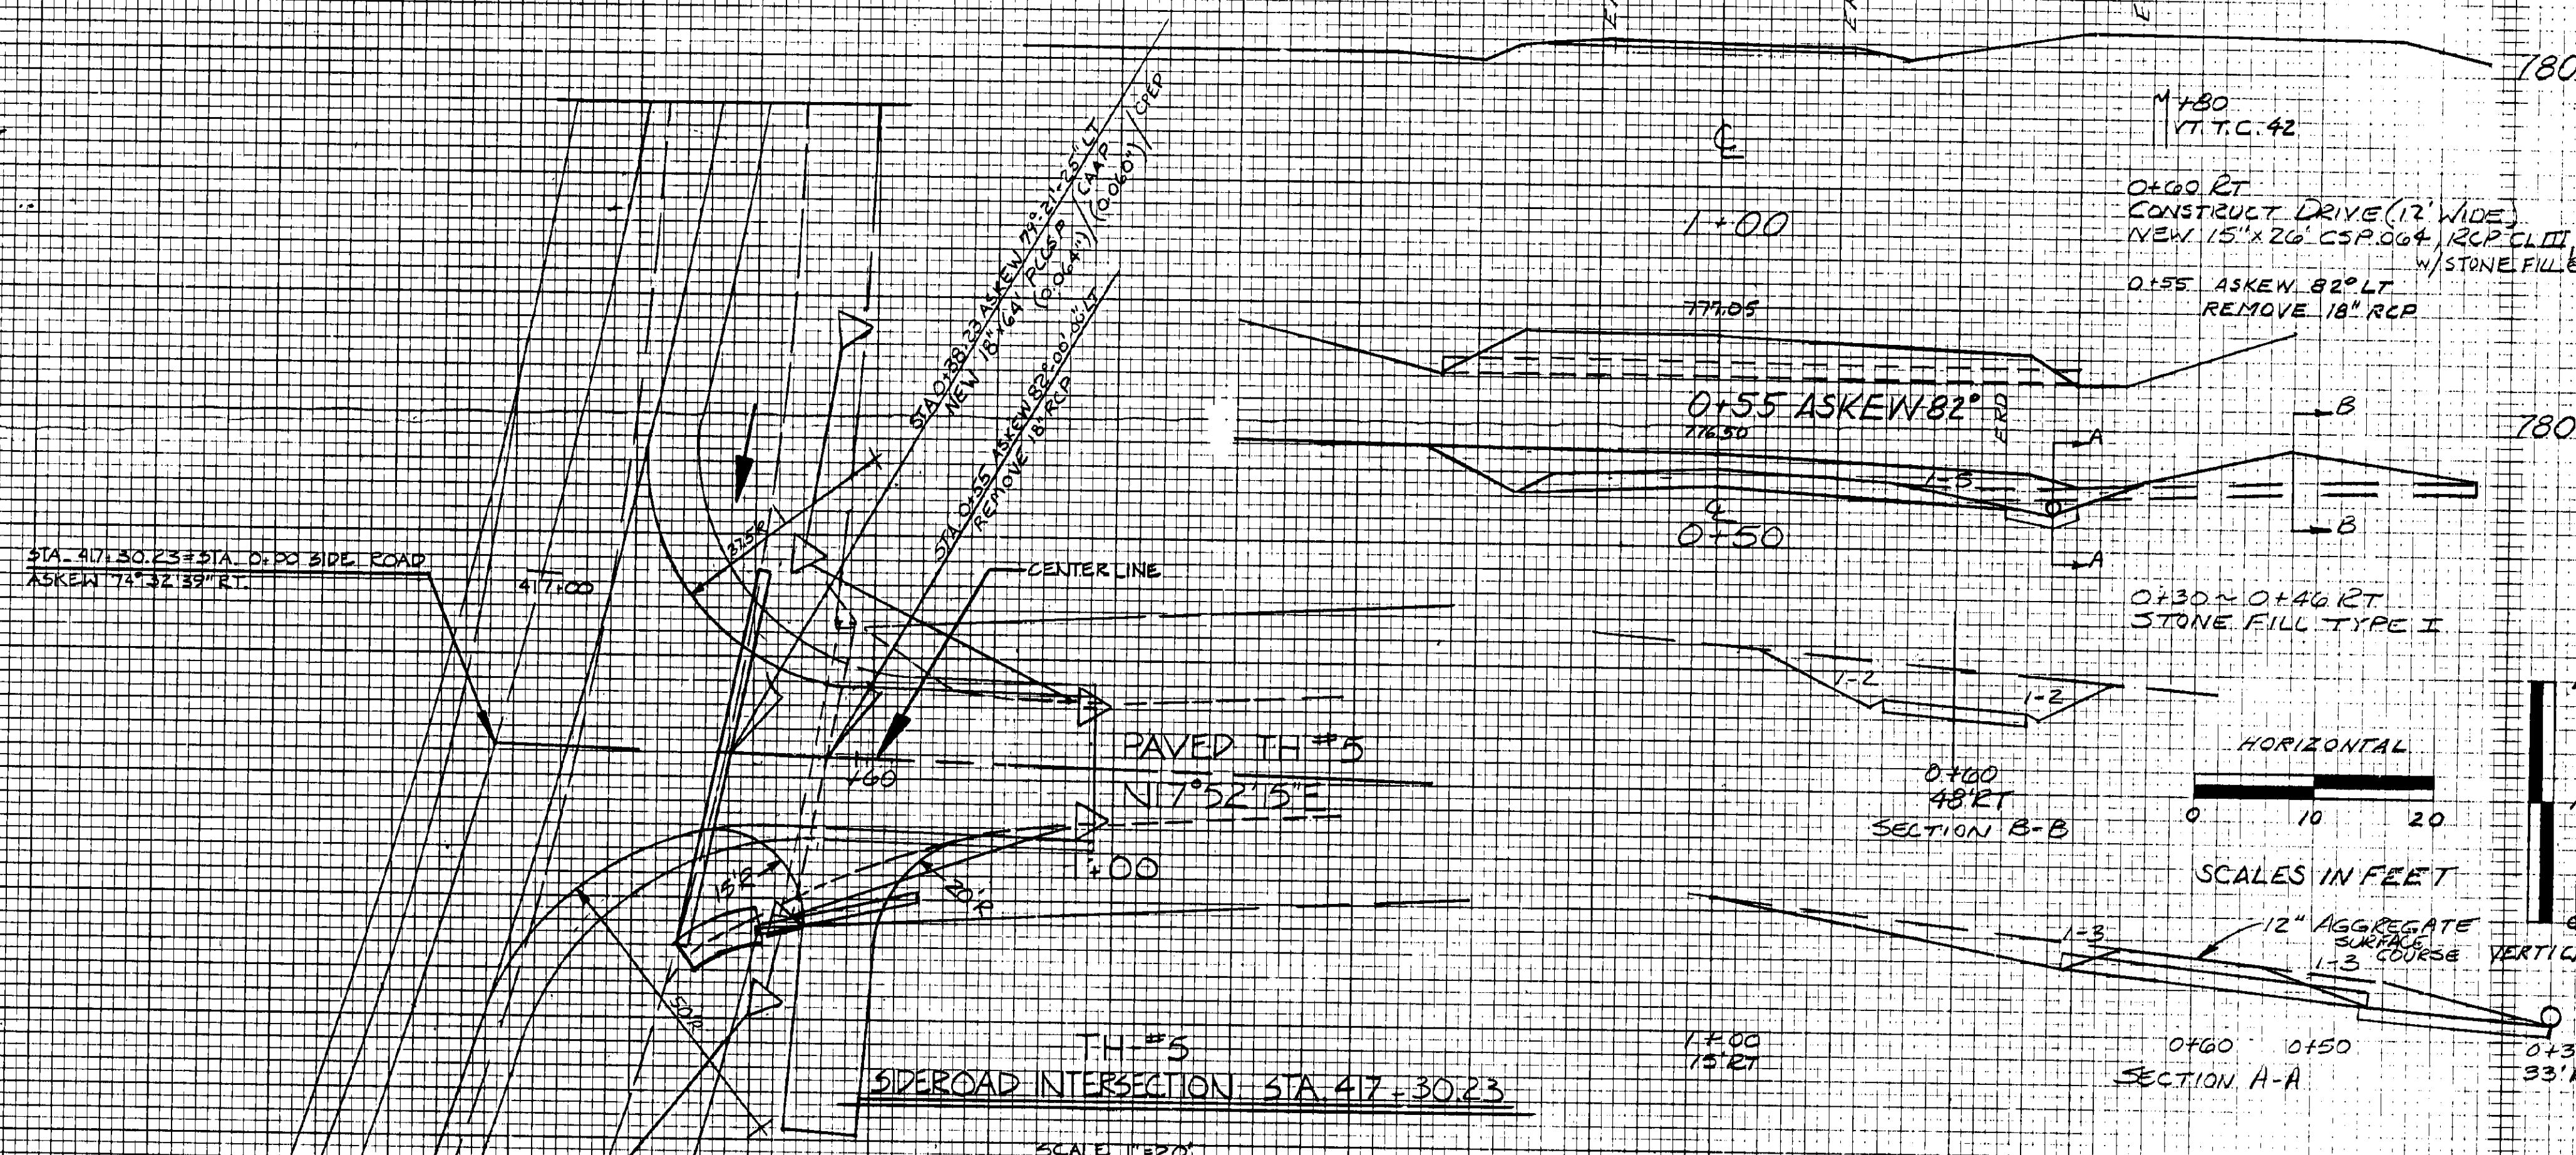

SIDEROAD SECTIONS TH#5 AT STA 417+30.23 GROTON-RYEGATE 2026-1(30) SHEET 152 OF 152