



1.65
100% 1.52

2.610 @ 40+50

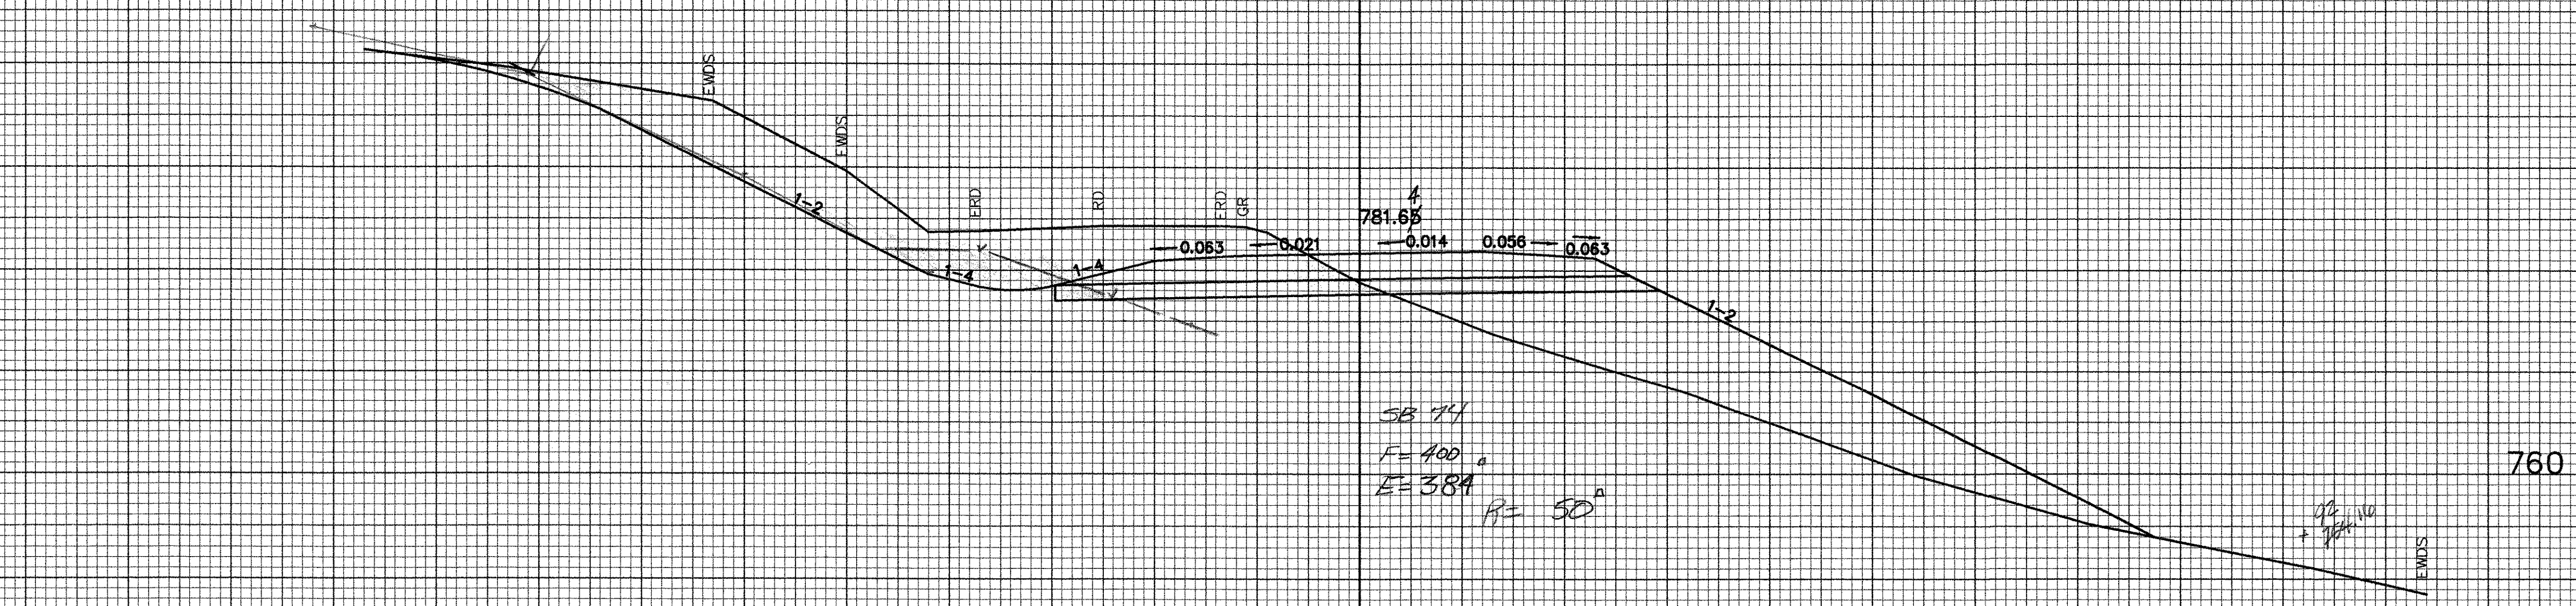

440+00

2.30
100% 1.52

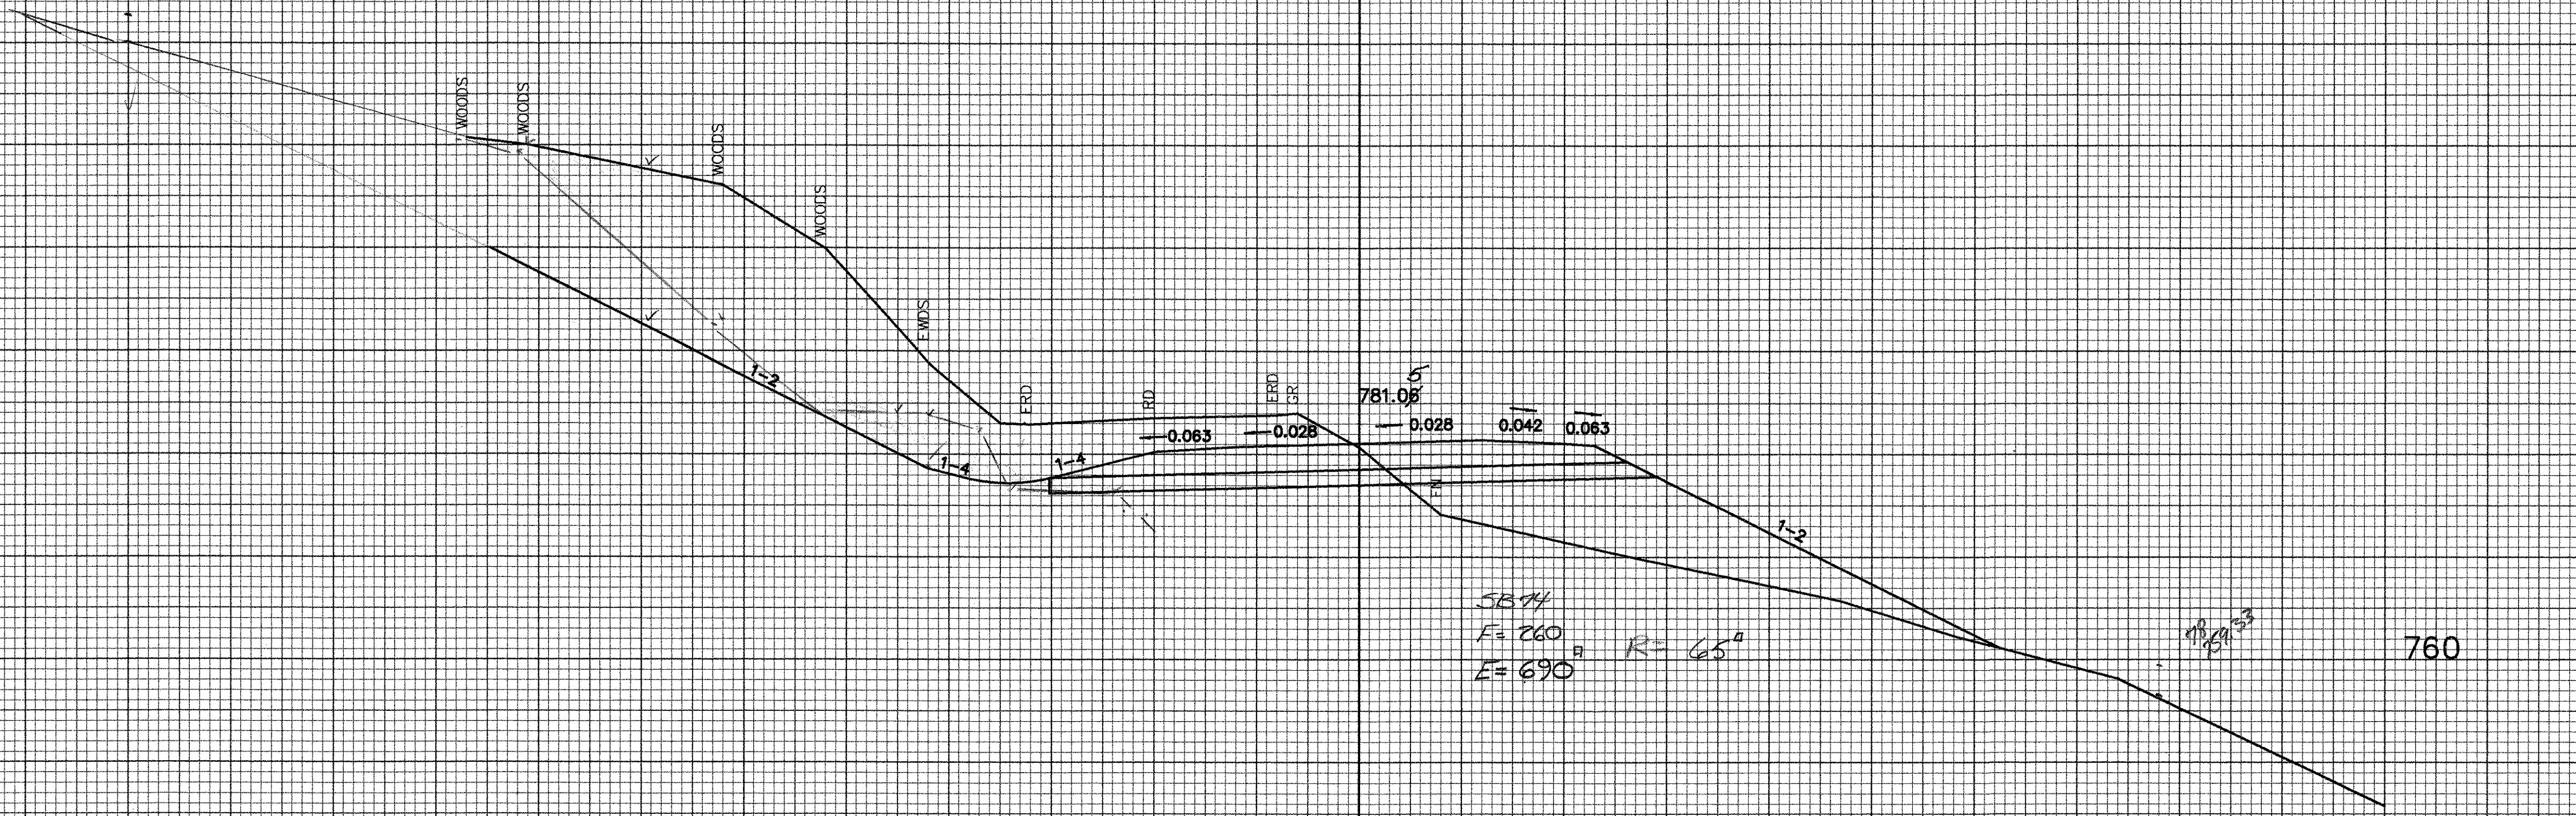

439+50

17 88 P40

FROM STA. 439+50 TO STA. 440+00
 PROJECT NAME GROTON-RYEGATE
 NO. F 026-1(30) PLOTTED 09/30/97
 SURVEYED BY VSE SEP 1997
 SHEET 169 OF SHEETS

SCALE 1" = 10 FEET