




CRP

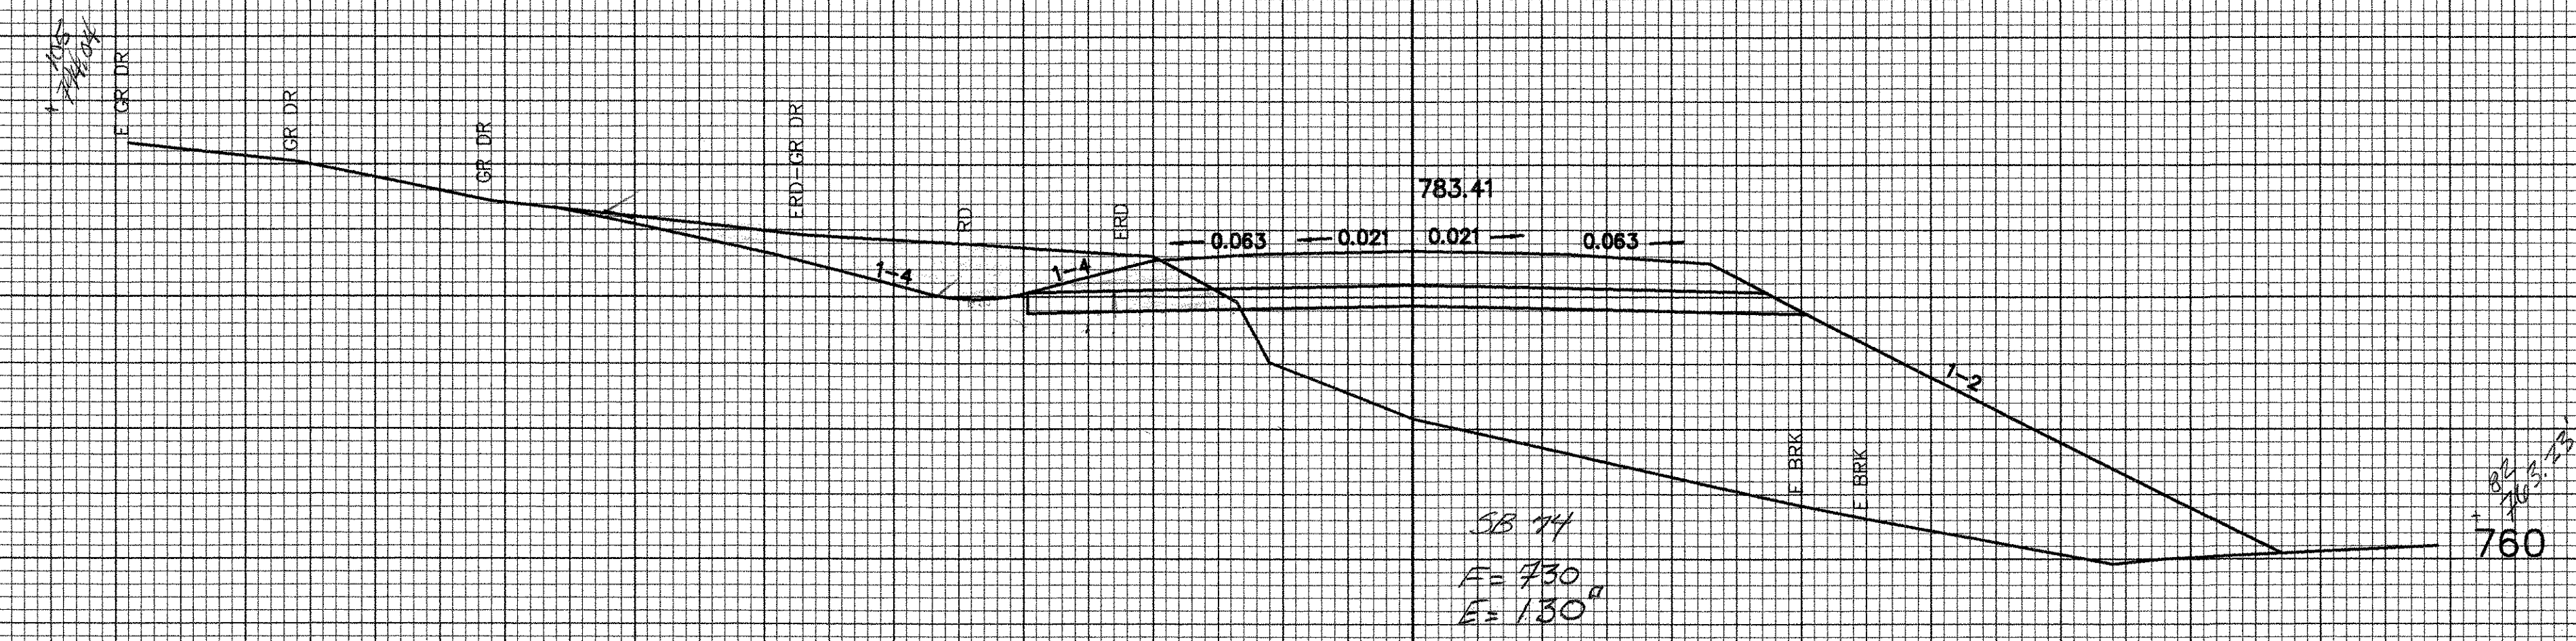

441+50/41		BE 2 PG 65	Station
76 (5')	4x4x8x1.5x1/2"		23'
76 (0-5')	4x5x8x1/2"		59'
76 (5')	PIPE 32" x 4.1 x 16.7		48'
76 (5')	PIPE 12" x 4.1 x 15.1		34'
76	Under SF 10x12x8x1/2"		89'
76	Removal SEE SHEET 146		42'
76	Block (Removal) SEE SHEET 145		60'
			119'-60" = 59'
Greater Under St. 12" x 12" x 16"			25'
Re Steel 12" x 12"			12'
CONC CLB			10'
			2-14-95

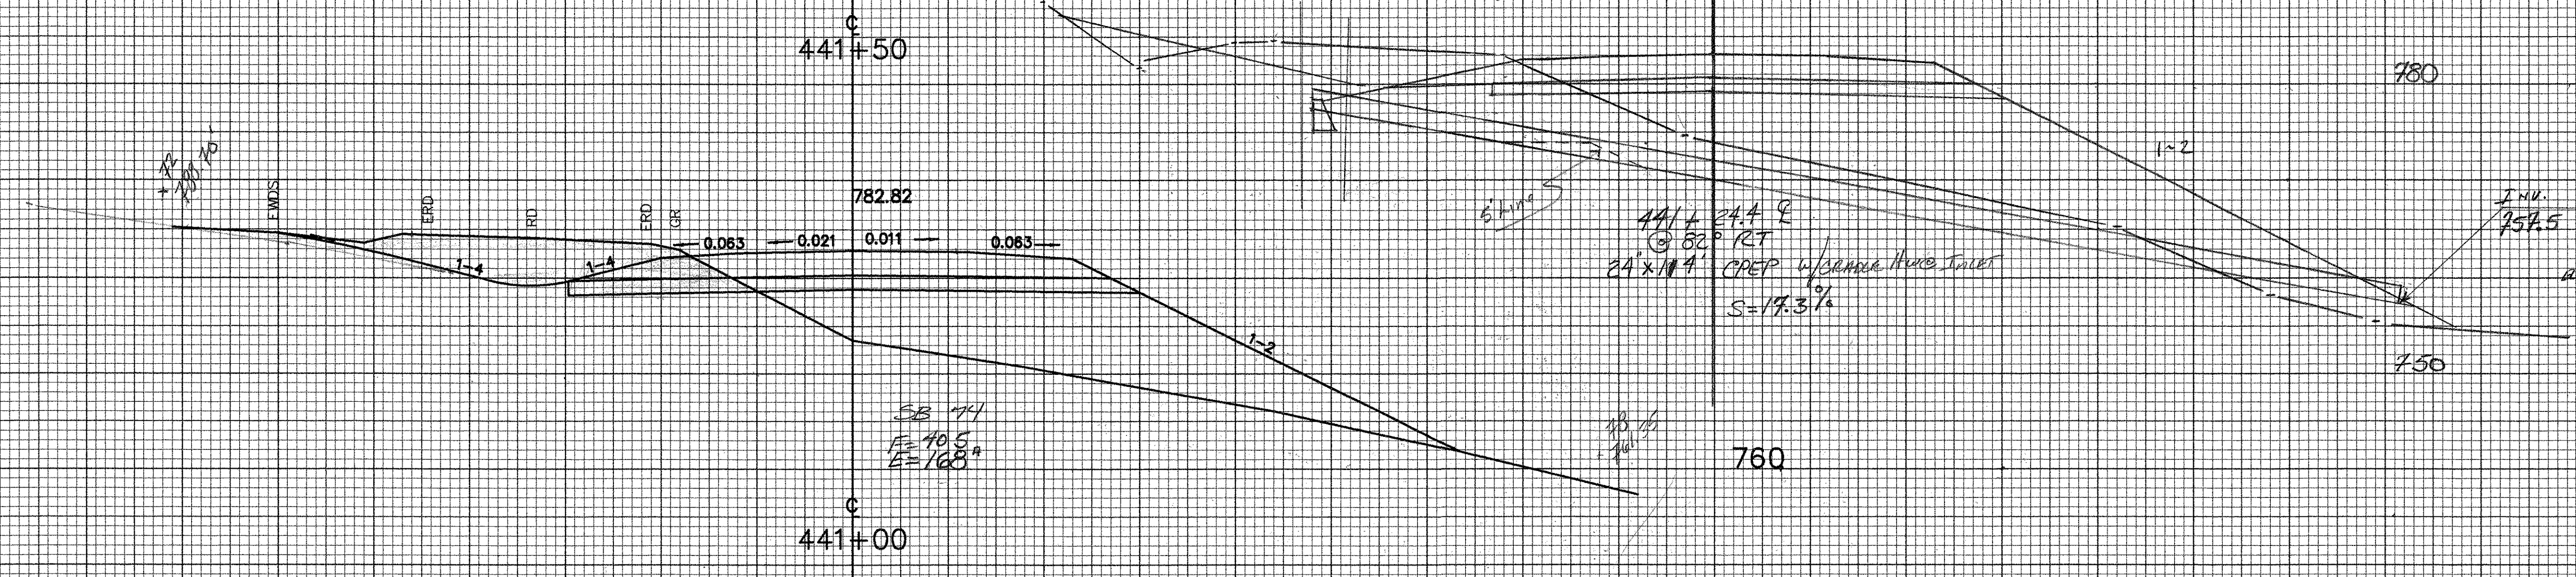

441+24.4
 @ 82° RT
 24" x 11" 4" CRIP w/BRACK HUBS SLOTT
 S=17.3%

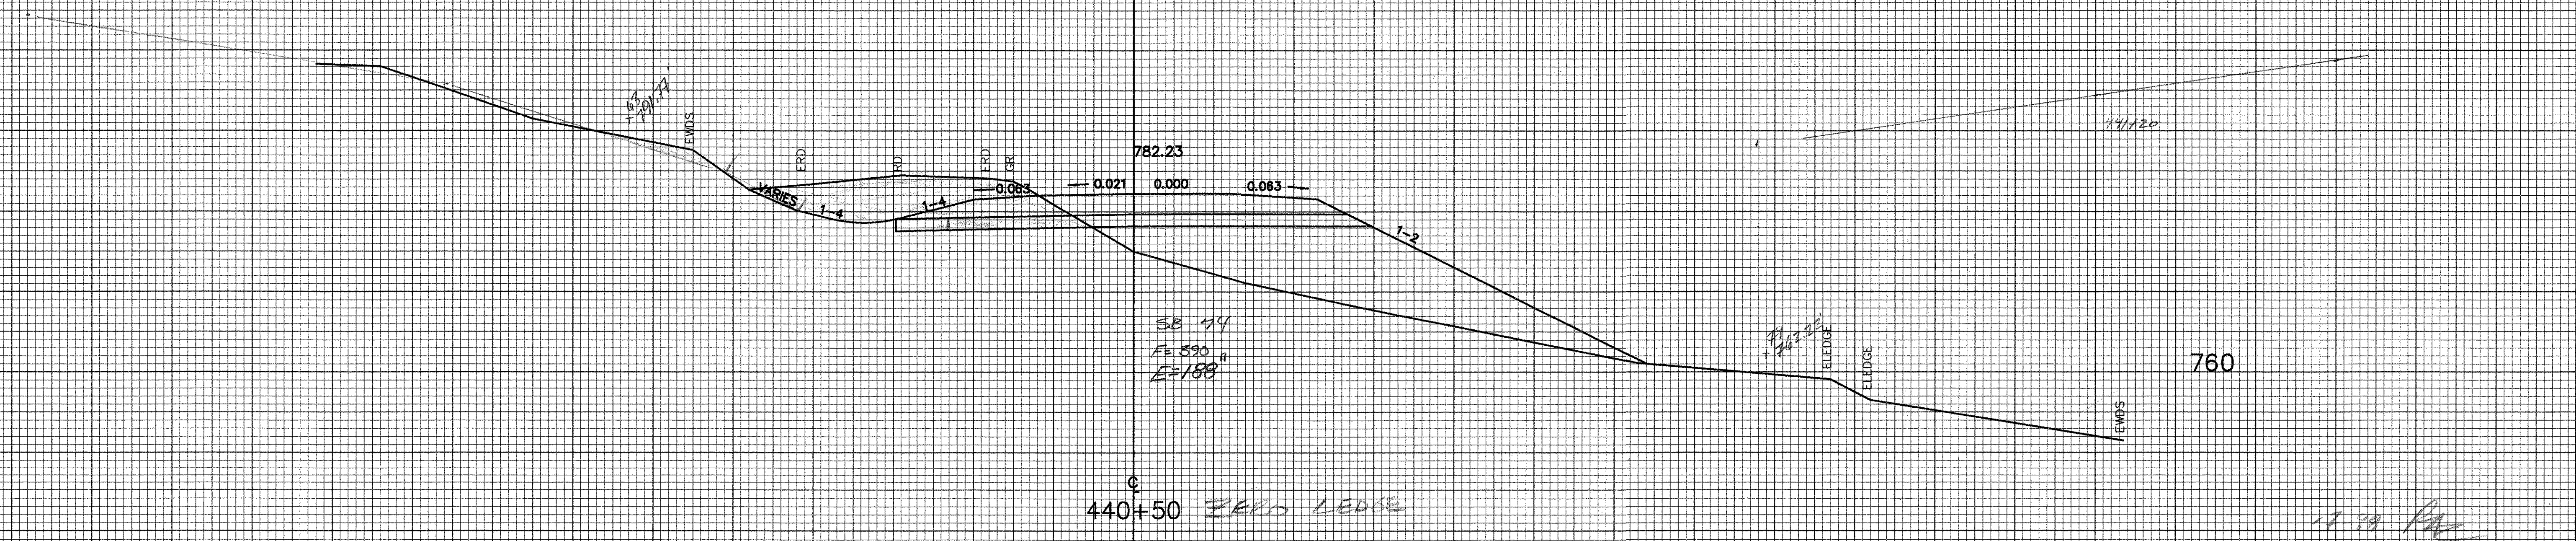

440+50 ZERO LEDGE

SCALE 1" = 10 FEET