


780

445+00

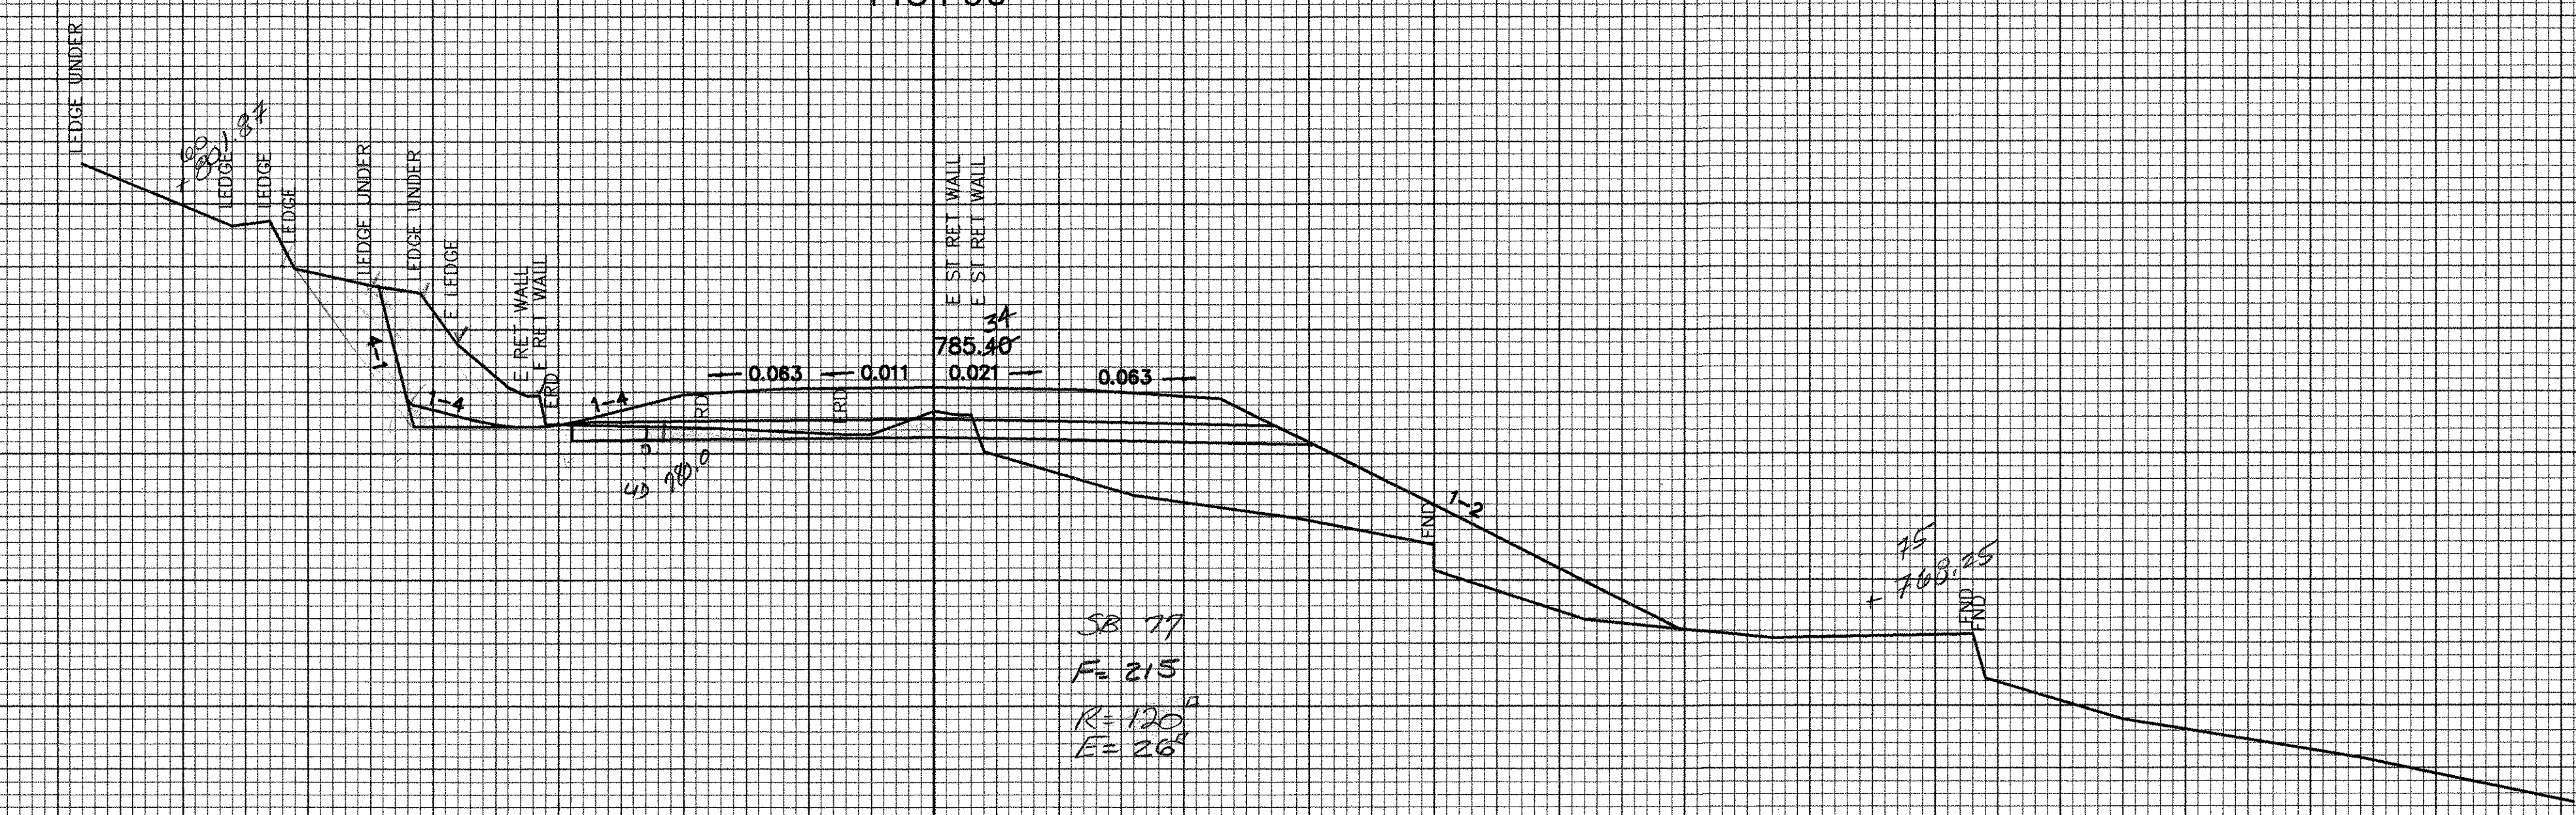

780

444+50

1-1-98

FROM STA. 444+50 TO STA. 445+00
 PROJECT NAME GROTON--RYEGATE
 NO. F 026-1(30) PLOTTED 09/30/97
 SURVEYED BY VSE SEP 1997
 SHEET 163 OF SHEETS

SCALE 1" = 10 FEET