



800

780

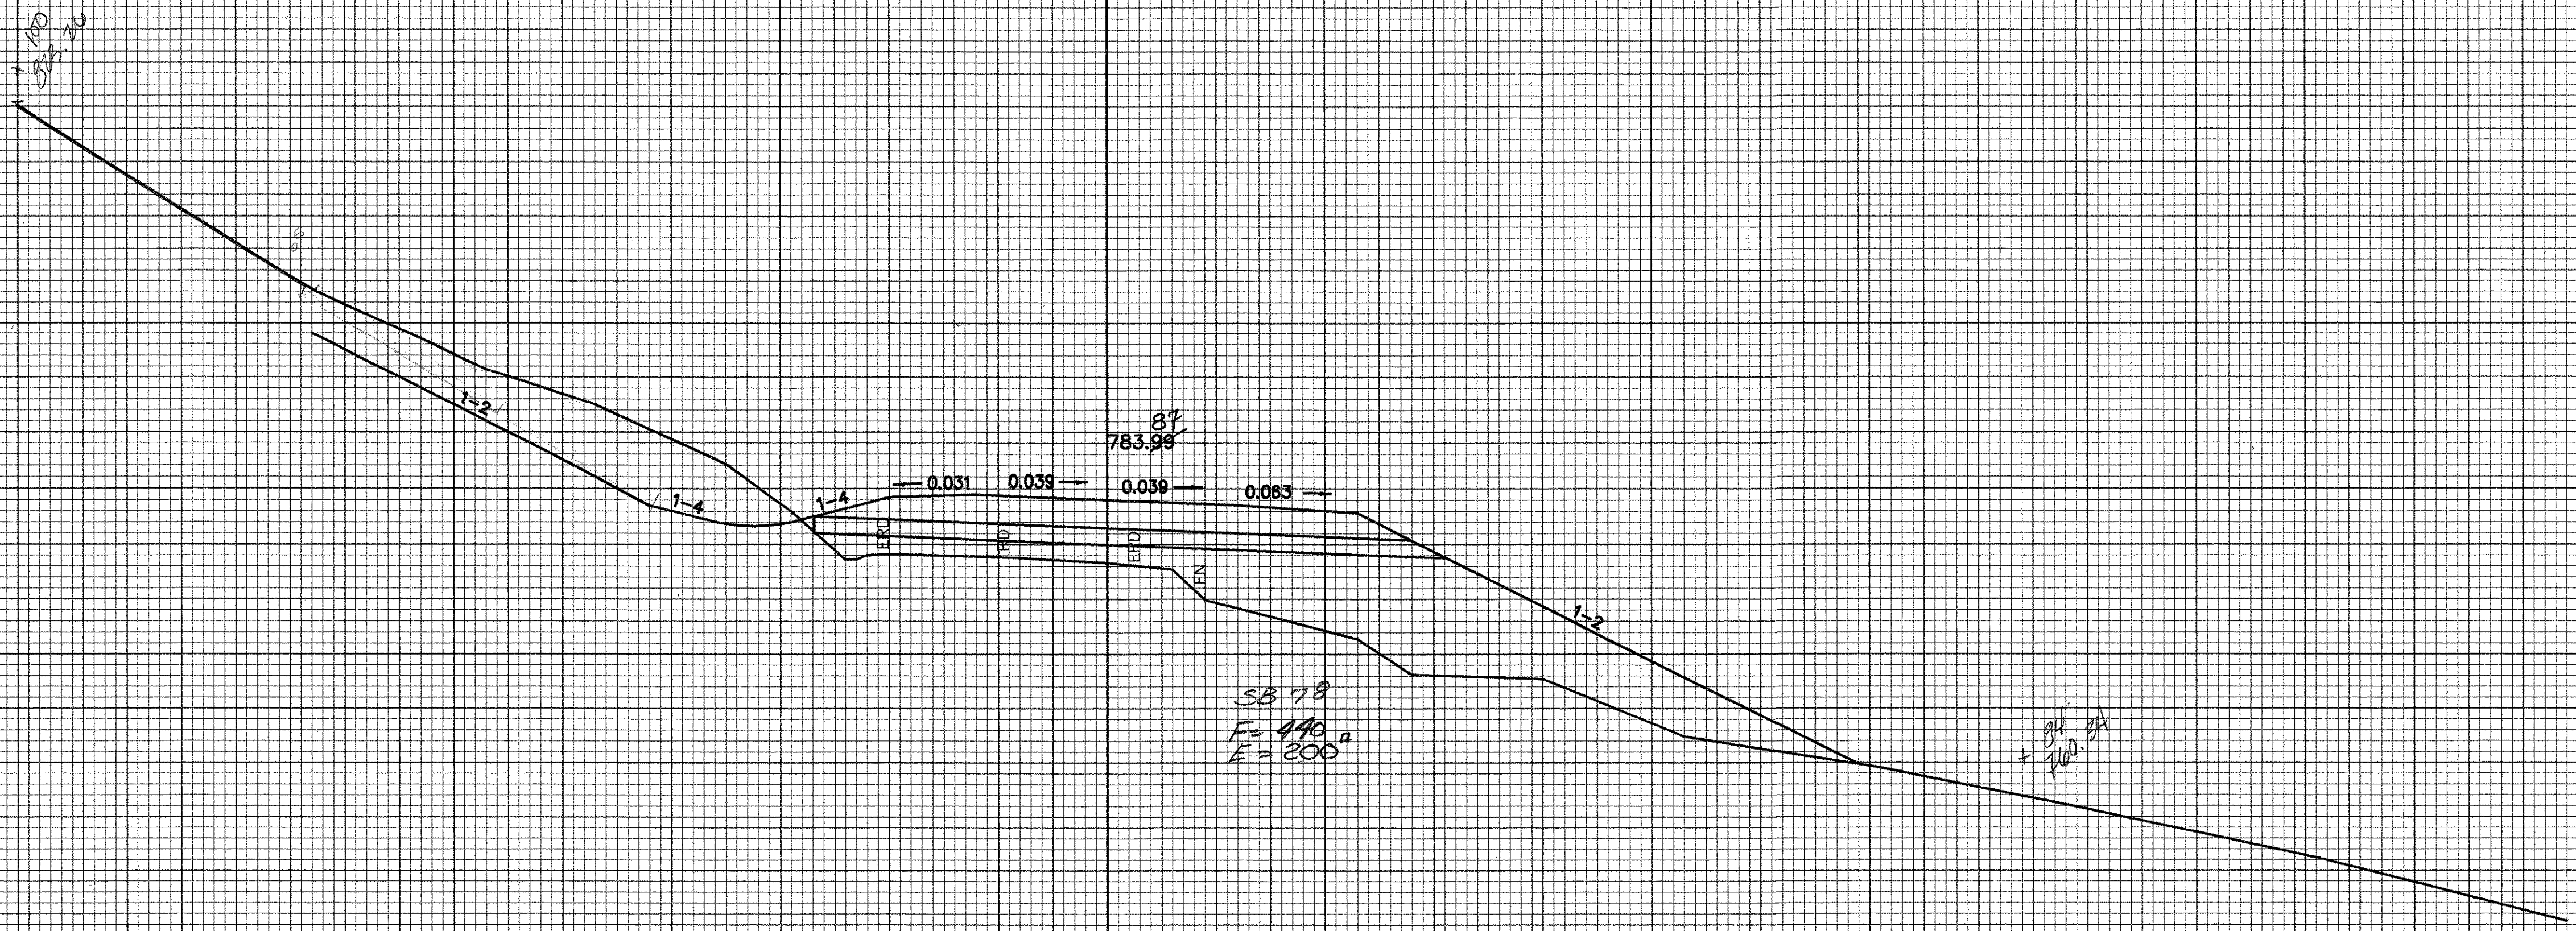

446+00

780

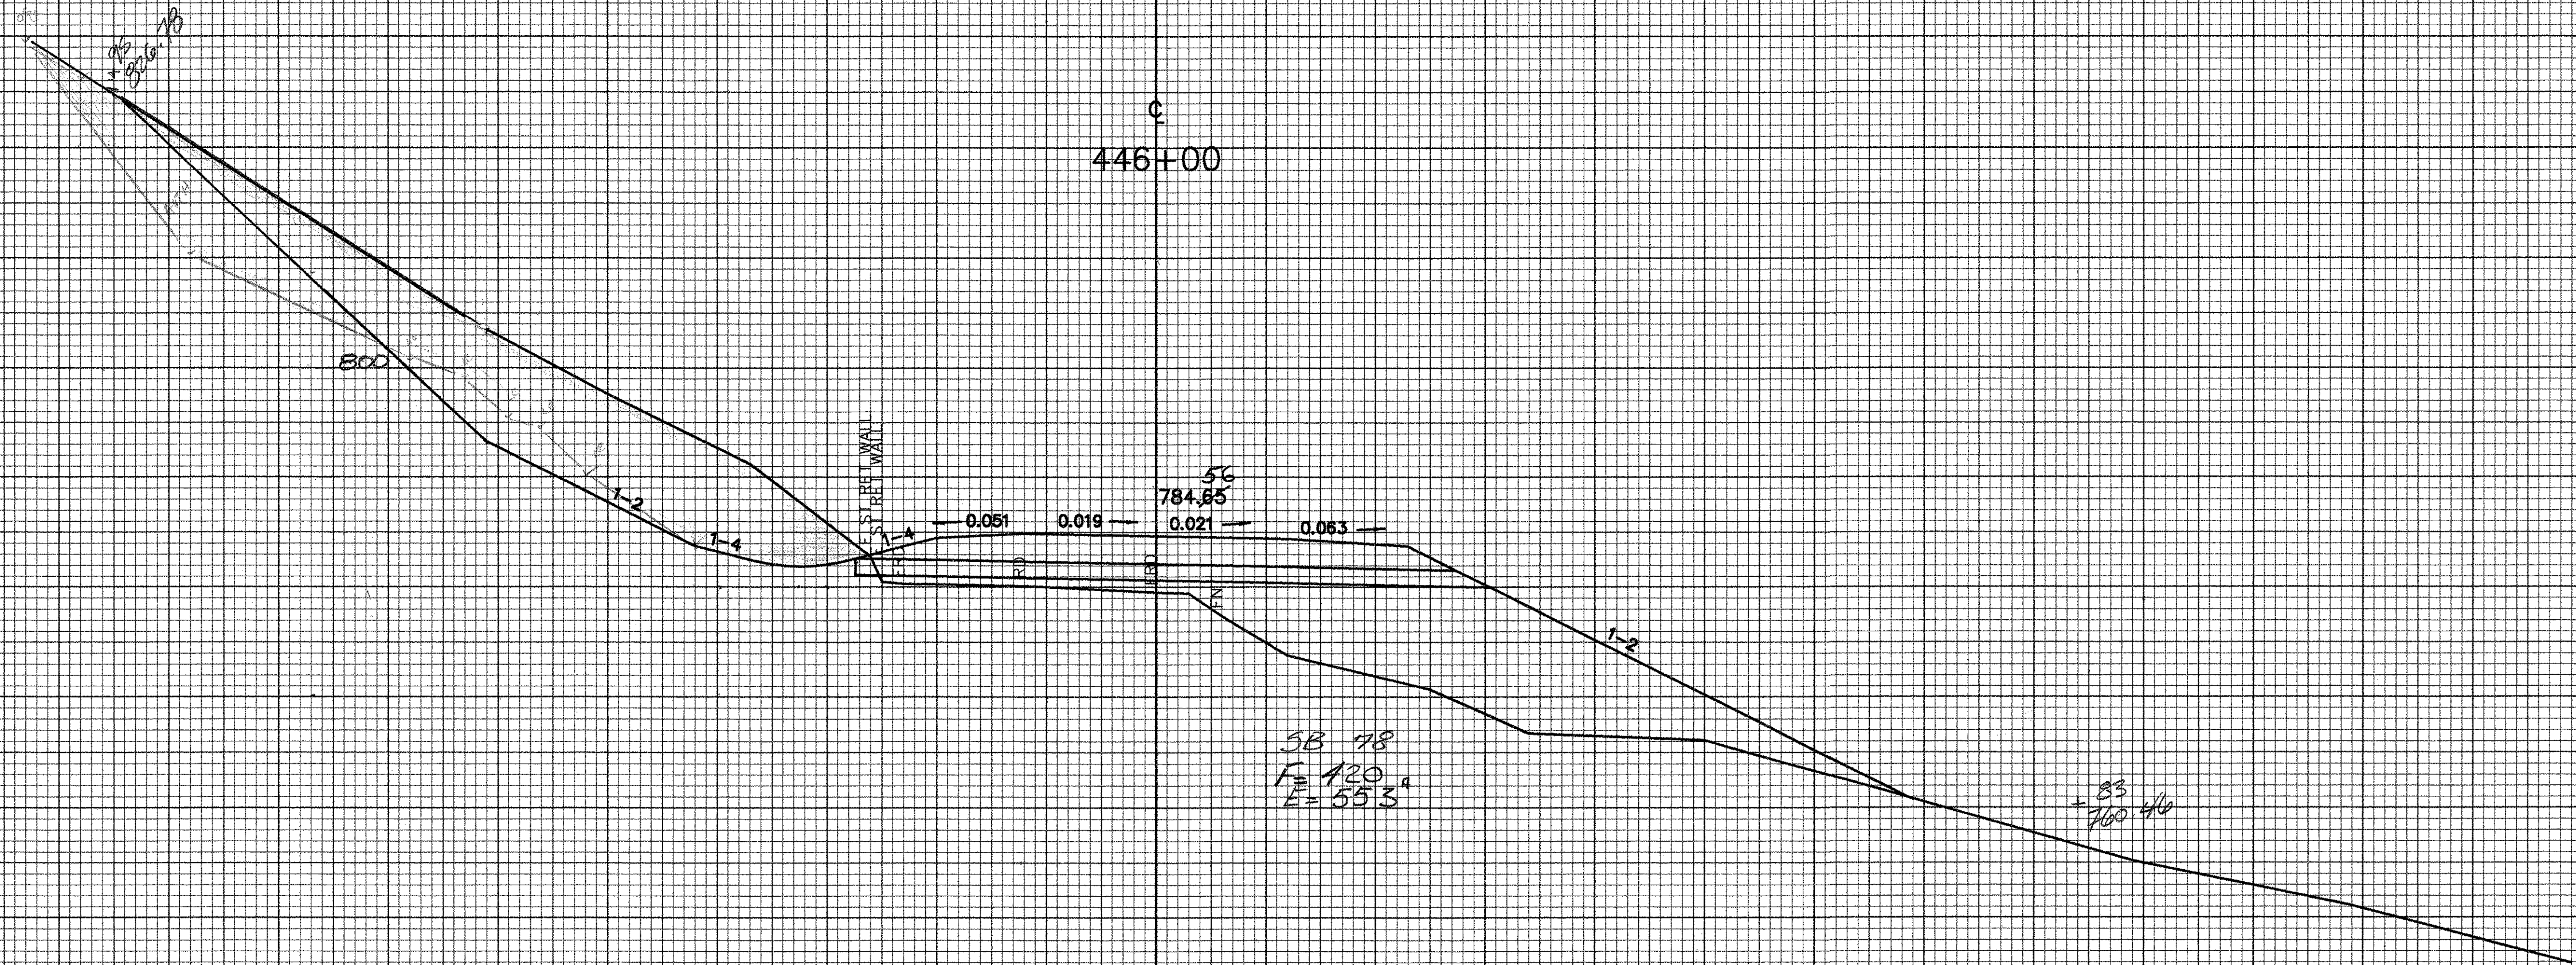

445+50

83  
780.46

190 R12

FROM STA. 445+50 TO STA. 446+00  
 PROJECT NAME GROTON-RYEGATE  
 NO. F 026-1(30) PLOTTED 09/30/97  
 SURVEYED BY VSE SEP 1997  
 SHEET 169 OF SHEETS

SCALE: 1" = 10 FEET