


FINAL SURVEY
 DATE
 BY
 QUANTITY
 SURVEY
 PLOTTED
 TEMPLATE
 NOTE BOOK
 NO.
 AREAS CHECKED

ORIGINAL SURVEY
 DATE
 BY
 QUANTITY
 SURVEY
 PLOTTED
 TEMPLATE
 NOTE BOOK
 NO.
 AREAS CHECKED

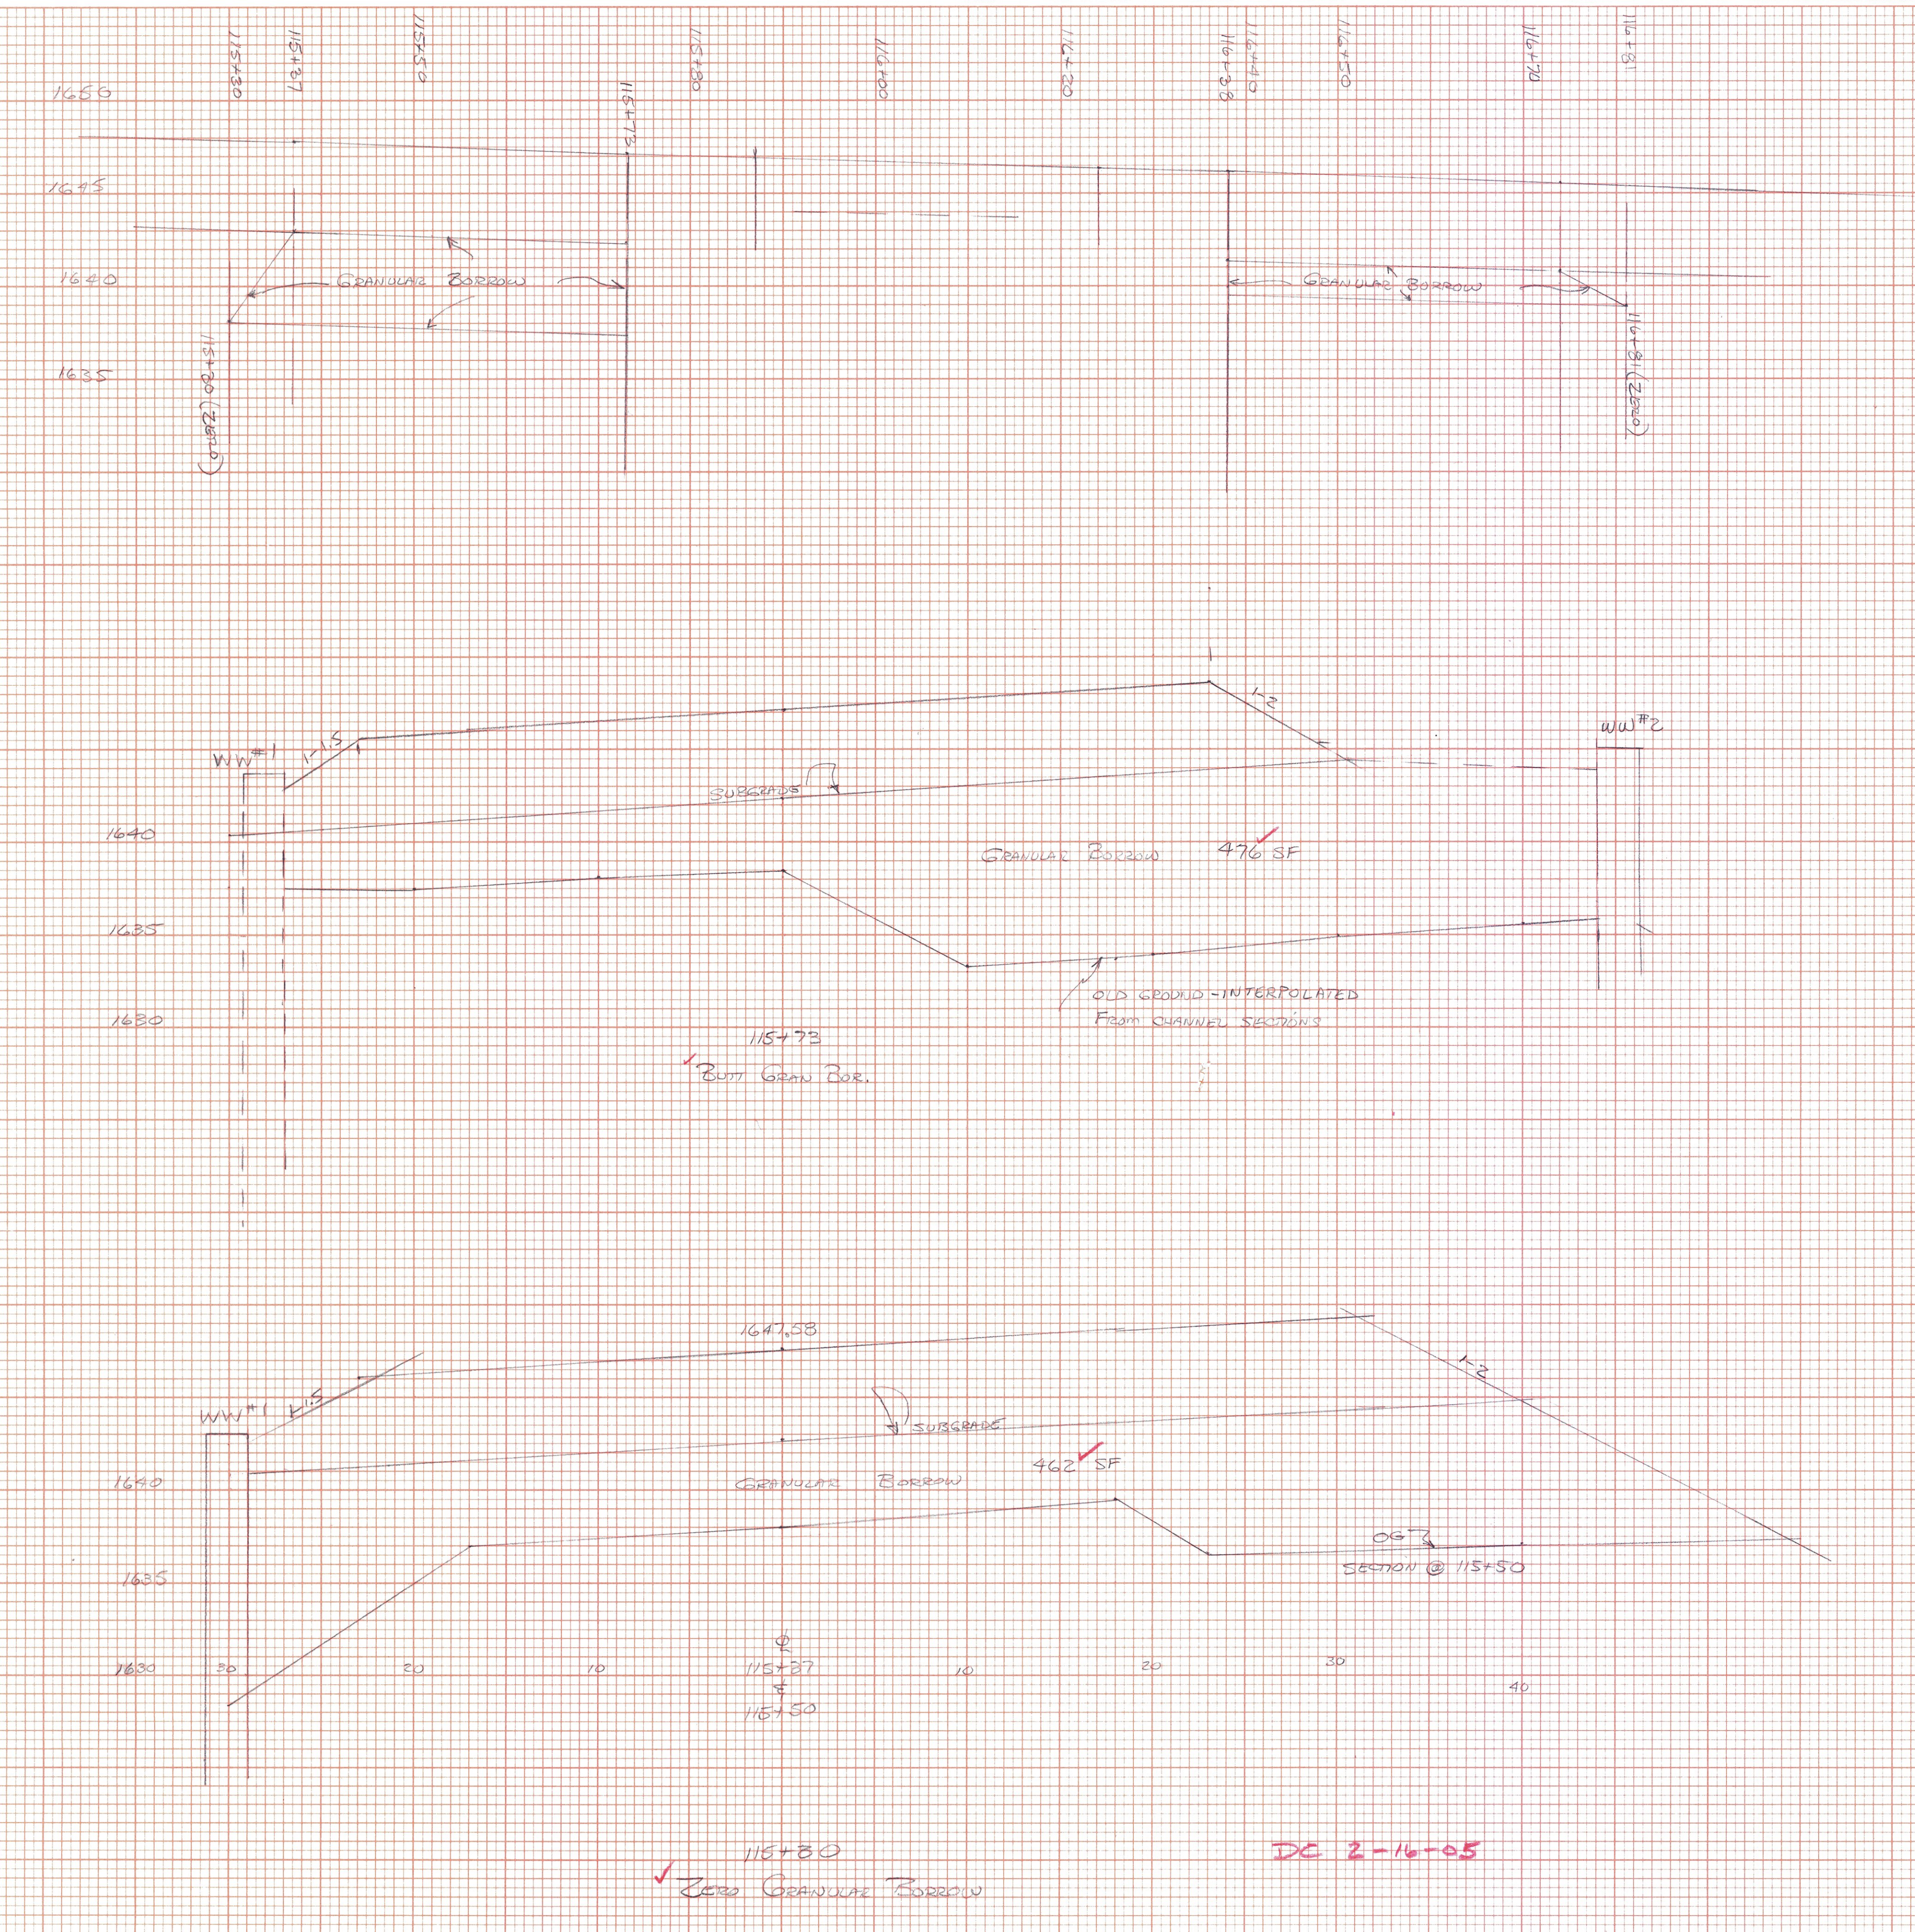

Item 203.32 - GRANULAR BORROW SUMMARY
 (APPROACH BRIDGE)

Sta	Dist	Area	CY
(Zero) 115+30	7	0	60
115+37	13	462	222
115+50	23	462	400
(Butt) 115+73		476	
			<u>682 CY</u>

(EXIT BRIDGE)

Sta	Dist	Area	CY
(Butt) 116+33	12	393	134
116+50	20	243	197
116+70	11	288	59
(Zero) 116+81		0	
			<u>395 CY</u>

TOTAL GRAN BORROW - BR 24 = 1077 CY

BOOK - PAGE 131

115+30
 ✓ ZERO GRANULAR BORROW

DC 2-16-05