
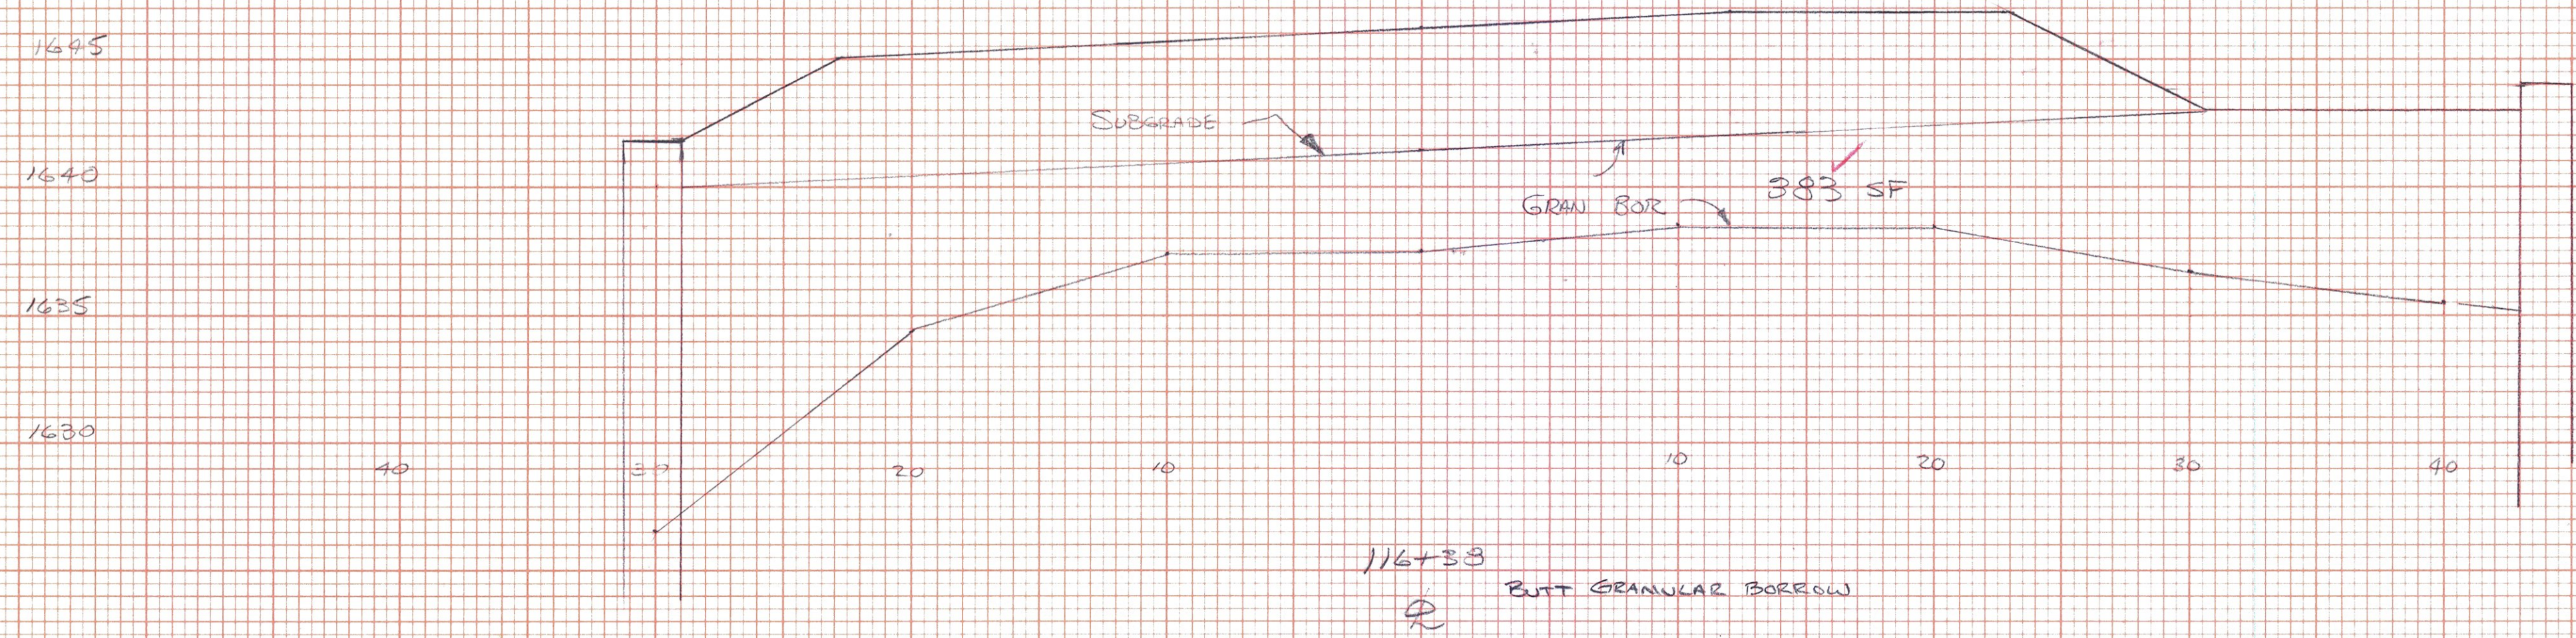


SEARSBURG - WILMINGTON  
 NHP - 010-1(18)  
 BRIDGE #24 APPROACHES  
 ITEM 203.32 - GRANULAR BORROW  
 SHEET 2 OF

FINAL SURVEY BY DATE  
 SURVEYED BY DATE  
 PLOTTED BY DATE  
 NOTE BOOK NO. AREA CHECKED

ORIGINAL SURVEY BY DATE  
 SURVEYED BY DATE  
 PLOTTED BY DATE  
 NOTE BOOK NO. AREA CHECKED

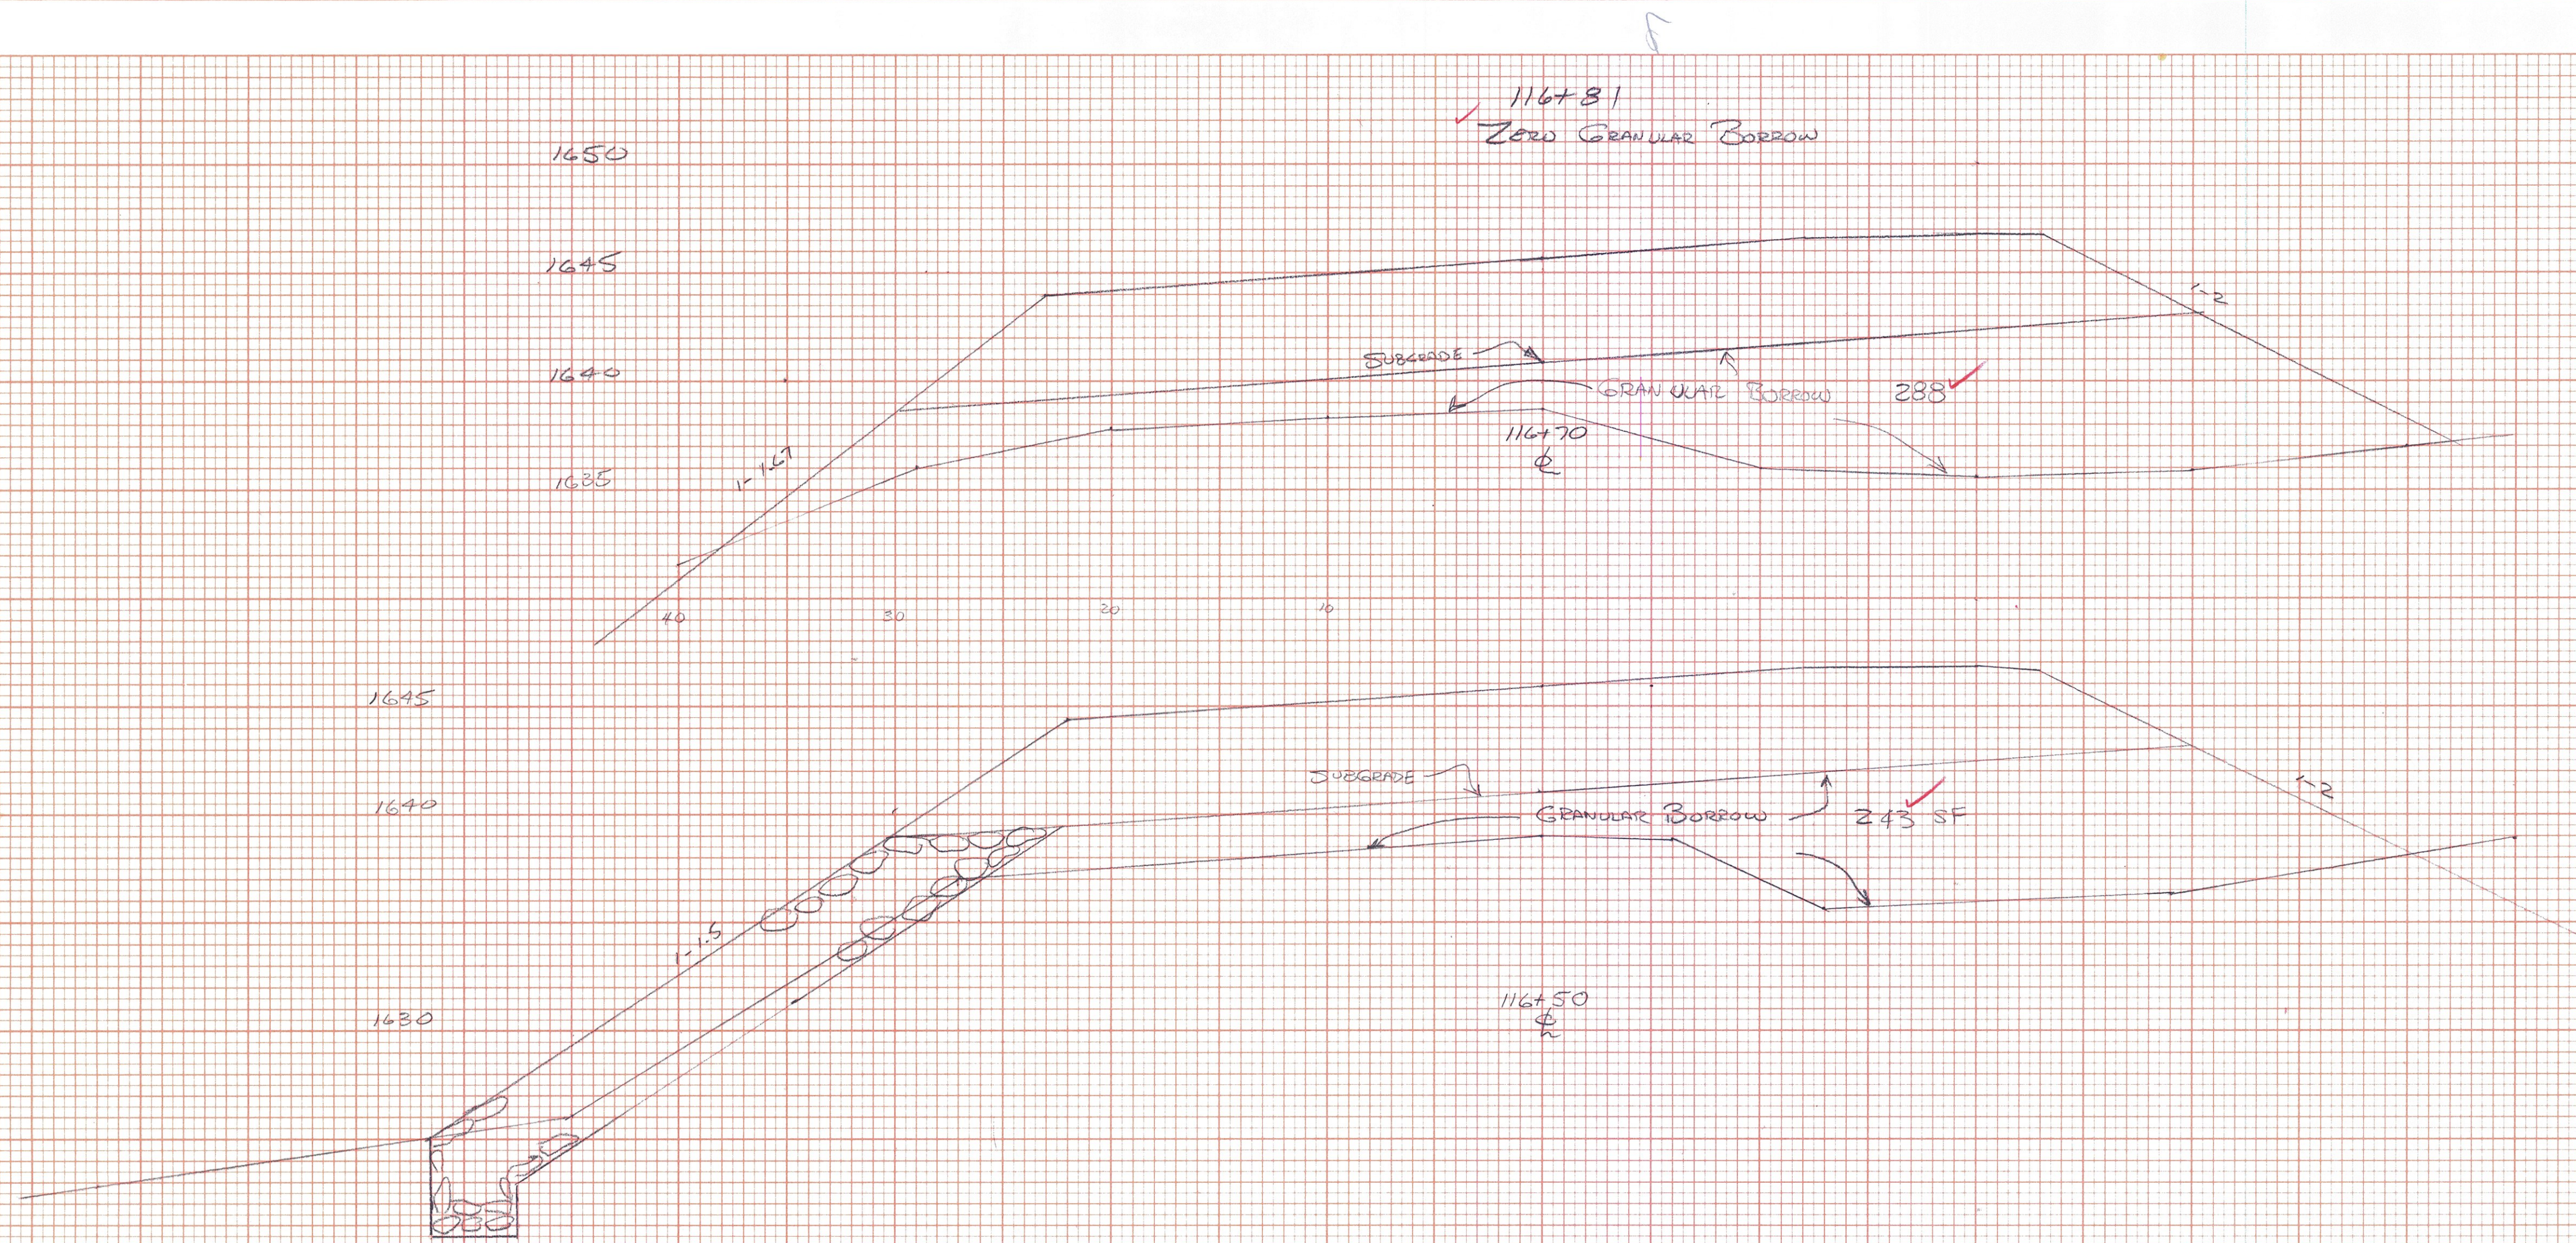

DC 2-16-05